EVANS & MECHWART

CIVIL ENGINEERS — SURVEYORS
GAHANNA, OHIO

0-73

ACREAGE TRACTS, SEC. 2, TP. 2, R 16, U.S. M. LANDS, PLAIN TWP., FRANKLIN CO., O. DATE OCT. 1954

o = IRON PIN. • = R.R. SPIKE.

SCALE 1" = 1" = 200'

DEED BOOK 1283, PAGE 241

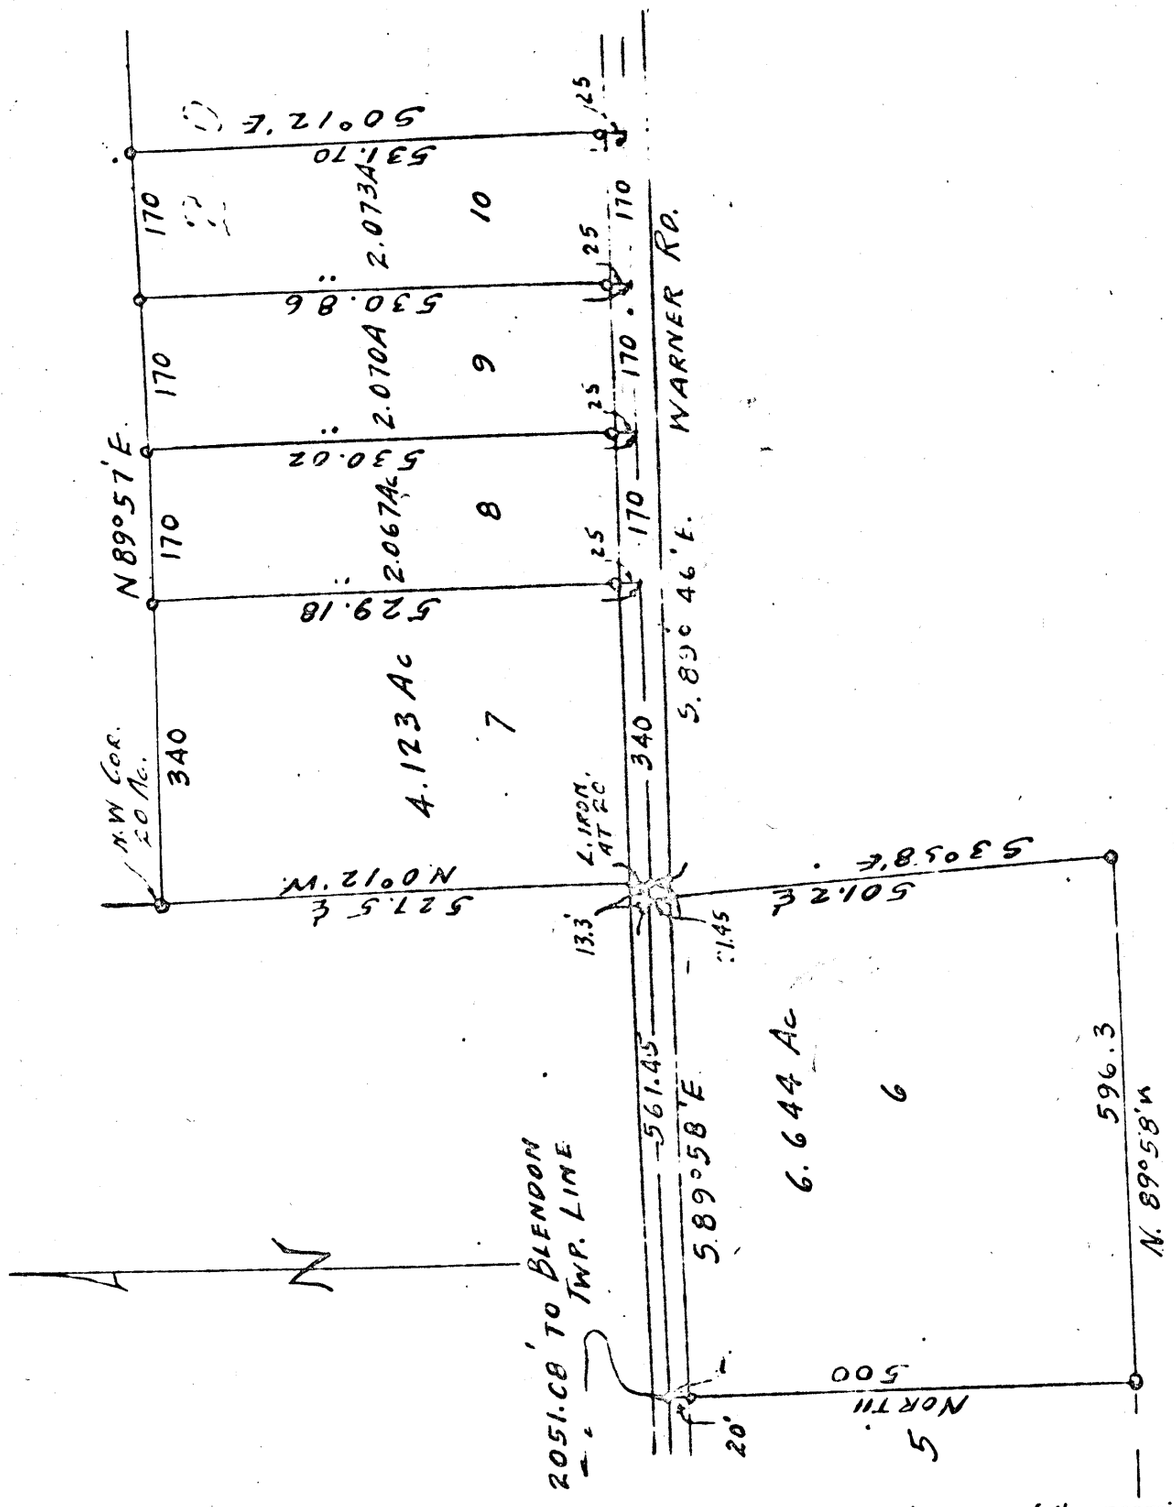

We hereby certify that the foregoing plat was prepared from an actual survey of the premises and shows the location of the boundaries.

EVANS & MECHWART

BY

4690 120 057 005 W WARNER ROAD 0001 0737 003