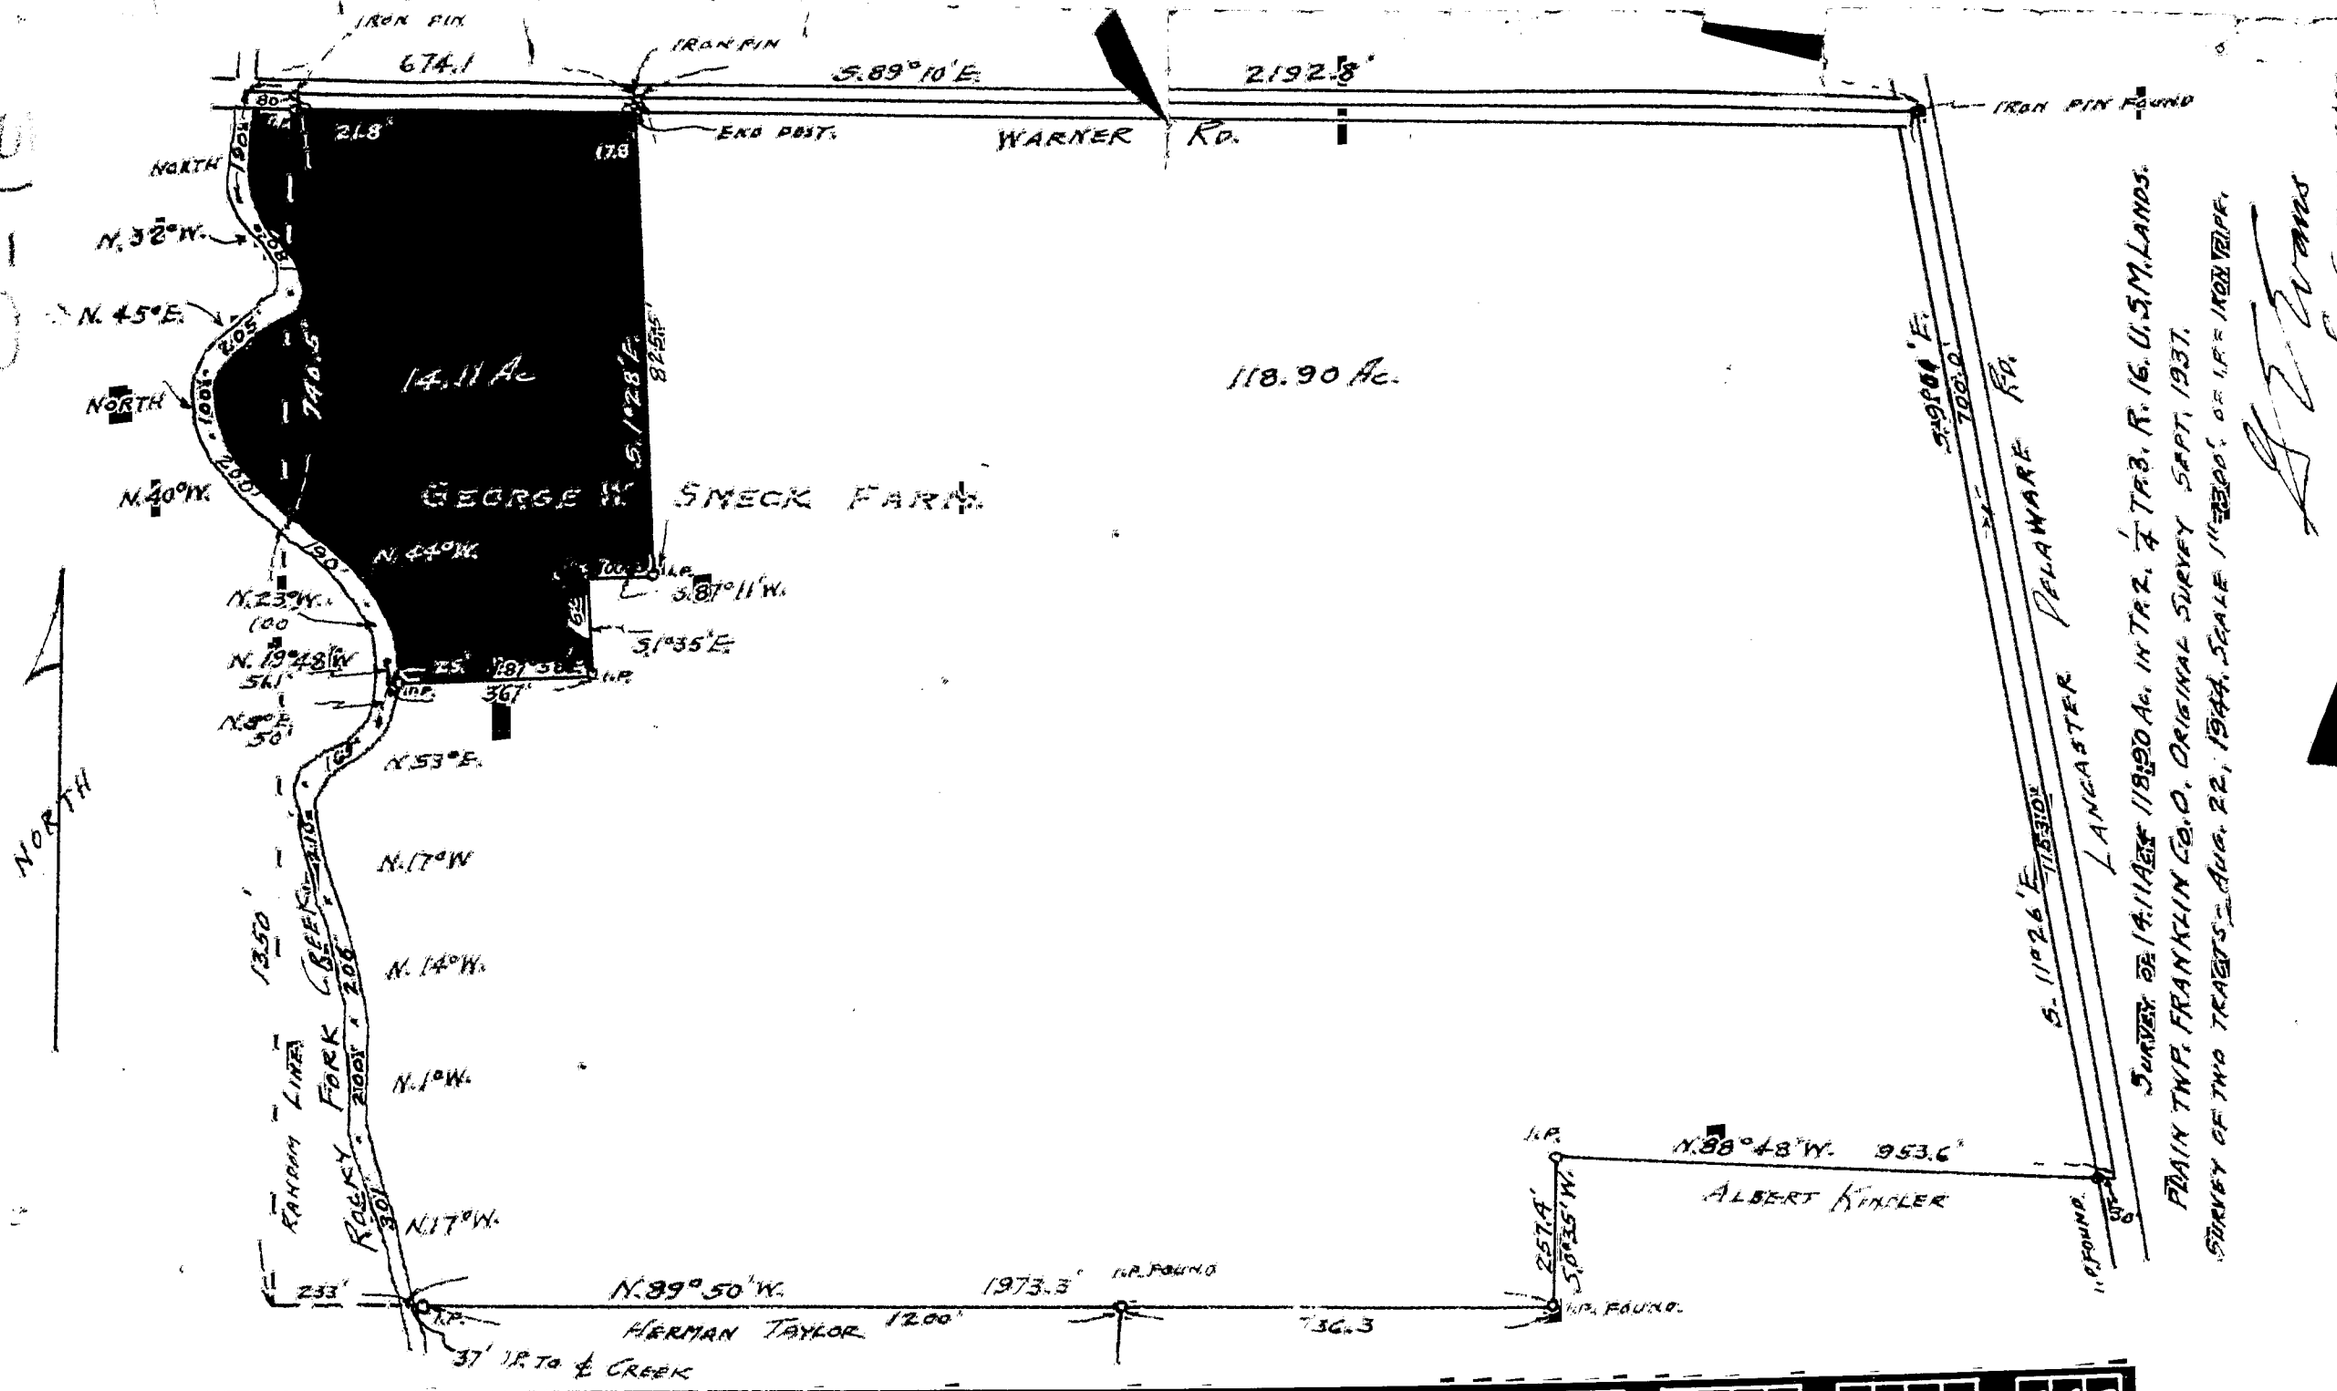

4690 120 078 061 S WARNER W ST RT 161 1945 0752 003