E.M.H.&T. INC.
CONSULTING ENGINEERS & SURVEYORS
GAHANNA, OHIO 43230

SURVEY OF ACREAGE PARCELS

LOCATED IN SECTIONS 1 & 10, TOWNSHIP 2, RANGE 16

UNITED STATES MILITARY LANDS

PLAIN TOWNSHIP, FRANKLIN COUNTY, OHIO

SCALE 1" = 40' NOVEMBER 10, 1988 RECORD REFERENCES D.B. 2765, Pg. 71

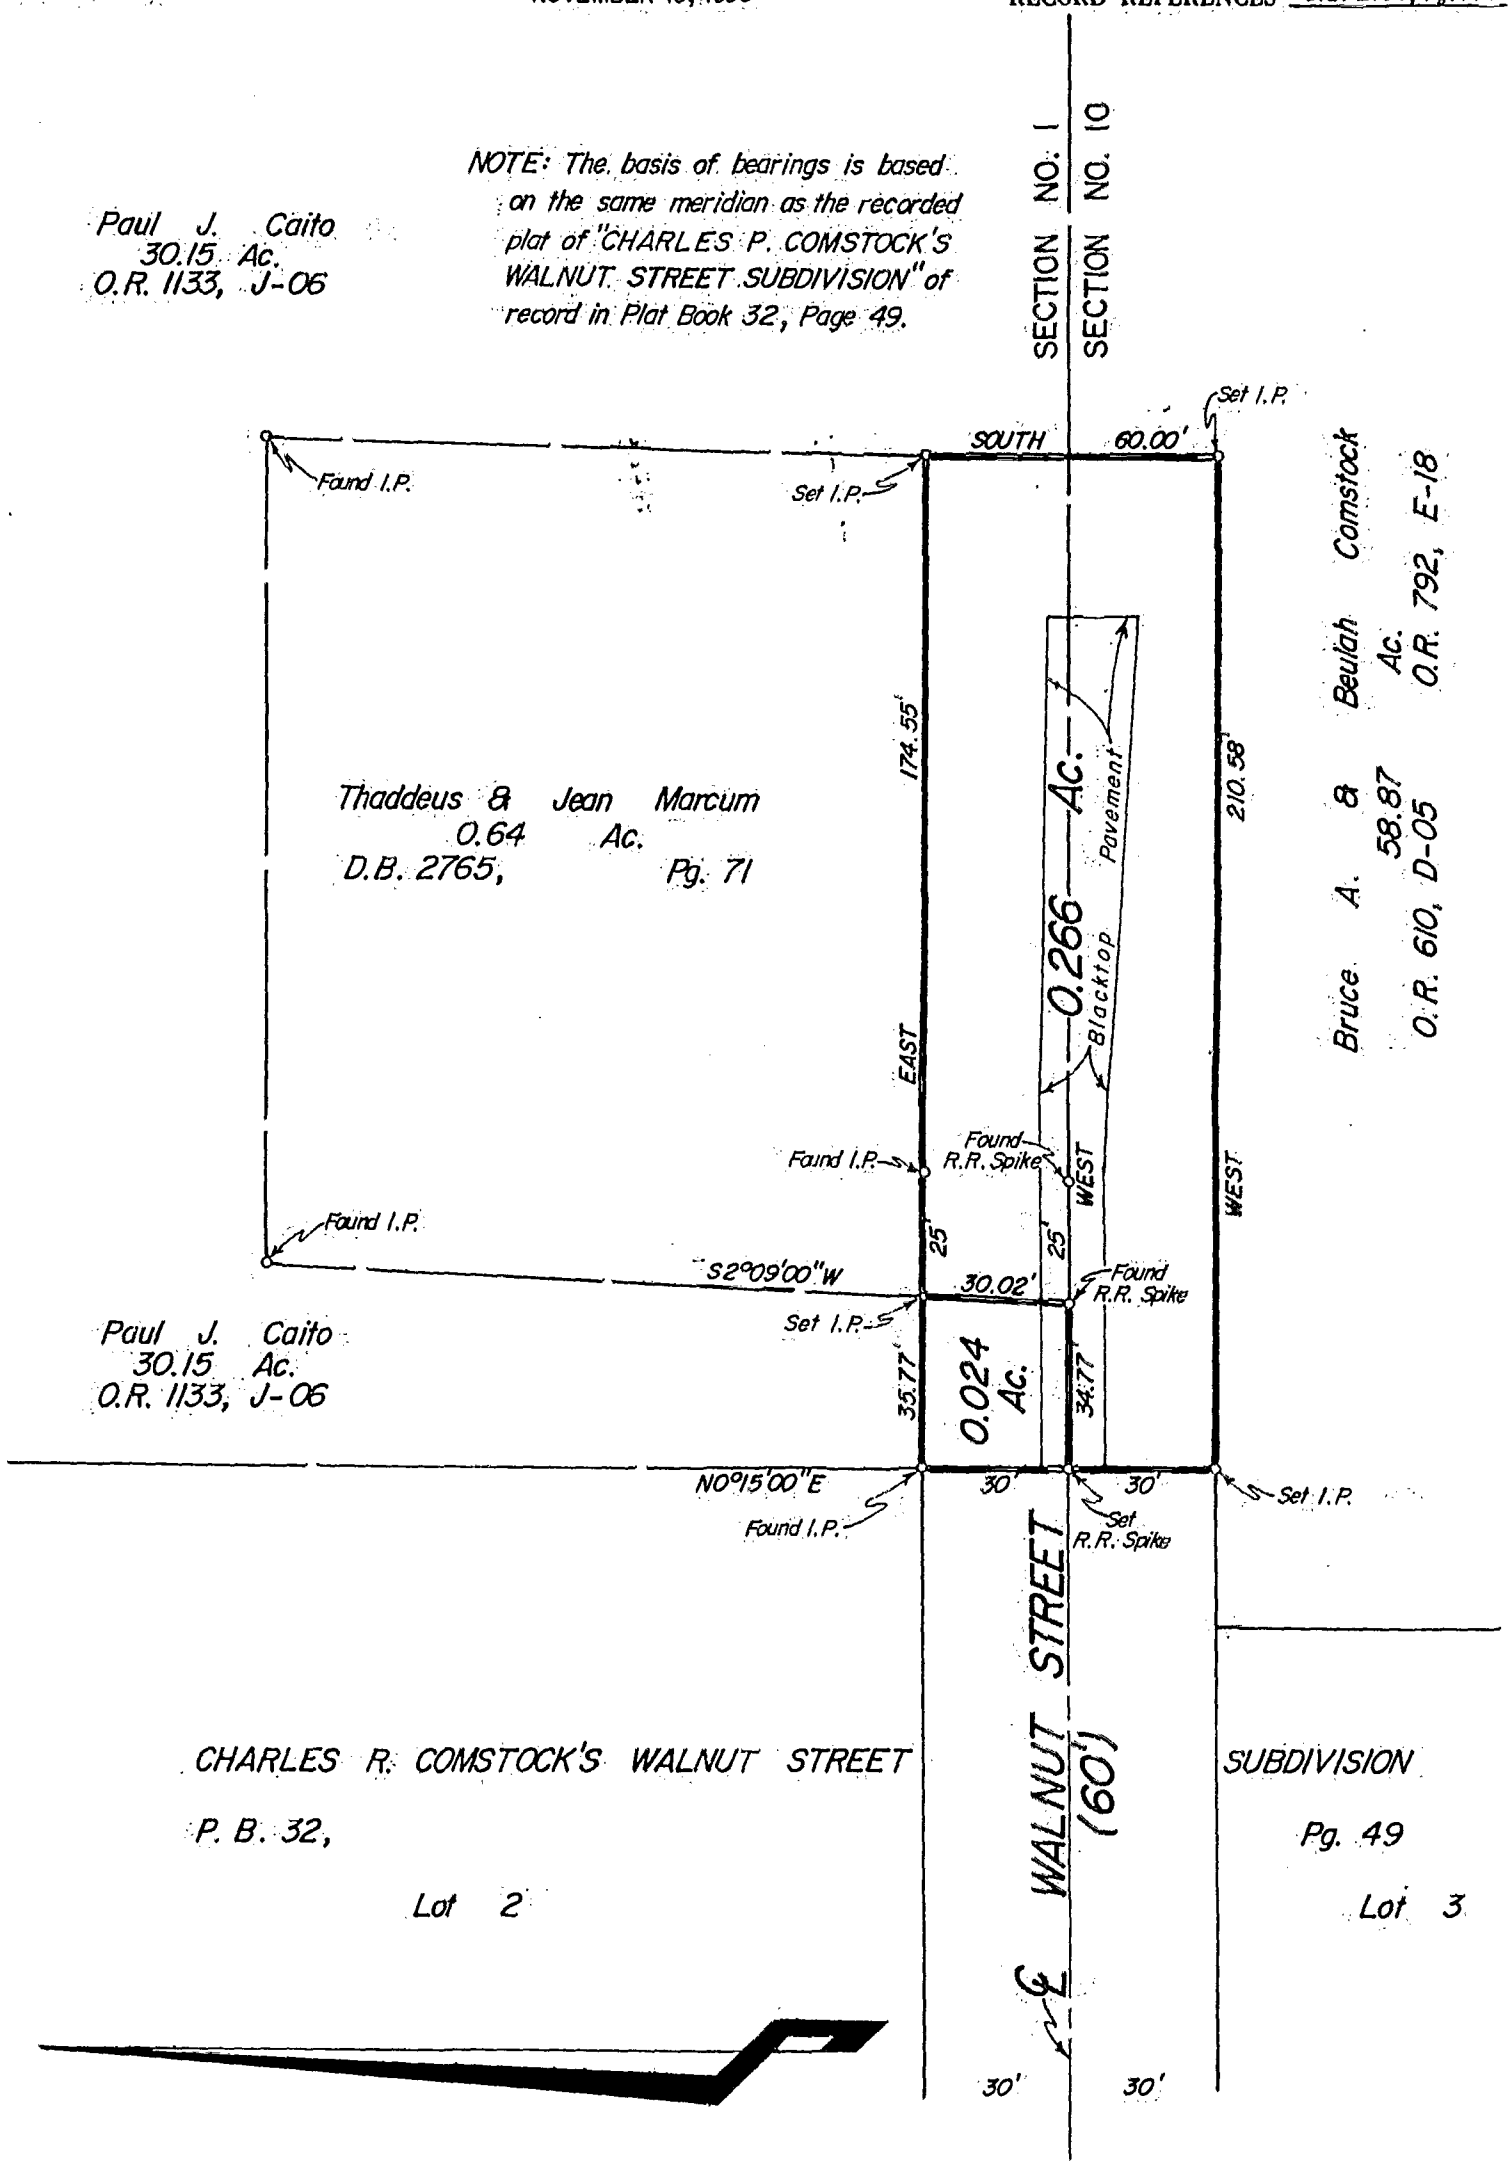

We hereby declare that the foregoing plat was prepared from an actual survey of the premises and shows the location of the boundary.

18935 1675

E.M.H.&T. INC.

By John W. Cupp

Professional Surveyor No. 5485

7-181-1005-88-F2