

NORTHLAND

189107650

2903-80

ORDER NO.


SURVEYING COMPANY

O-74-F

614-895-1522

CERTIFIED TO CHICAGO TITLE COUNTY OF FRANKLIN
 LENDER NORTH CENTRAL P.B. _____ PG. _____ D.B. _____ PG. _____
 SCALE 1: 100' DATE 10-22-85 BUYER PIERCE

SURVEY OF 2.551 ACRES OF LAND
 PLAIN TOWNSHIP, OHIO
 KNOWN AS 8106 CLOUSE RD.

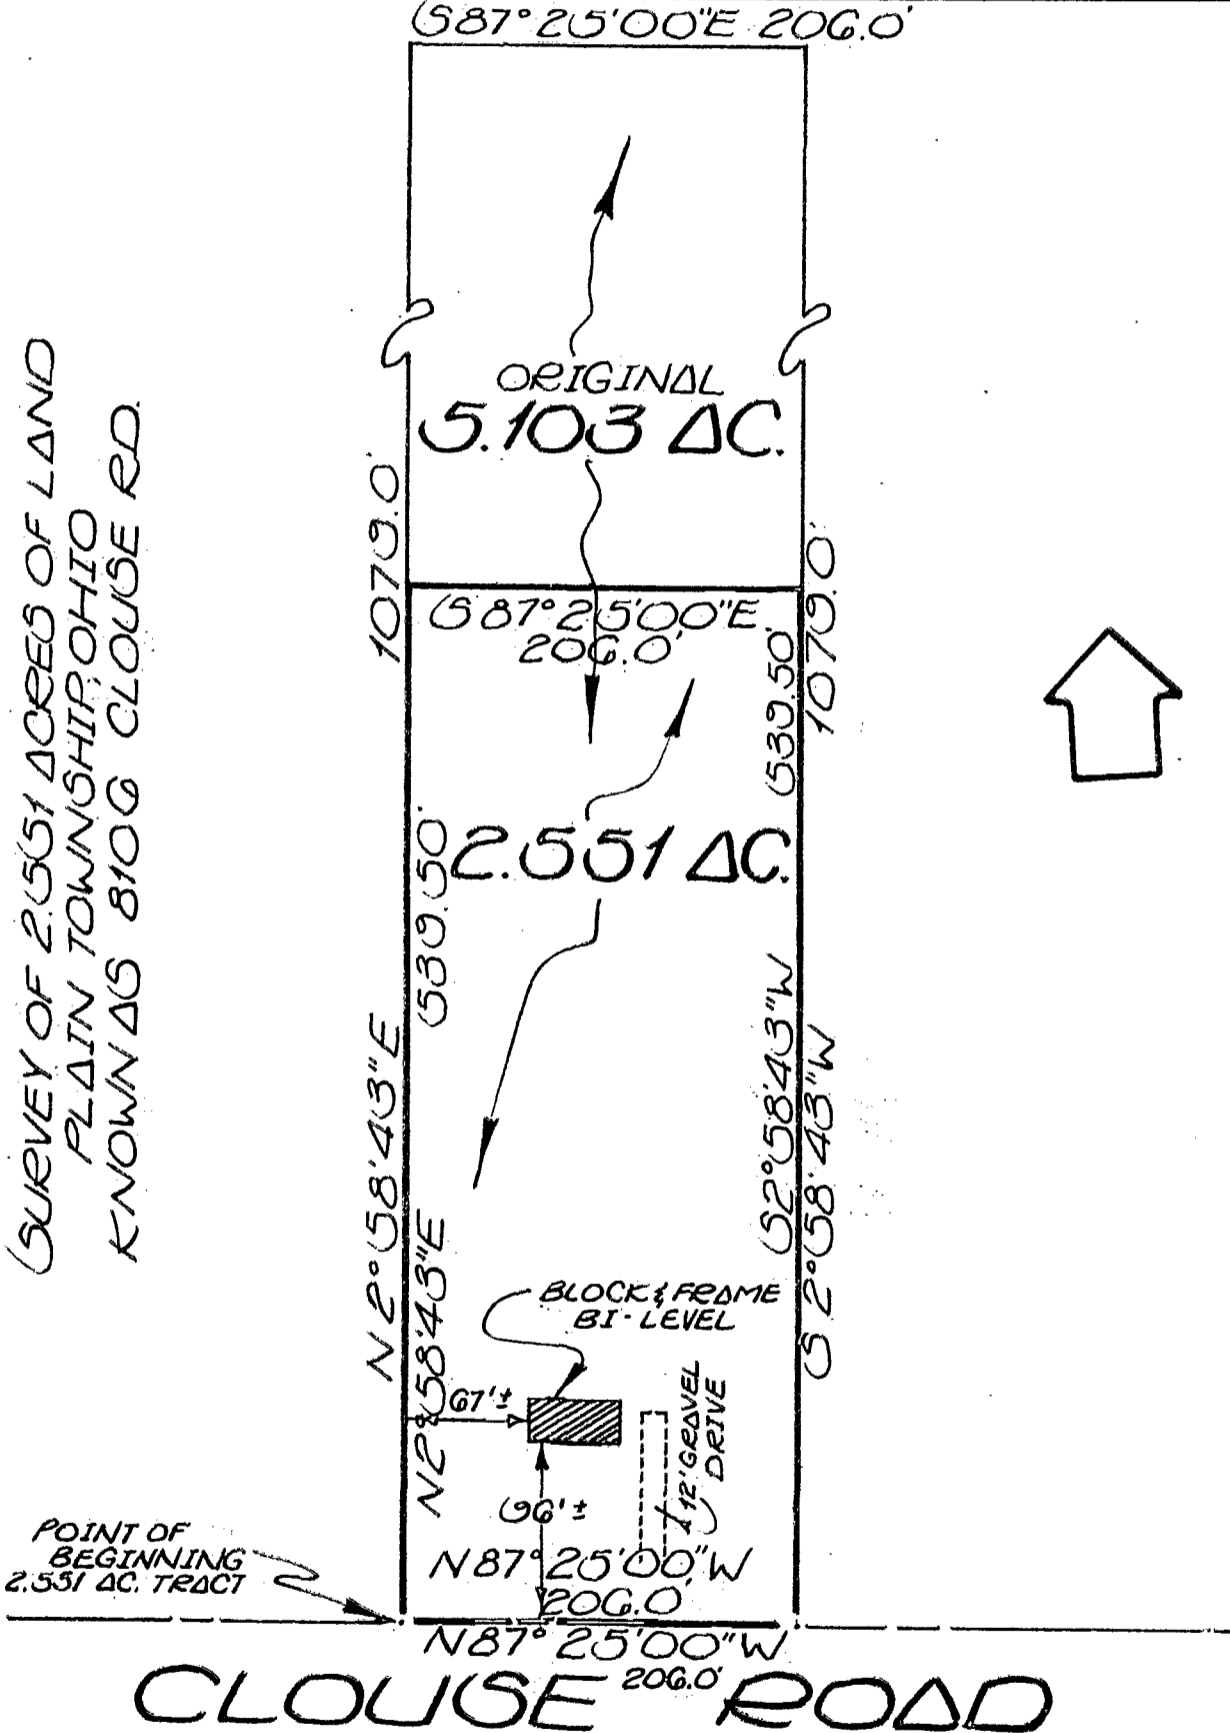

CLOUSE ROAD

We hereby certify that the foregoing plat was prepared from an actual survey of the premises and correctly shows the location of the building or buildings including any drives. This plat is prepared for mortgage loan and title purposes only and is not to be construed as having been prepared for the owner or for the use of the owner for any purpose. Subject to all rights-of-way, easements and restrictions, if any, of previous record.

Northland Surveying Company

6040 CLEVELAND AVENUE
 COLUMBUS, OHIO 43229

BY [Signature]
 REGISTERED SURVEYOR NO. 5519

