

189107650

347

MYERS SURVEYING Co.

2740 East Main Street, Columbus 43209 (Bexley), Ohio

A 5.103 ACRE TRACT BEING PART OF THE W1/2 · NE 1/4 · SECTION 10 · T 2N · R 16W OF UNITED STATES MILITARY LANDS, PLAIN TWP., FRANKLIN CO., OHIO

FOR


CHICAGO TITLE INSURANCE COMPANY

AND/OR

FREEDOM FEDERAL SAVINGS & LOAN ASSOCIATION


P.B. Page
Scale 1" = 50'

Franklin Co. Rec. Office
11-25-86

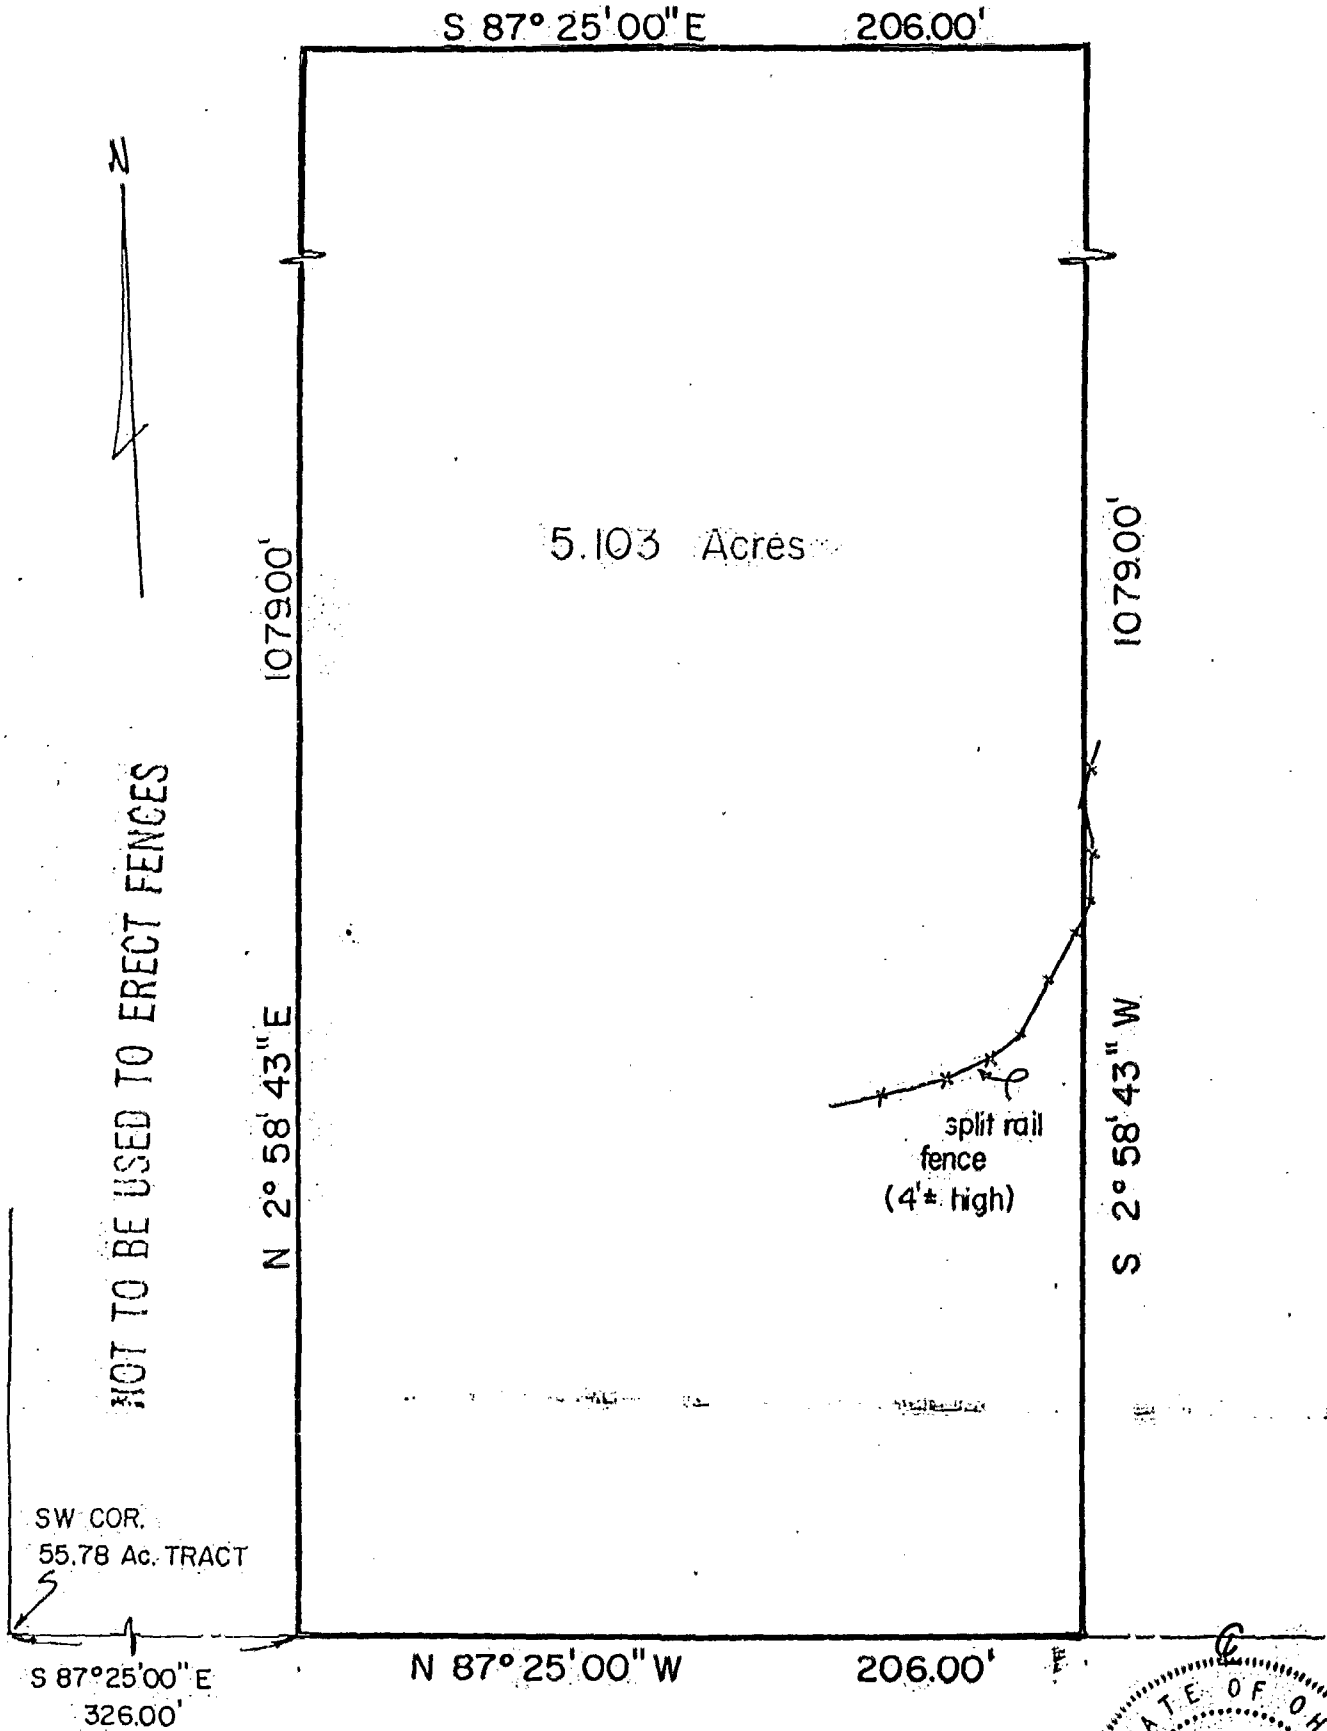

NOT TO BE USED TO ERECT FENCES

Clouse Road

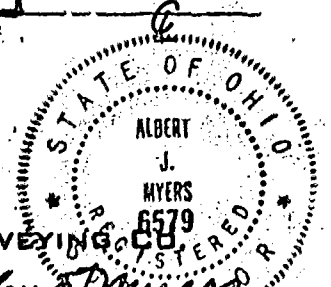

We hereby certify that the foregoing plat was prepared from an actual survey of the premises. No side line of principal building is less than dimension shown. Iron pins not set unless indicated thus -I-. For Mortgage Loan & Title Insurance purposes only.

MYERS SURVEYING CO.
BY *Albert J. Myers*
Registered Surveyor