

EVANS MECHWART HAMBLETON & TILTON

CONSULTING ENGINEERS — SURVEYORS
GAHANNA, OHIO

188107600

0-76-A

SURVEY OF 5 ACRE TRACT

Located in Section 4, Township 2, Range 16
Plain Township, Franklin County, Ohio

SCALE 1" = 100'


o = Iron Pin
January 28, 1966

DEED BOOK

PAGE

PLAT BOOK

PAGE

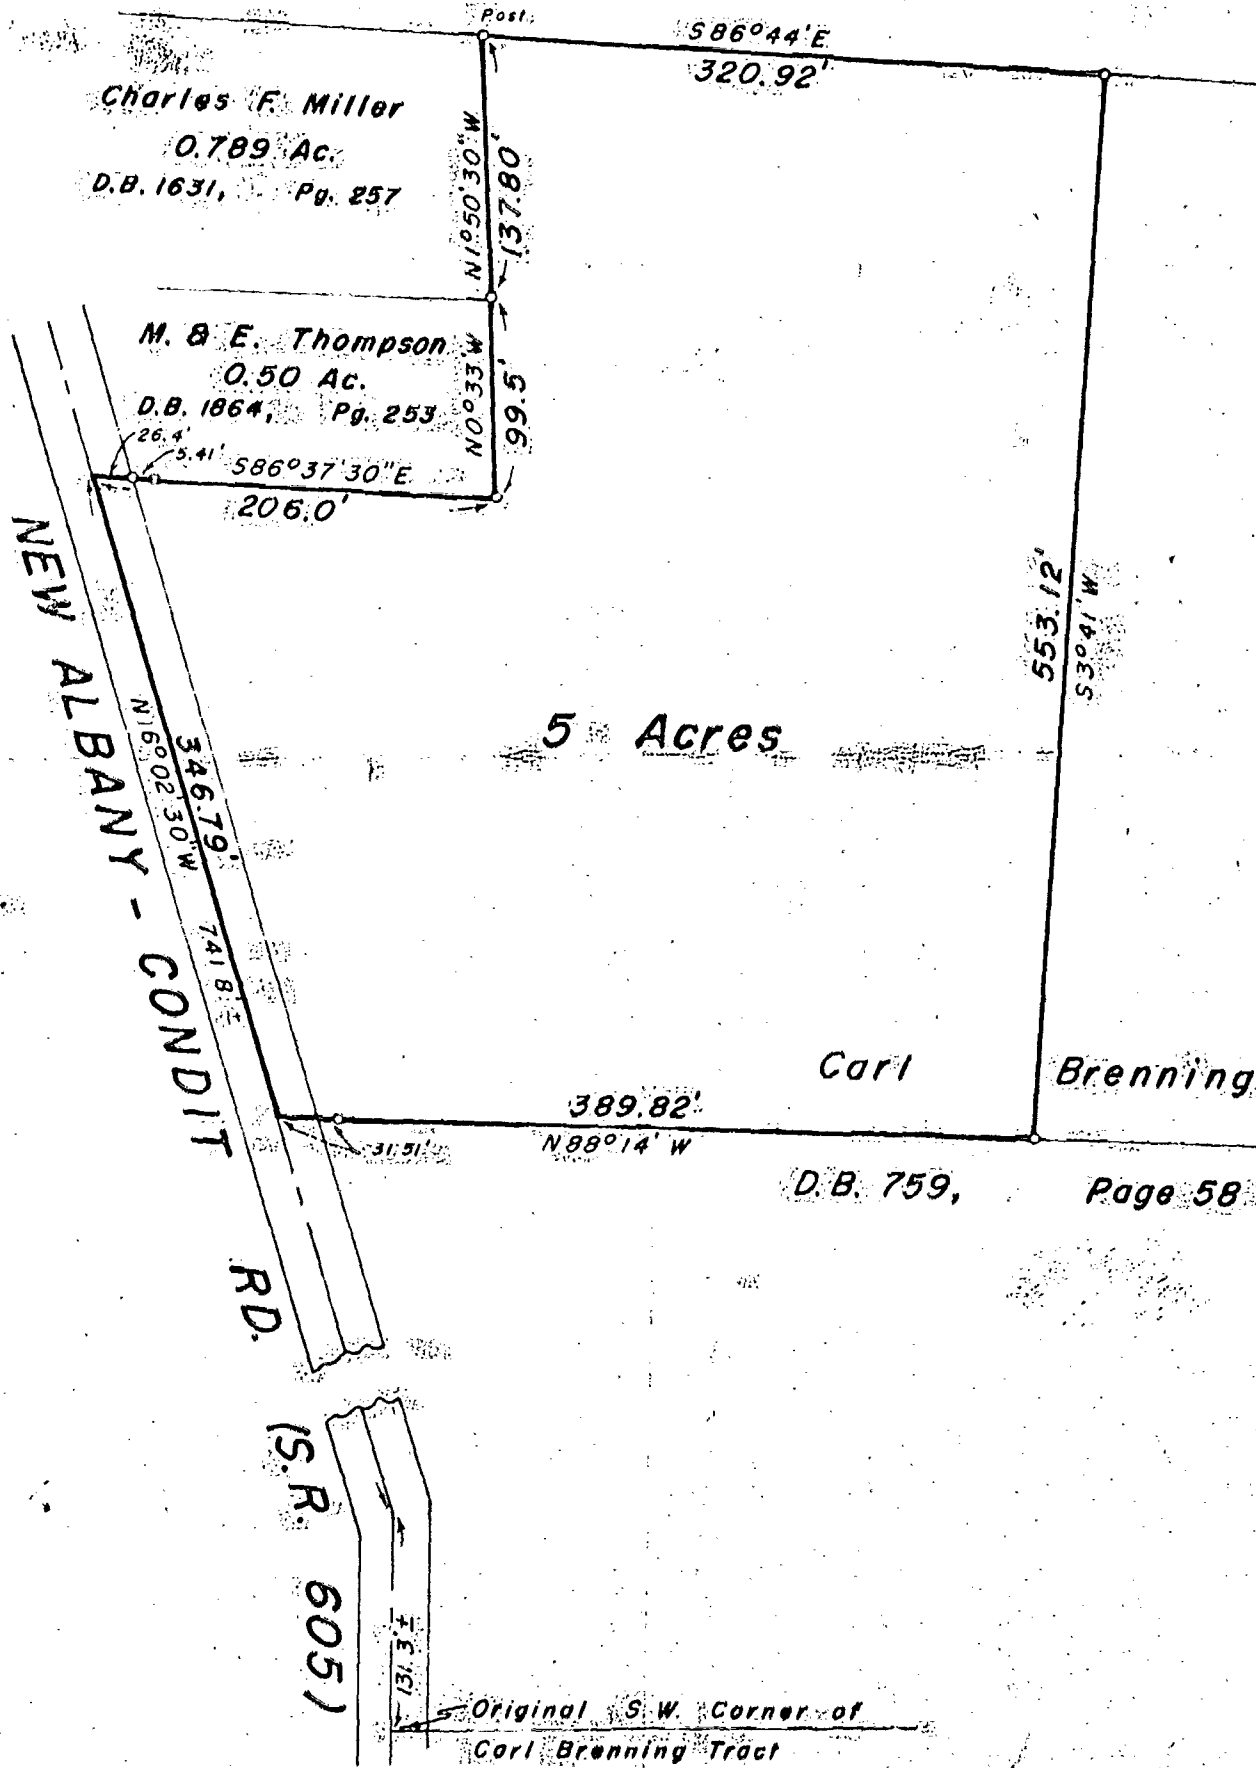

000
1767
1966
RD
N
H
S
T
O
W
N
R
D
M
O
F
J
O
H
N
S
T
O
W
N
R
D
094083
120
0000

We hereby certify that the foregoing plat was prepared from an actual survey of the premises and shows the location of the boundaries.

EVANS MECHWART HAMBLETON & TILTON, INC.

BY *[Signature]*