PROPERTY OWNED BY
JOHN M. GREGEL
6840 CEDAR BROOK GLEN, NEW ALBANY, OHIO
LOT NO. 36 - CEDAR BROOK SECTION NO. 3
PLAIN TOWNSHIP (FRANKLIN COUNTY) OHIO

188107625

N 53-D

Scale 1" = 60' Date 5-3-71 P.B. 42 P. 45 D.V. 1203 P. 165 Lot No. 36

HOWARD A. & MARGARET A. BENNETT

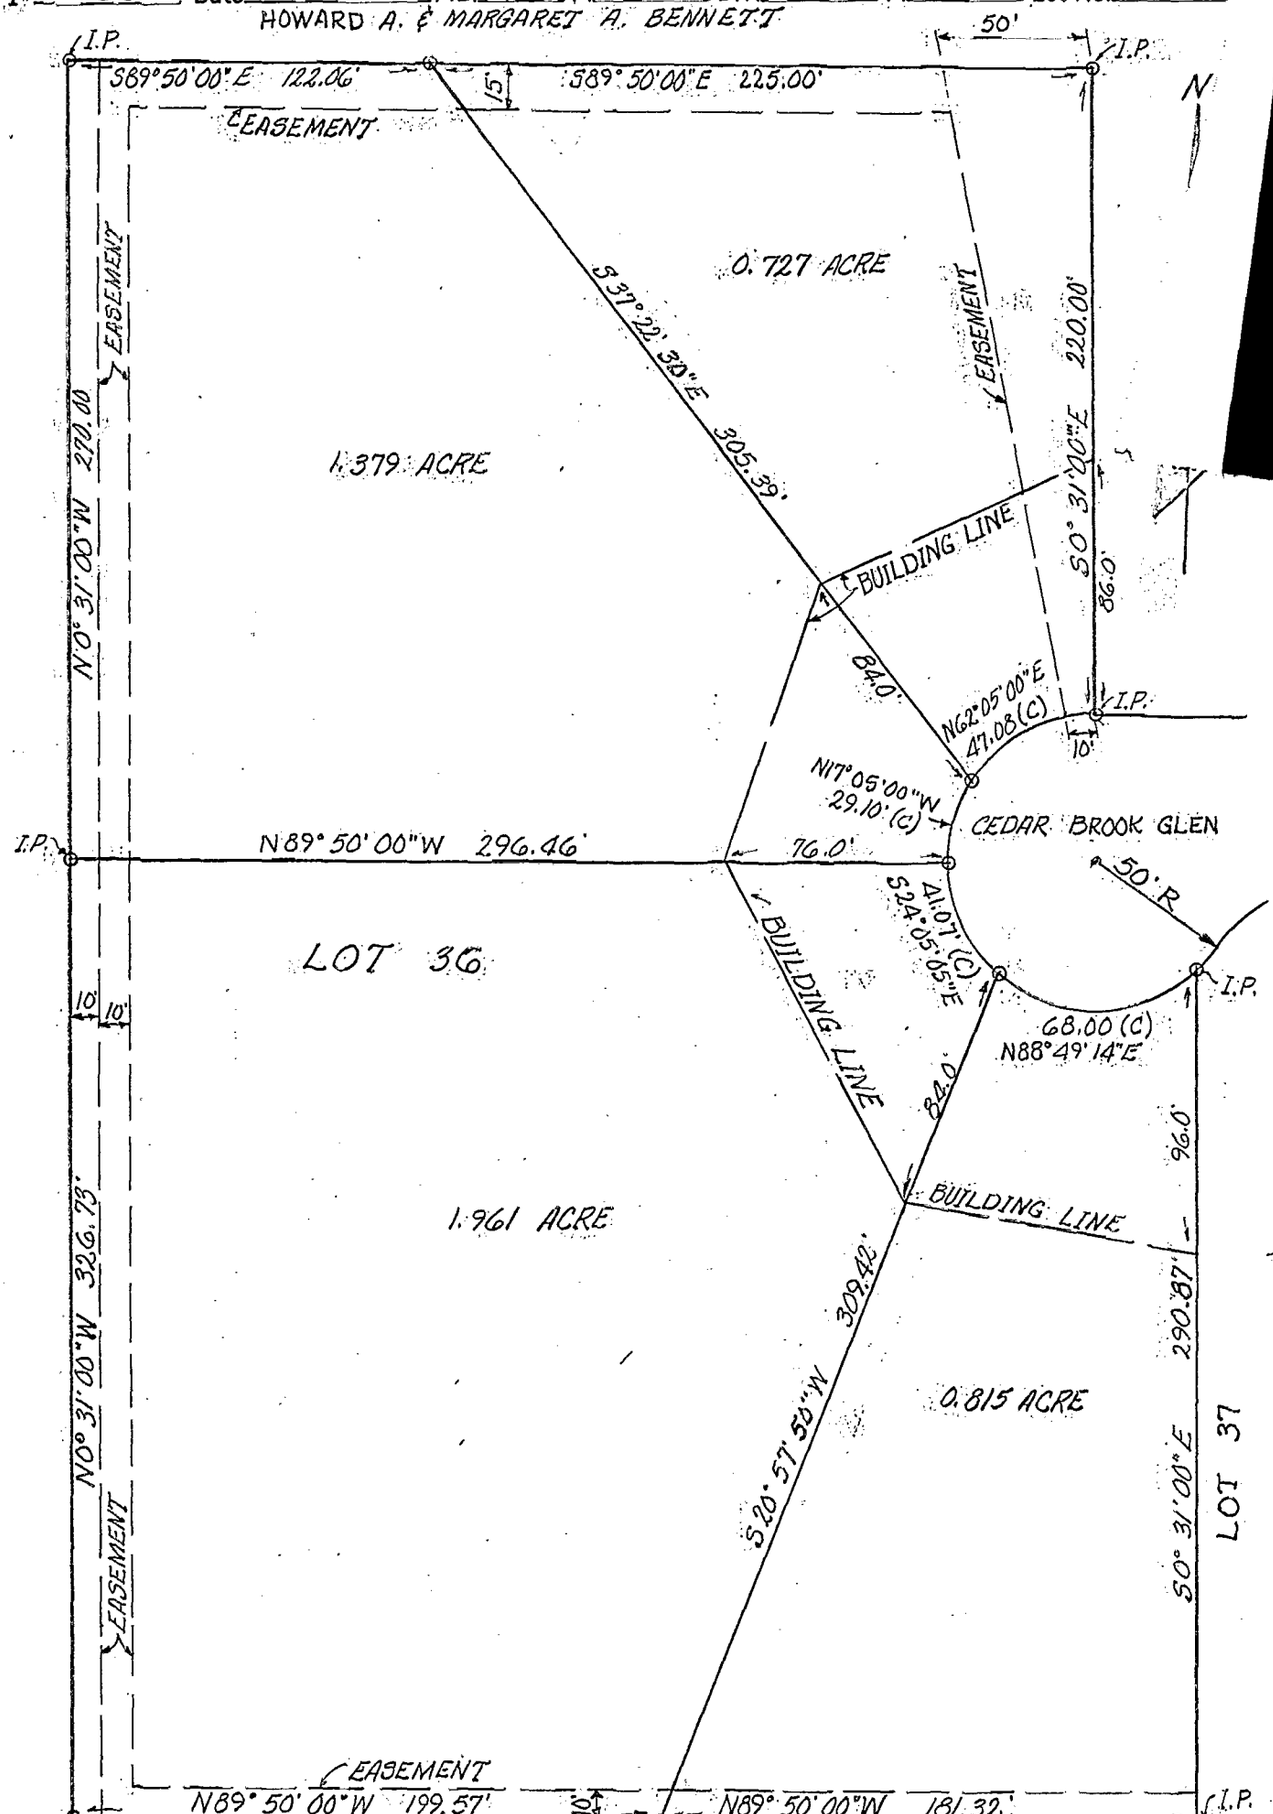

I hereby certify that the foregoing drawing was prepared from an actual survey of the premises.

Drawn by C.D.

Henry L. Kunze
Registered Surveyor No. 5219

KUNZE, GAMES AND STREET, INC.
CIVIL ENGINEERS AND LAND SURVEYORS
6914 SUNBURY ROAD, WESTERVILLE, OHIO 43081