BAUER, DAVIDSON & MERCHANT, INC.

CONSULTING ENGINEERS

2607½ NORTH HIGH STREET — COLUMBUS, OHIO 43202

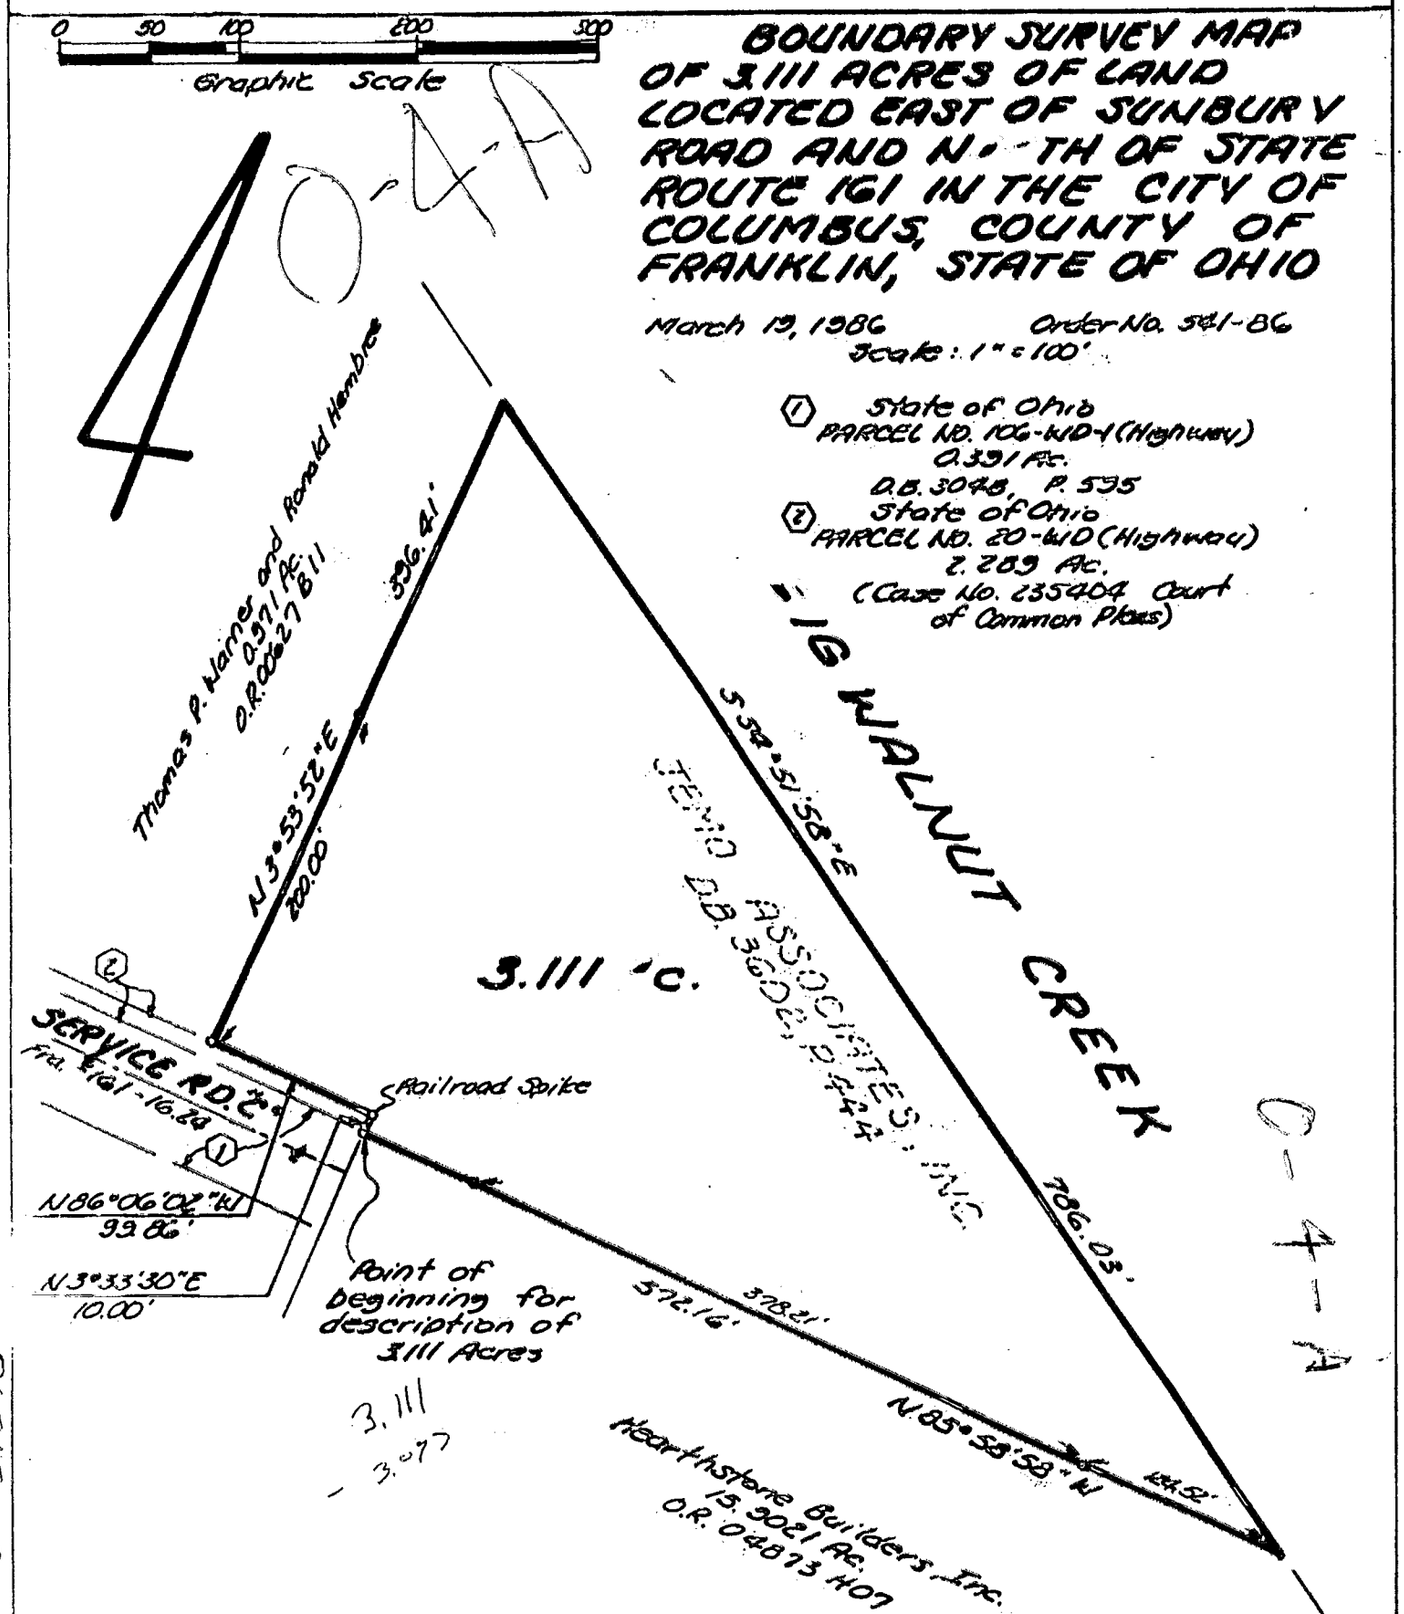

Situated in the State of Ohio, County of Franklin, City of Columbus, being part of Section 4, Township 2, Range 17, United States Military Lands containing 3.111 acres of land, more or less, said 3.111 acres being part of that tract of land described in the deed to Jemo Associates, Inc. of record in Deed Book 3602, Page 444, Recorder's Office, Franklin County, Ohio.

The bearings shown on the above map are based on an assumed meridian.

We hereby certify that the above map was prepared from information obtained from an actual field survey conducted by Bauer, Davidson & Merchant, Inc. in March of 1986.

—o— Indicates ¾-inch (I.D.) iron pipes unless otherwise noted.

Bauer, Davidson & Merchant, Inc.
Consulting Engineers

By Jimmie L. Davis
Jimmie L. Davis
Professional Surveyor No. 6842

STATE OF OHIO JIMMIE L. DAVIS 6842 REGISTERED SURVEYOR

#541-86

40-4-A

0-4-A

Gals.-WESTERVILLE

8585735