EVANS MECHWART HAMBLETON & TILTON, INC.

CONSULTING ENGINEERS — SURVEYORS
GAHANNA, OHIO

SURVEY OF 13.234 ACRE TRACT

Located in Southeast Quarter, Township 2, Range 17
United States Military Lands
Blendon Township, Franklin County, Ohio

SCALE 1" = 400' January 11, 1968 o = Iron Pin DEED BOOK 1896, PAGE 552 PLAT BOOK , PAGE

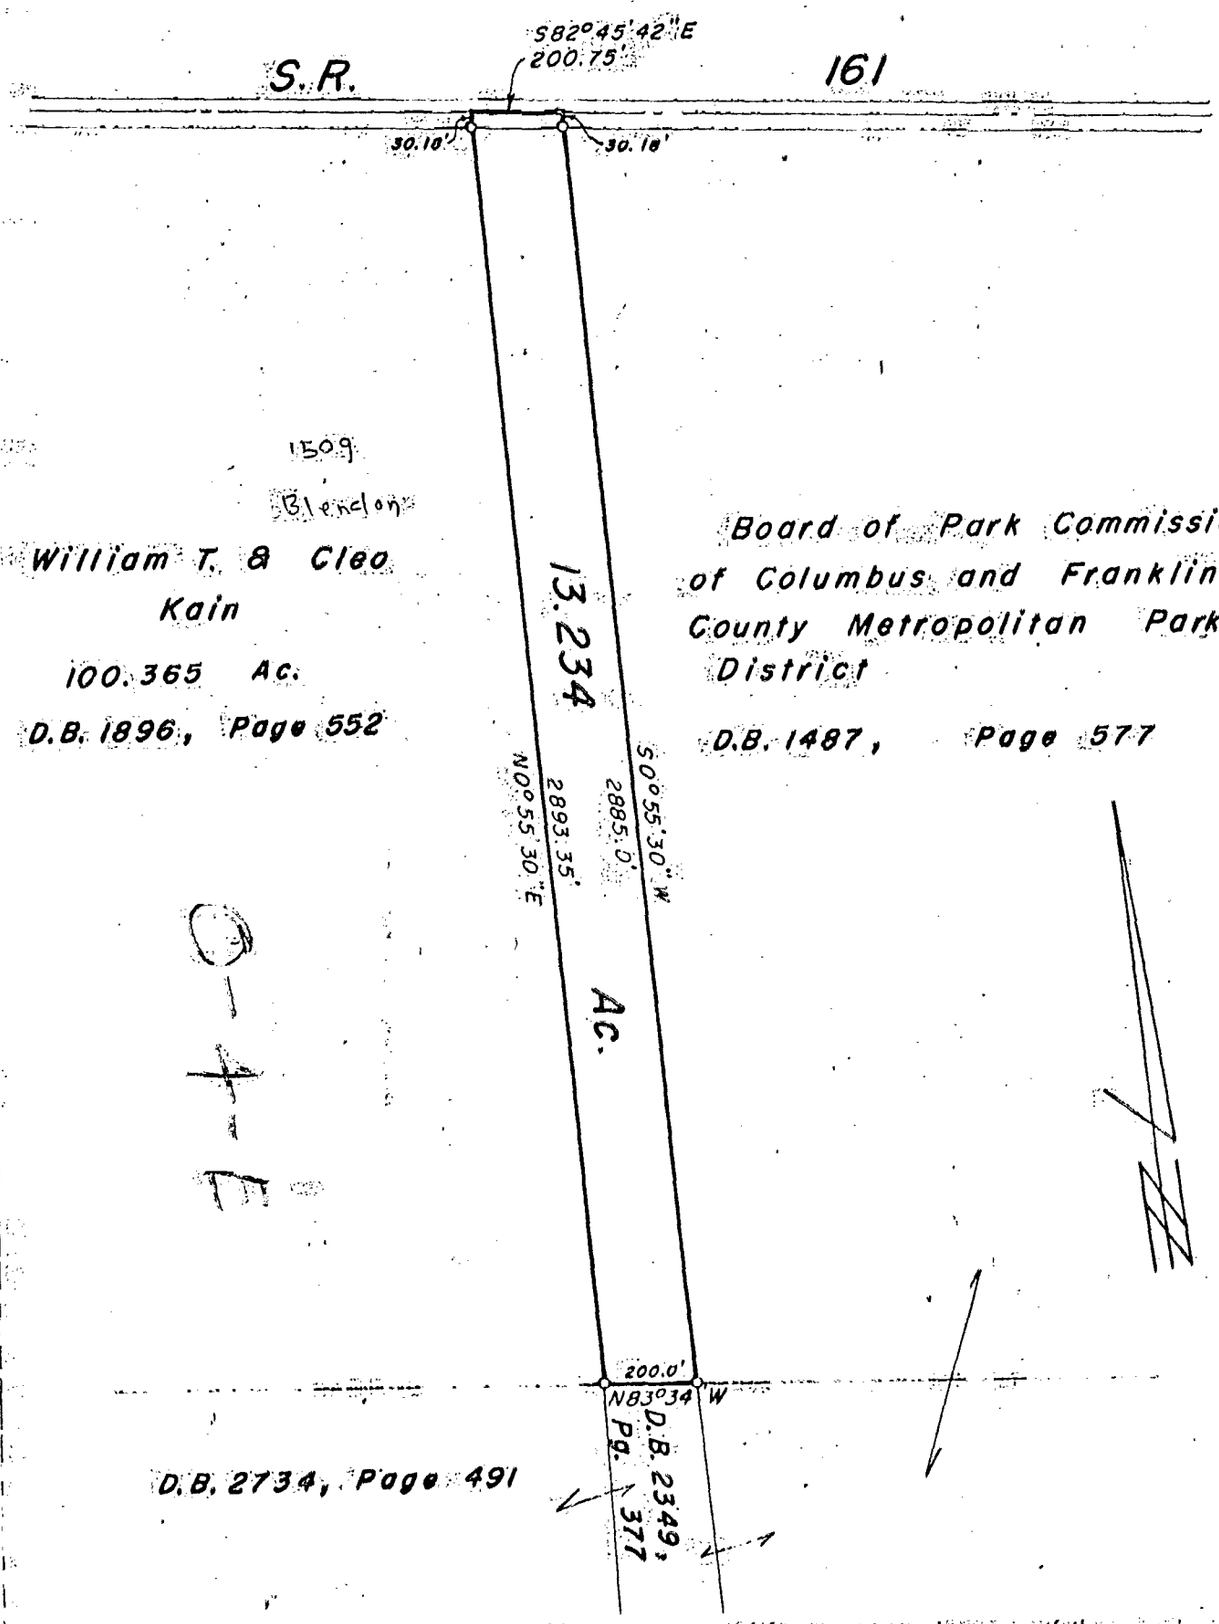

We hereby certify that the foregoing plat was prepared from an actual survey of the premises and shows the location of the boundaries.

EVANS MECHWART HAMBLETON & TILTON, INC.

13-153-2319-67-F1