

BAUER, DAVIDSON & MERCHANT, INC.

18465 7500

CONSULTING ENGINEERS

M 200-J


2607 1/2 NORTH HIGH STREET

COLUMBUS, OHIO 43202

LOT NO. 587 AND PART OF LOT NO. 588 PARKRIDGE VILLAGE SEC. 4
PLAT BOOK 62 COLUMBUS
PAGE 82 FRANKLIN COUNTY, OHIO

December 9, 1985

Scale: 1" = 30'

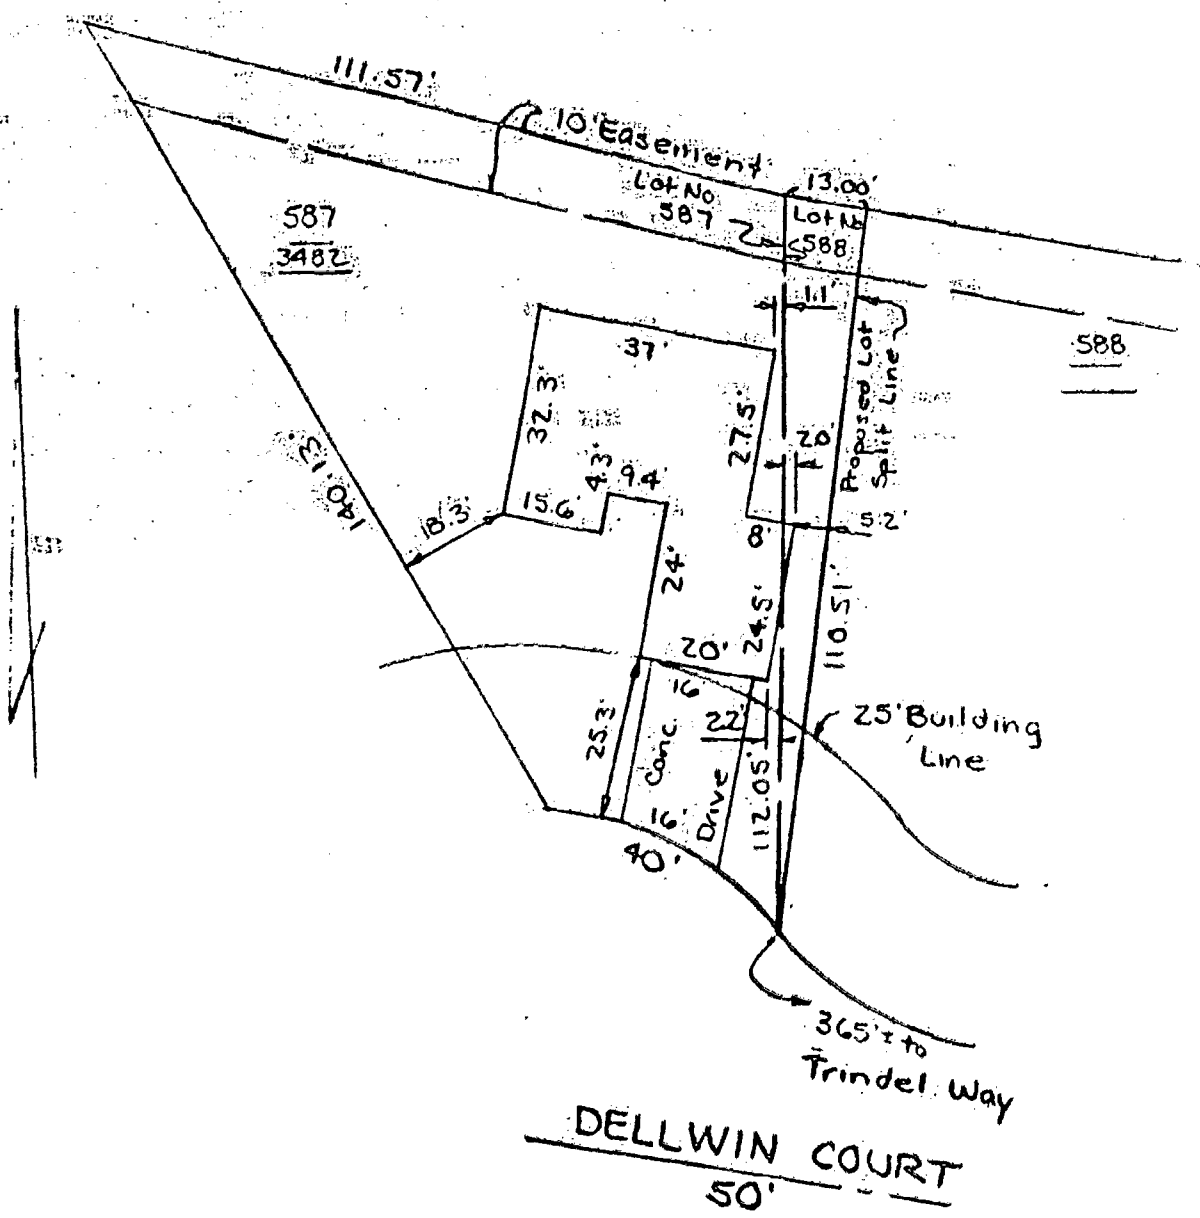

We hereby certify that the foregoing plat was prepared from an actual survey of the premises and shows the location of the building or buildings including any drives. This plat is prepared for mortgage loan and title insurance purposes only and is not to be construed as having been prepared for the owner or for the use of the owner for any purpose.

BAUER, DAVIDSON & MERCHANT, INC.

By *William W. Merchant*

Registered Surveyor

2554-85