

DODSON SURVEYING COMPANY


185607523 Columbus, Ohio

Survey of lot nos. 78, 79, 80 & 81 of Gould Park No. 2 and Lot No. 366 & a part of Reserve B of Gould Park No. 3, and a tract in quarter twp. 4, Twp. 2, Rq. 11, U.S.M.L., City of Columbus, Franklin Co., Ohio.
For: Jack A. & Faye A. Morris

Also, being all that area described in O.R. 250 B03, Parcels 1, 2 & 3, Franklin Co. Recorder's Office.

M 194
M 2(52)A

W.C. & S.M. Smith

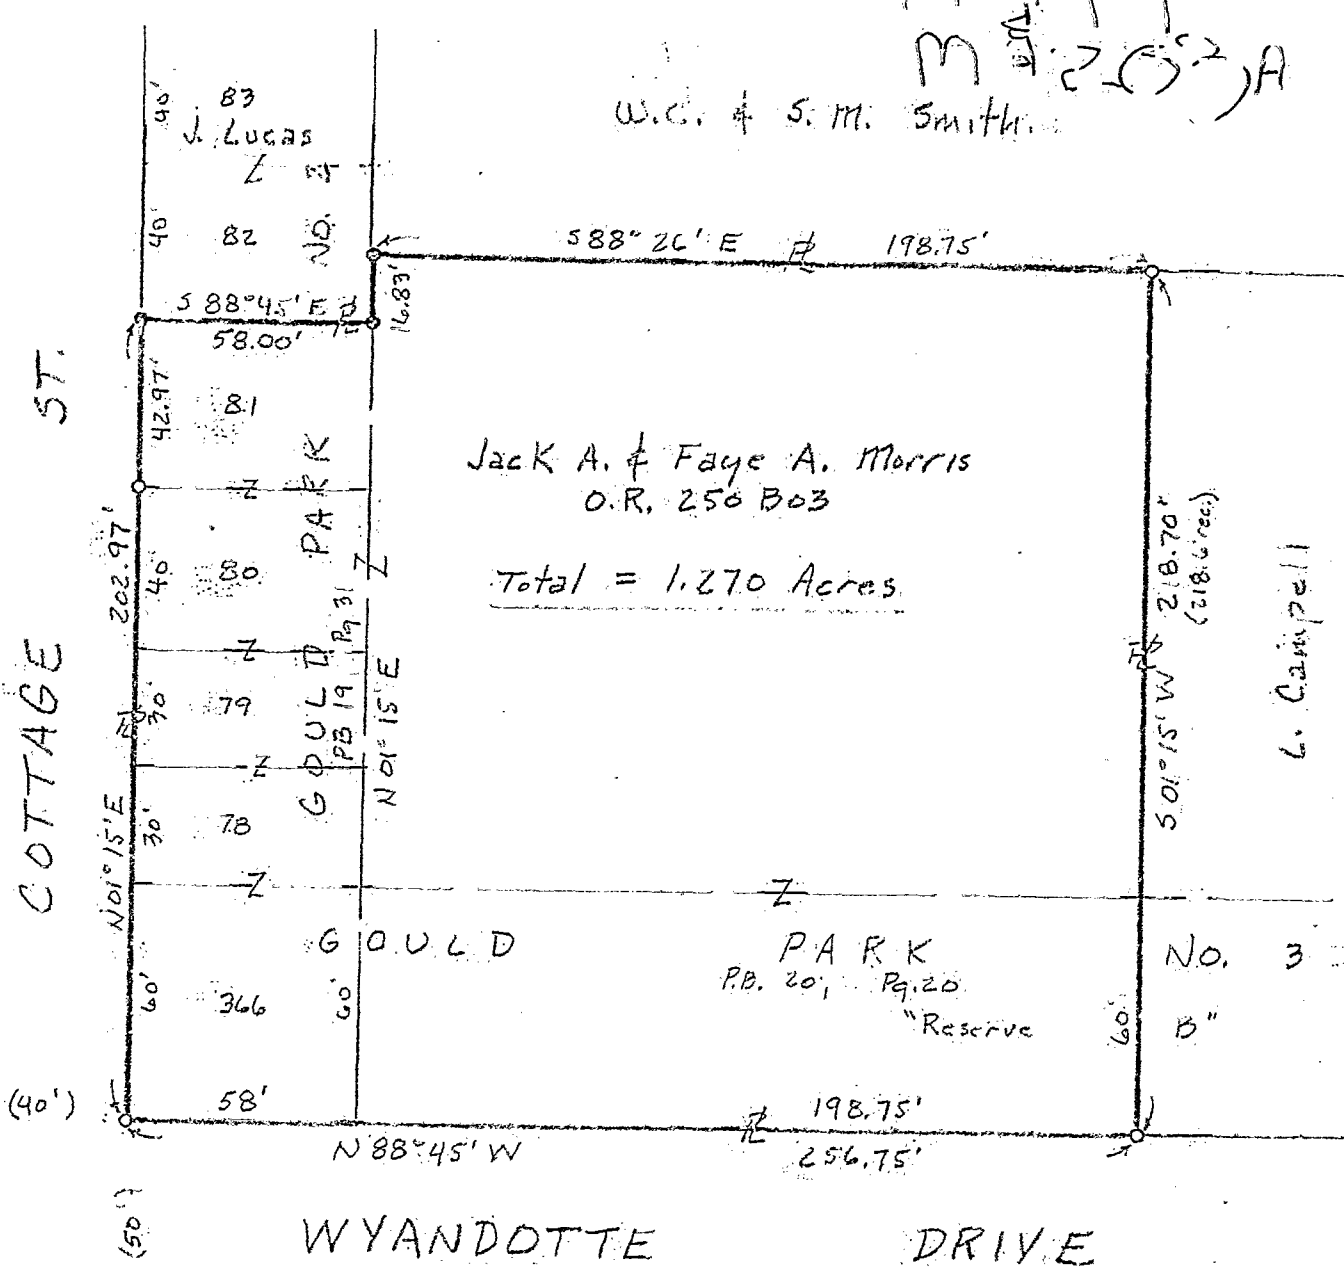


Jack A. & Faye A. Morris
O.R. 250 B03

Total = 1.270 Acres

L. Campbell

Note: Basis of bearings assumed
 as N01°15'E along Cottage St.
 as shown on plats of Gould Park.

- I.P. Found
- ⊙ Iron Pin set, 3/4" x 30" with I.V. cap
- ⊙ Railroad spike set

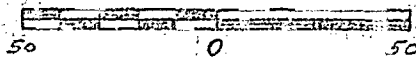

SCALE: 1" = 50'

I DO HEREBY CERTIFY THAT THE FORGOING PLAT WAS PREPARED FROM AN ACTUAL SURVEY OF THE PREMISES, based on deed description.

By: Walter A. Dodson 4-17-81

WALTER A. DODSON, P.S. NO. 6486, OHIO

