186107575

COLUMBUS WESTERVILLE S.D.
M 194-EEE

Myers Surveying Company, Inc.

2740 East Main Street, Columbus 43209 (Bexley), Ohio
614-235-8677 FAX: 614-235-4559

A Boundary Survey prepared for and certified to:
Gregory & Ann Gillman

Legal Description: Situated in Ohio, County of Franklin, City of Columbus, Being Lot 90 and Part of Lot 89 Ravine Ridge, Plat Book 54, Page 10
Applicant:
Posted Address: 5273 Springfield Dr., Columbus, Ohio
Apparent Encroachments: None.

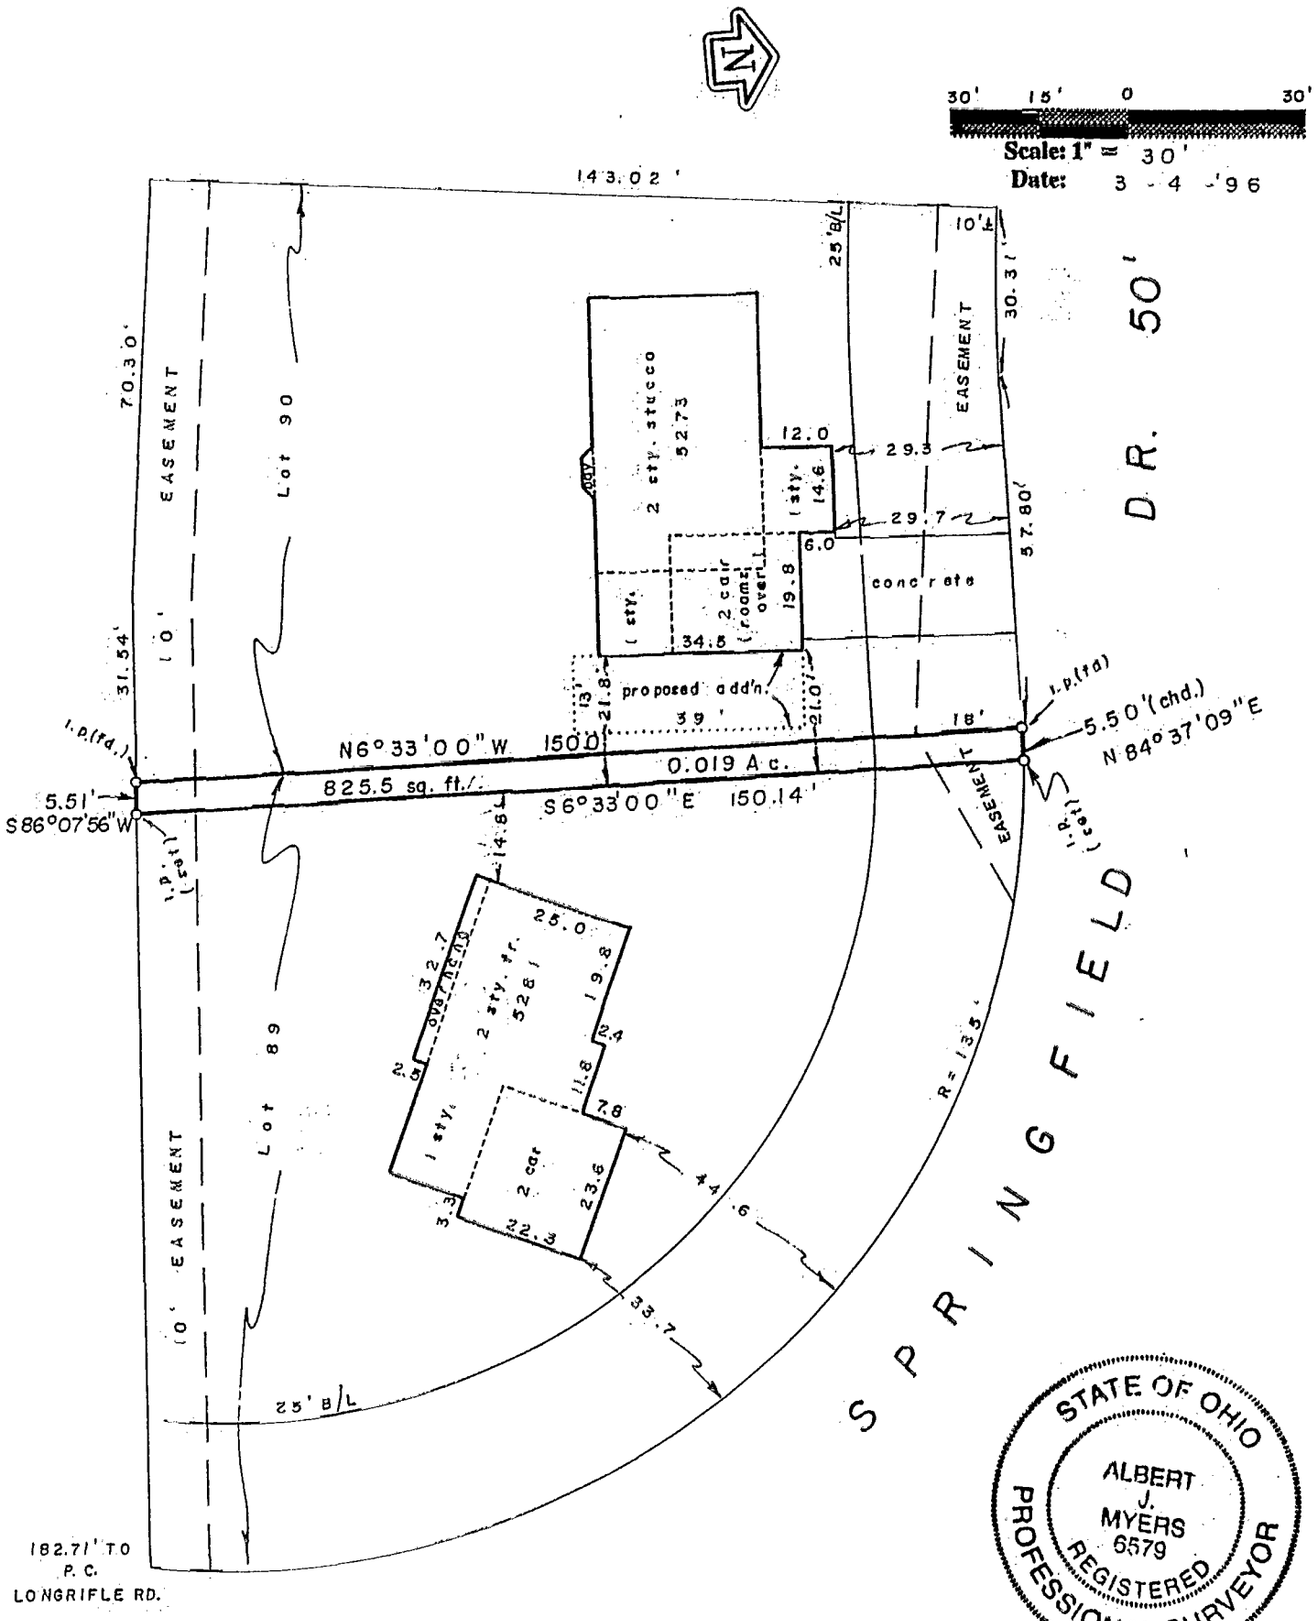

We hereby certify that the foregoing Boundary Survey was prepared from actual field measurements in accordance with Chapter 4733-37 Ohio Administrative Code. Iron pins set are 30"x1" O.D. with an orange plastic plug inscribed "P.S. 6579", unless otherwise noted. Basis of bearing is from Plat Book 54, Page 10, the westerly line of Lot 89 held as North 06 degrees 33 minutes 00 seconds West.

Myers Surveying Co., Inc.
By Albert J. Myers
Professional Surveyor

Myers Order No. - 7-02/19/96	Rec.	Field	DWG	Ltr.	Ck.

COLS. WESTERVILLE S.D.
86107575