


87107552

CURVE TABLE			
CURVE	CHORD	RADIUS	DELTA
C 1	28.79	20.00	92°05'15"

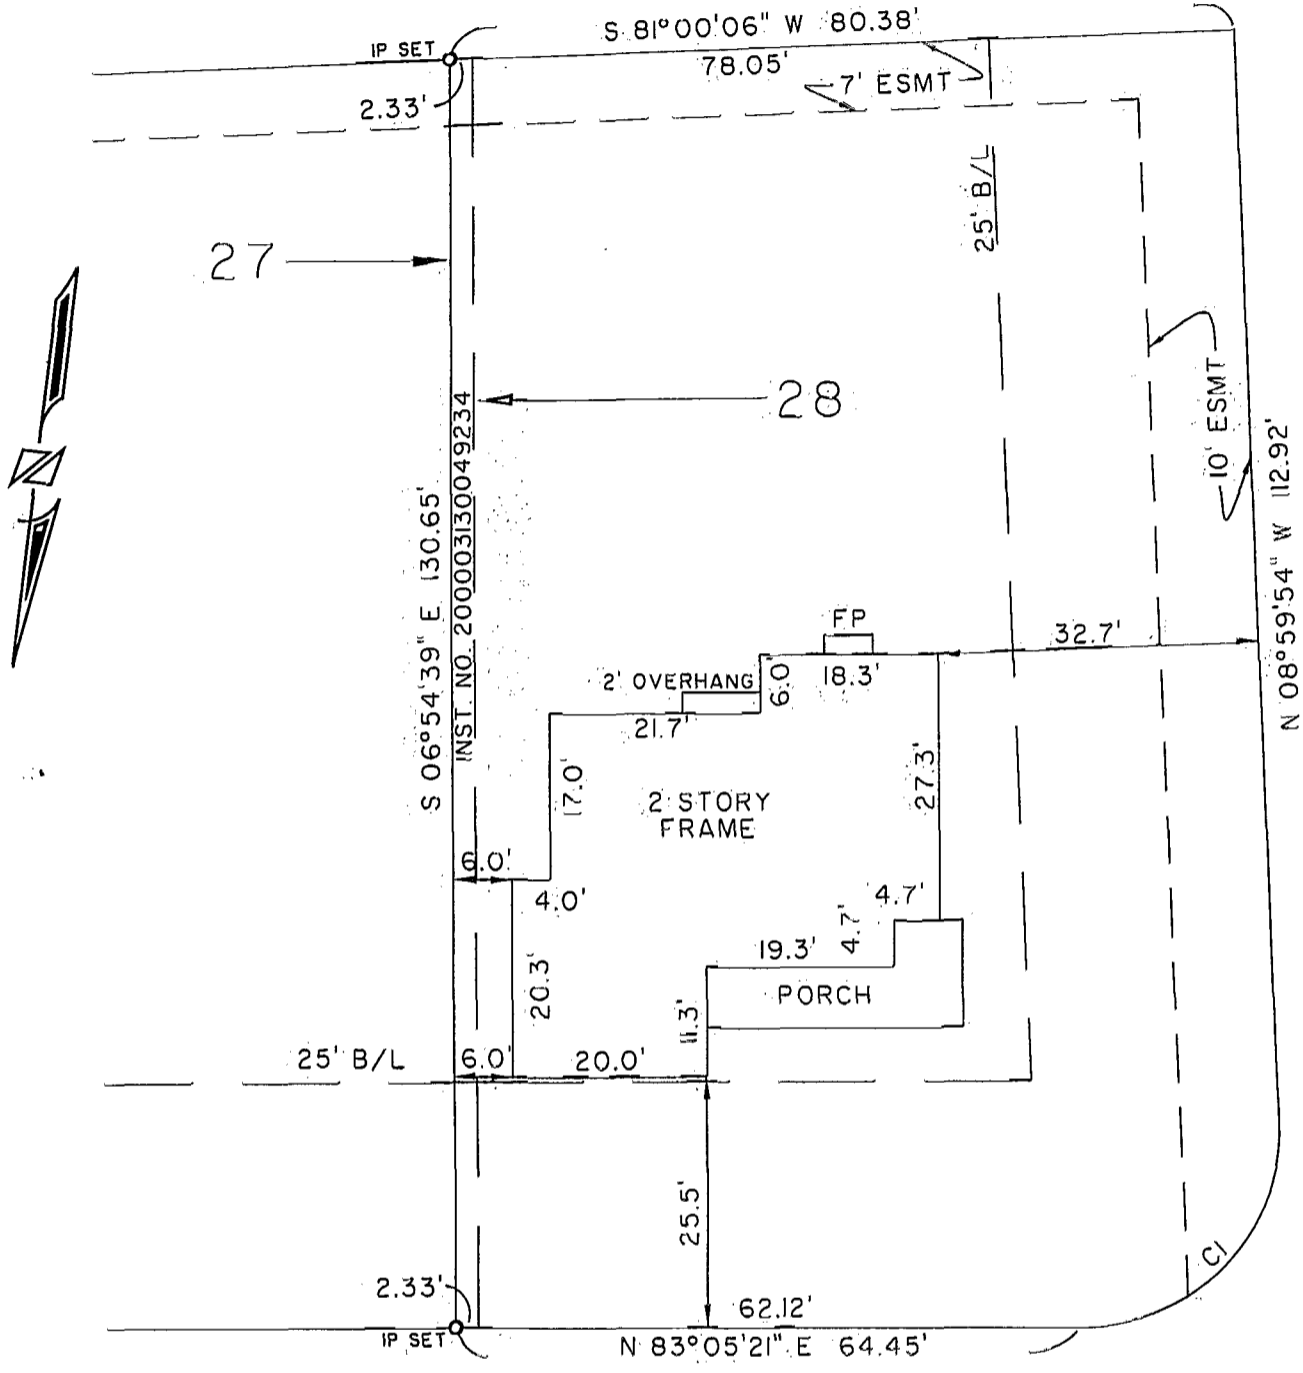

HERB GARDEN DRIVE

ALBANY GARDENS DRIVE 50'

Lot No. 28 lies within Zone(s) X as designated on the FIRM Map No. 39049C 0180G dated 9-2-95

We hereby certify that the foregoing Mortgage Location survey was prepared from actual field measurements in accordance with Chapter 4733-38 Ohio Administrative Code, and is not a boundary survey pursuant to Chapter 4733-37 of said code.


THE INFORMATION SHOWN HEREON IS NOT TO BE USED FOR THE INSTALLATION OF BUILDINGS, FENCES, LANDSCAPING OR OTHER PERMANENT IMPROVEMENTS:

Owner: CROSWELL

LOT 28 AND PART OF LOT 27 ALBANY PARK

SECTION 1 PART 1  
PLAT BOOK 90 PAGE 61  
CITY OF COLUMBUS  
for  
DOMINION HOMES

R. D. Zande & Associates, Inc.  
1237 Dublin Road  
Columbus, Ohio 43215  
PHONE: (614) 486-4383  
FAX: (614) 486-4387

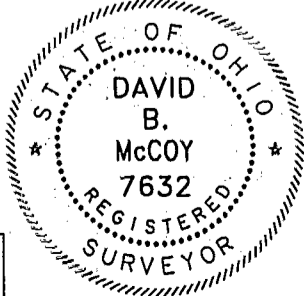

DR'N DBM  
CH'D  
JOB 281294

Scale: 1"=20' MARCH 2000

David B. McCoy  
REGISTERED SURVEYOR NO. 7632

C-75-D  
PLAIN