

18635-7500

NORTHLAND

P. 117-90

SURVEYING COMPANY



6040 CLEVELAND AVENUE

COLUMBUS, OHIO

43229

PHONE 614 - 895 - 1522

FOR M. I. HOMES, INC.


TYPE OF HOUSE _____

CITY OF COLUMBUS

P. B. 68 PG 34 LOT NO. 122 E. 5' OFF THE E.S. OF 121

SCALE 1" = 50' DATE 1-4-90

SUBDIVISION BLENDON ESTATES SECTION II

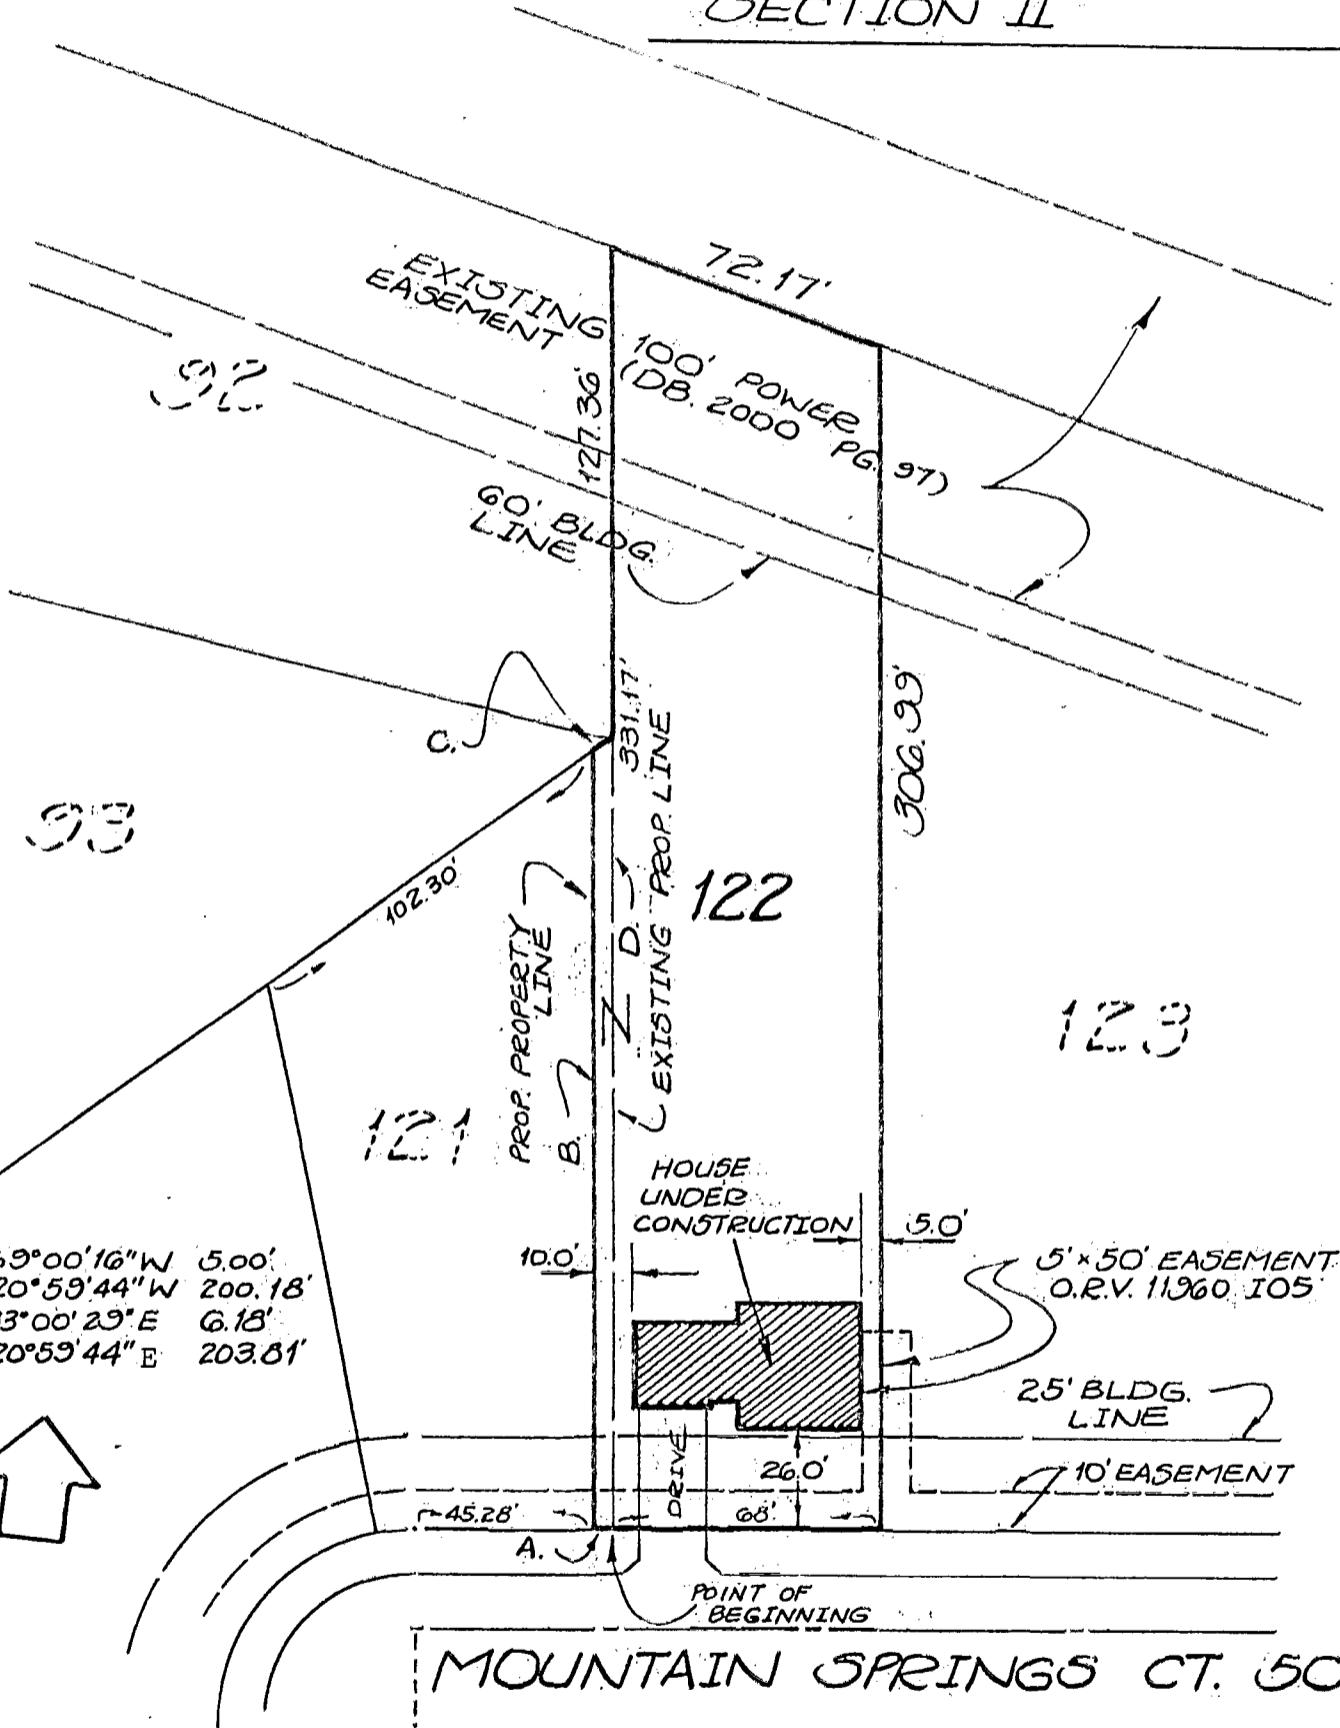

We hereby certify that the foregoing plat was prepared from an actual survey of the premises and correctly shows the location of the building or buildings including any drives. This plat is prepared for mortgage loan and title purposes only and is not to be construed as having been prepared for the owner or for the use of the owner for any purpose.

PLOT PLAN

The bearing system is based on
The Plat of Blendon Estates
Section II

P. 117-90	S.J.H.	
ORDER NO.	DRN.	CK.

11-94-555