


86109500

EXHIBIT

SUBJECT PROPERTY IS LOCATED IN THE STATE OF OHIO,
COUNTY OF FRANKLIN, CITY OF GAHANNA.

BEING LOTS 184, SUBDIVISION CHERRY BOTTOM VILLAGE 3, OF
RECORD IN PLAT BOOK 53, PAGE 75, FRANKLIN CO. RECORDER.

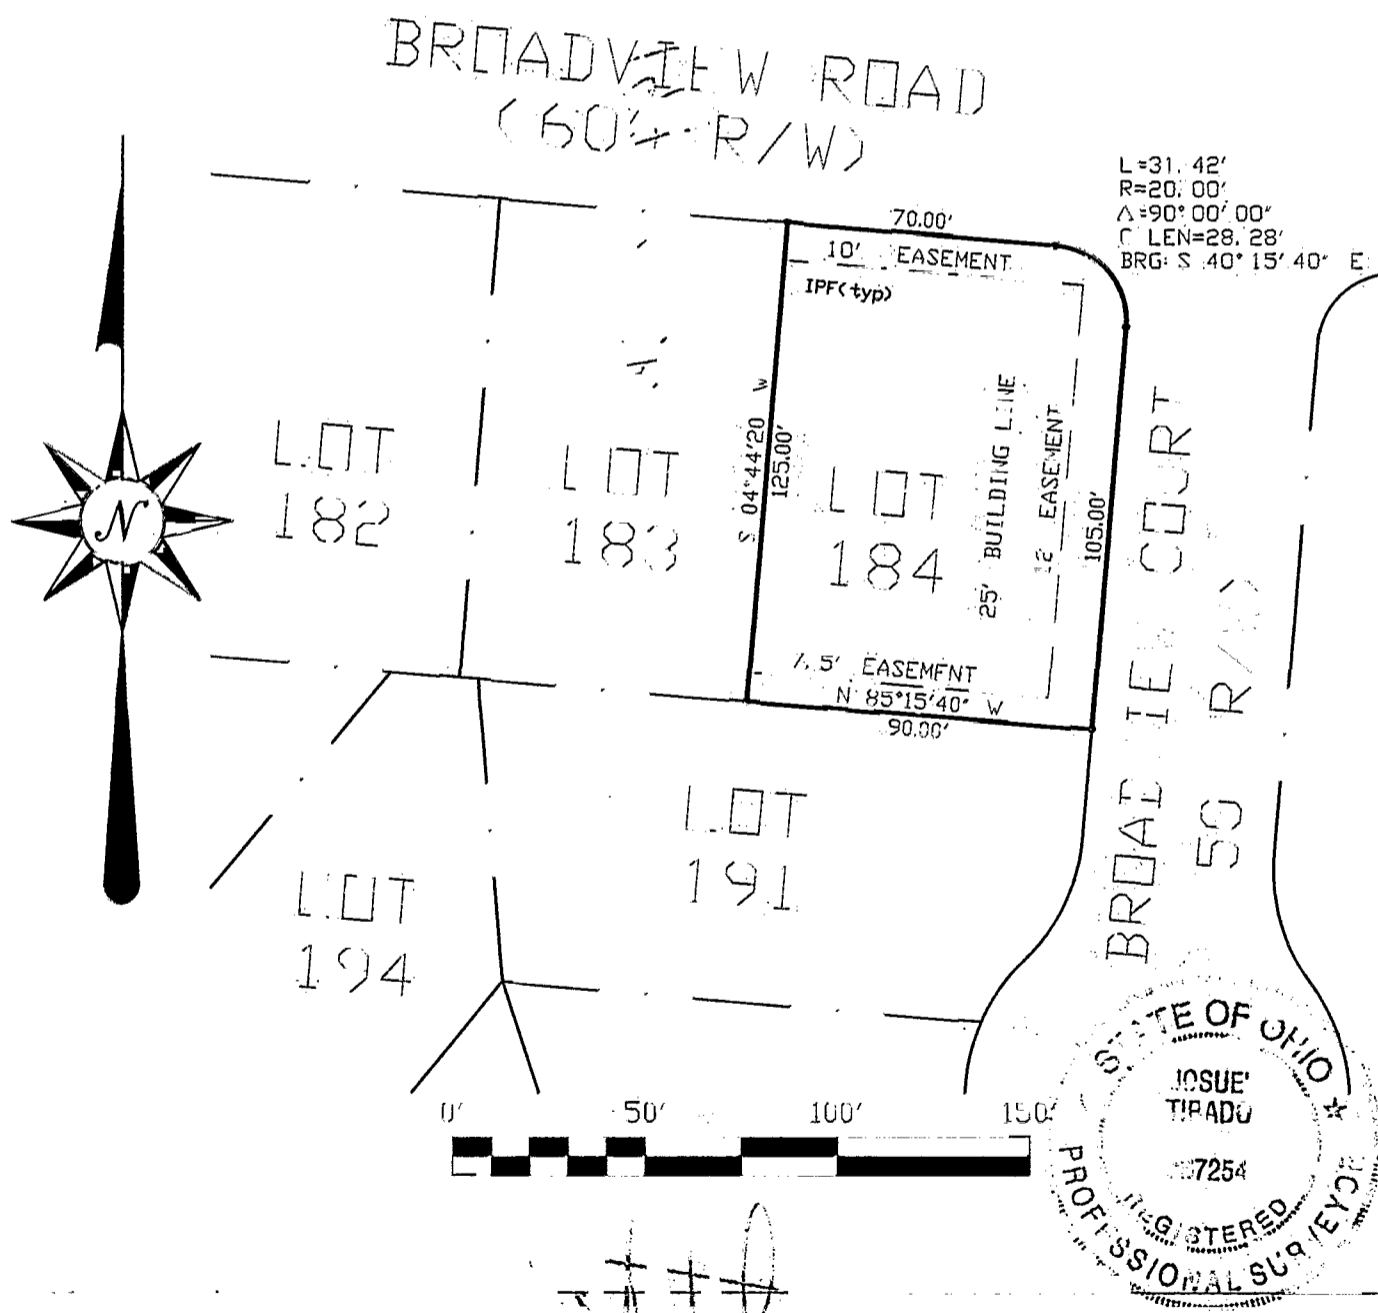

REGISTERED PROFESSIONAL SURVEYOR.

PROJECT: BROADVIEW ROAD

SUBJECT: BOUND.

SURVEYED BY JOSUE

DRAWN BY JCS

JOSUE TIRADO

JOB NO. 0164

REVISION DATE

CHECKED

No. 7254

DATE: SEPTEMBER 19, 2001

A TO Z

SURVEYING AND INFORMATION CO.
THE SOLUTION TO YOUR SURVEYING NEEDS

M-194-BBBB
Col. WEST