


796 24/75
795 24/75

NORWICH TWP.
C-61-13B

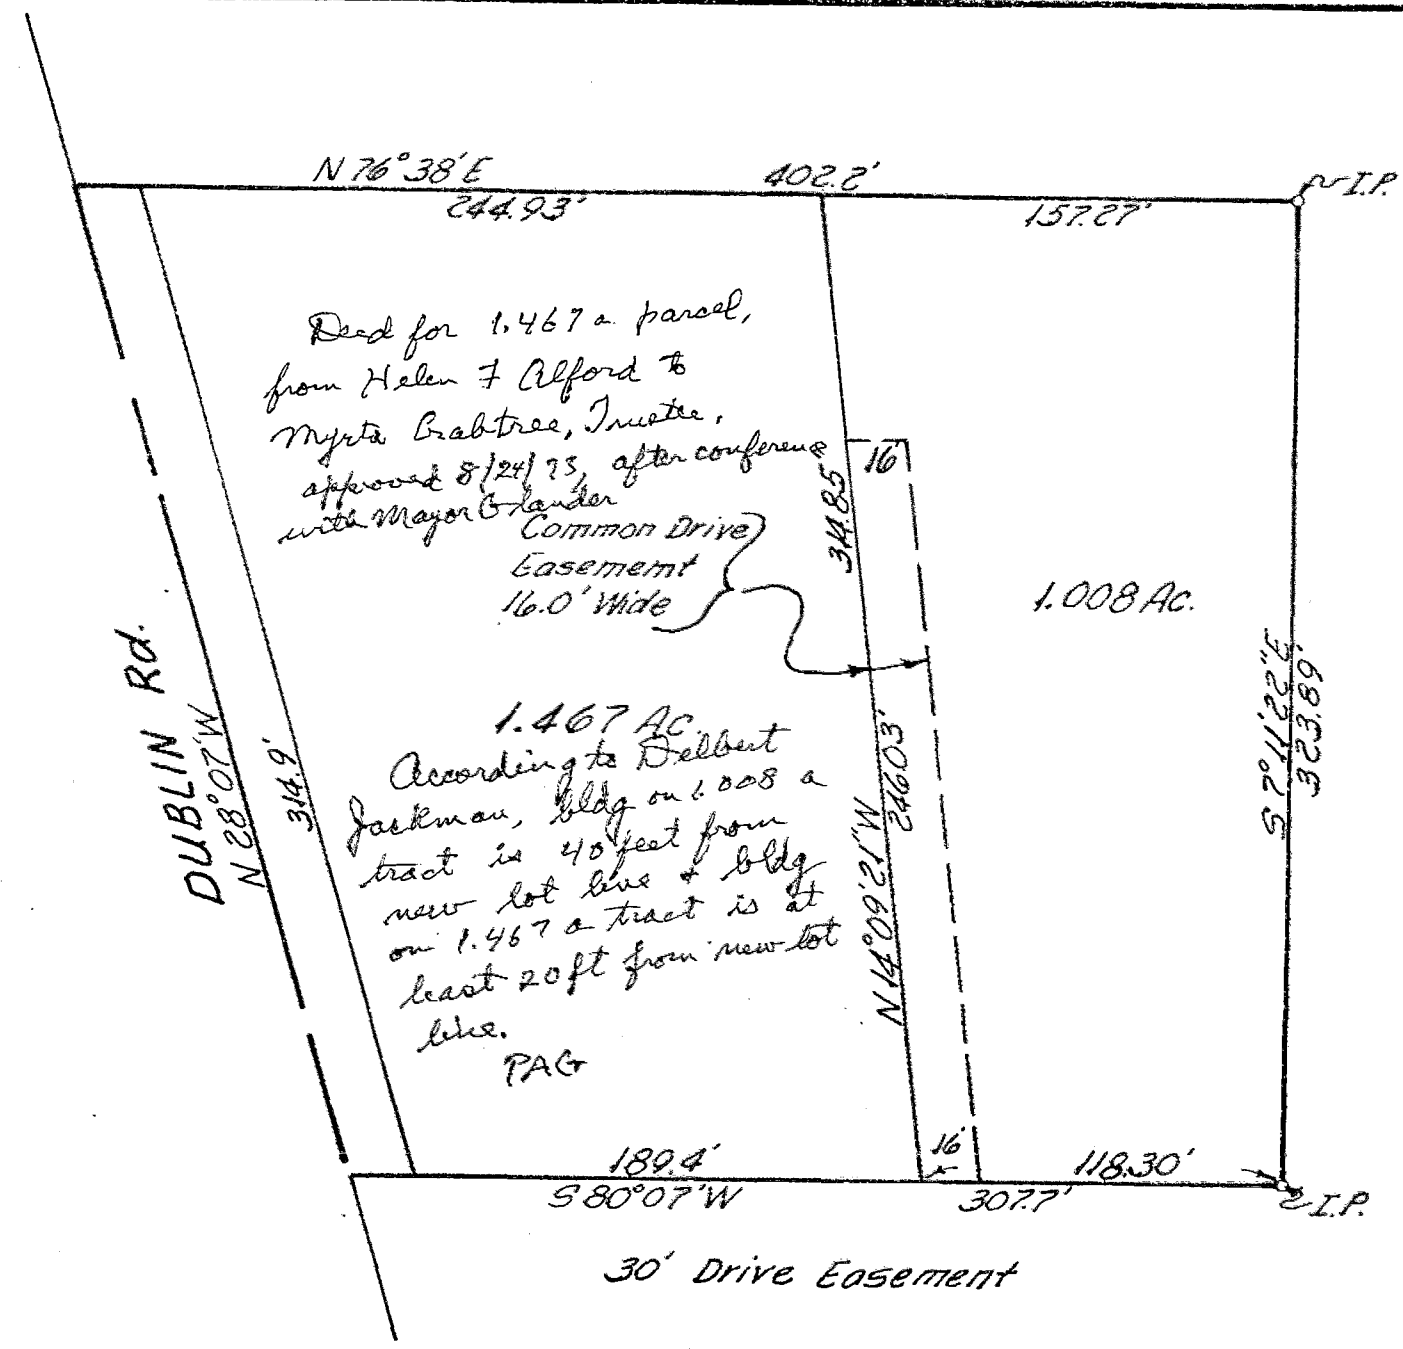

Survey of 1.008 and 1.467 AC Tracts
 Pt. Survey No. 4854
 Virginia Military Lands
 Norwich Twp., Franklin Co. Ohio
 For
KENT REALTY
 Scale 1"=60' July 1973
 The Jackman Company
 Civil Engineers & Surveyors
 Columbus, Ohio

By *[Signature]*
 Registered Surveyor No. 3346

[Signature]
 O-61-13B