


MID-OHIO DEVELOPMENT CORPORATION
CITY OF HILLIARD
FRANKLIN COUNTY
OHIO

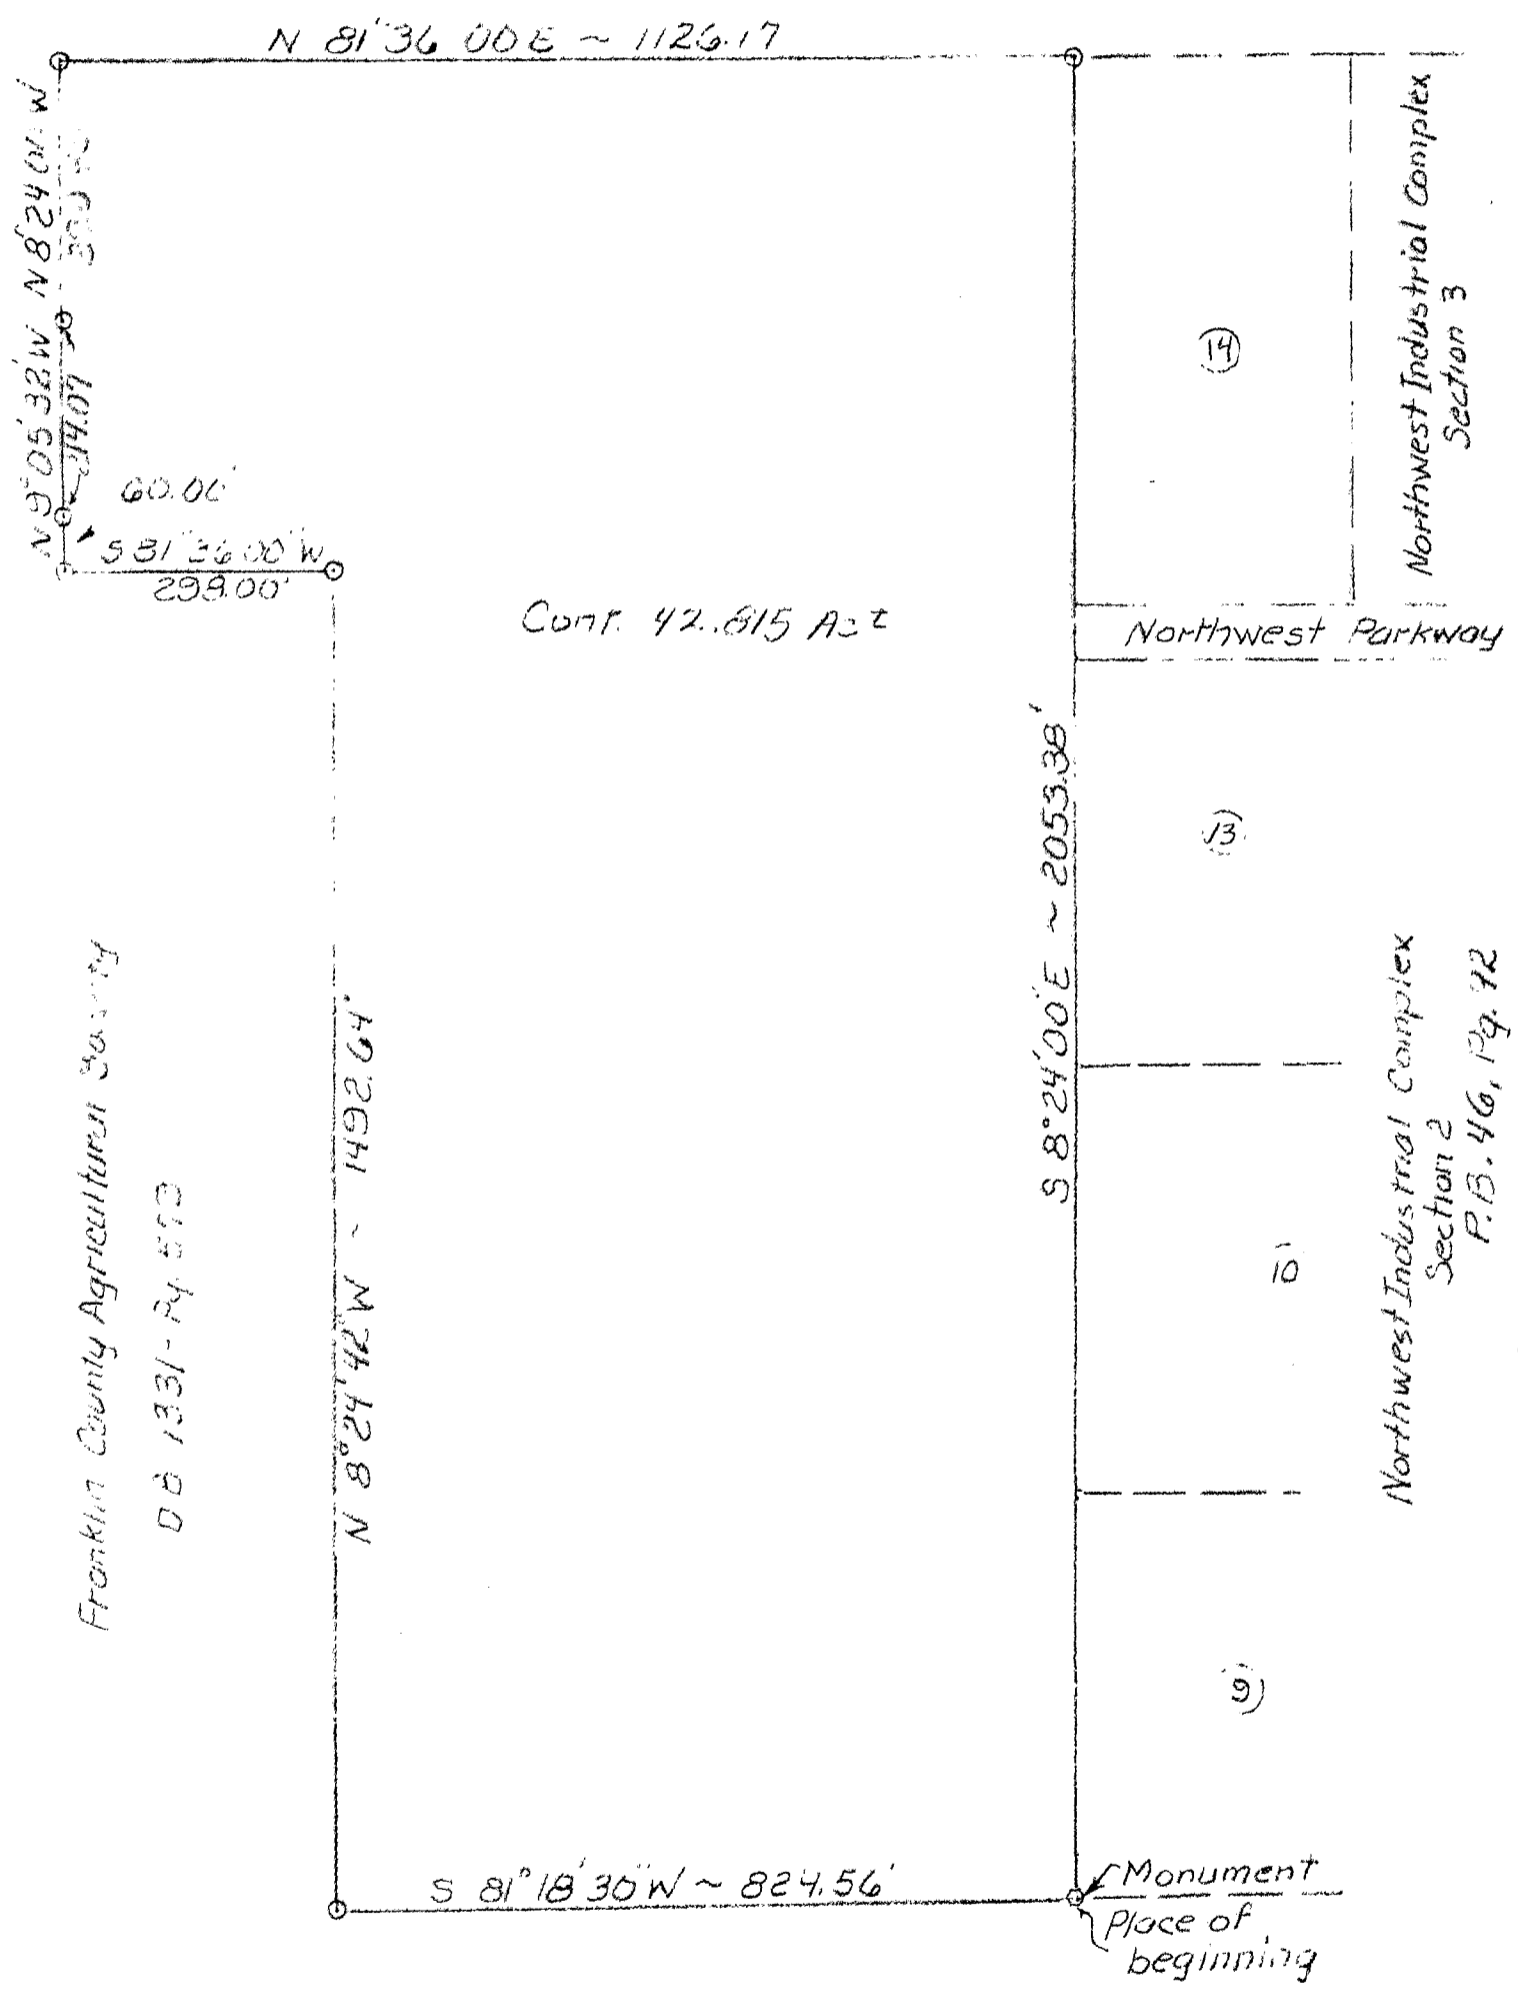

Scale
0 100' 200'



JOHNS, HENDERSON & ASSOCIATES, INC.
CONSULTING ENGINEERS
1849 GRANVILLE ROAD
NEWARK OHIO 43055

AREA CODE 614
344-8451

William B Henderson
Reg. Surveyor # 5242