Louis F Haines & Associates

354 Kessler Street
Groveport, Oh
Phone 836-55

SURVEY FOR

TOM & HELEN H CLURE

0-45

MADISON Twp

0-45

BEING 1.45 ACRES IN THE
S.E. ¼ SEC. 27, TWP. 1, R. 21,
MADISON TOWNSHIP, FRANKLIN COUNTY,
OHIO.

P.B. , Page

Franklin Co. Rec. Office

Scale 1" = 60'

DATE

0-45

0-45

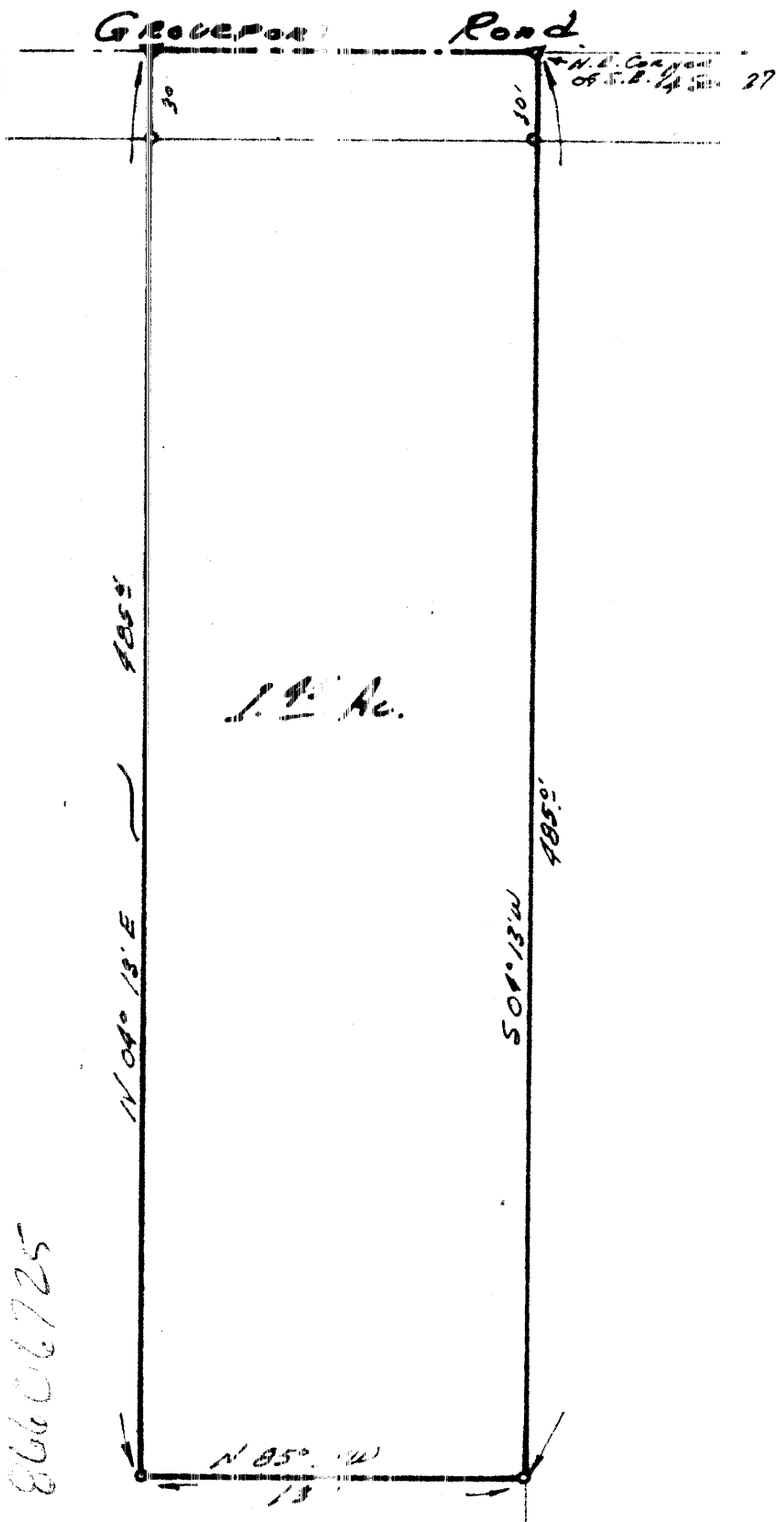

We hereby certify that the foregoing plat was prepared from an actual survey of the premises. No side line of principal building is less than dimension shown. Iron pins not set unless indicated thus —0— For Mortgage Loan & Title Insurance purposes only.

LOUIS F HAINES & ASSOCIATES

BY Louis F. Haines
Registered Surveyor

ORDER #

8606725