COMPTON GARNER & TOLBERT SURVEYING CO.

COLUMBUS, OHIO

SURVEY PLAT
TOWNSHIP 10, RANGE 21, SECTION 3, CONGRESS LANDS
MADISON TOWNSHIP, FRANKLIN COUNTY, OHIO

MARCH 1974

SCALE 1" = 50'

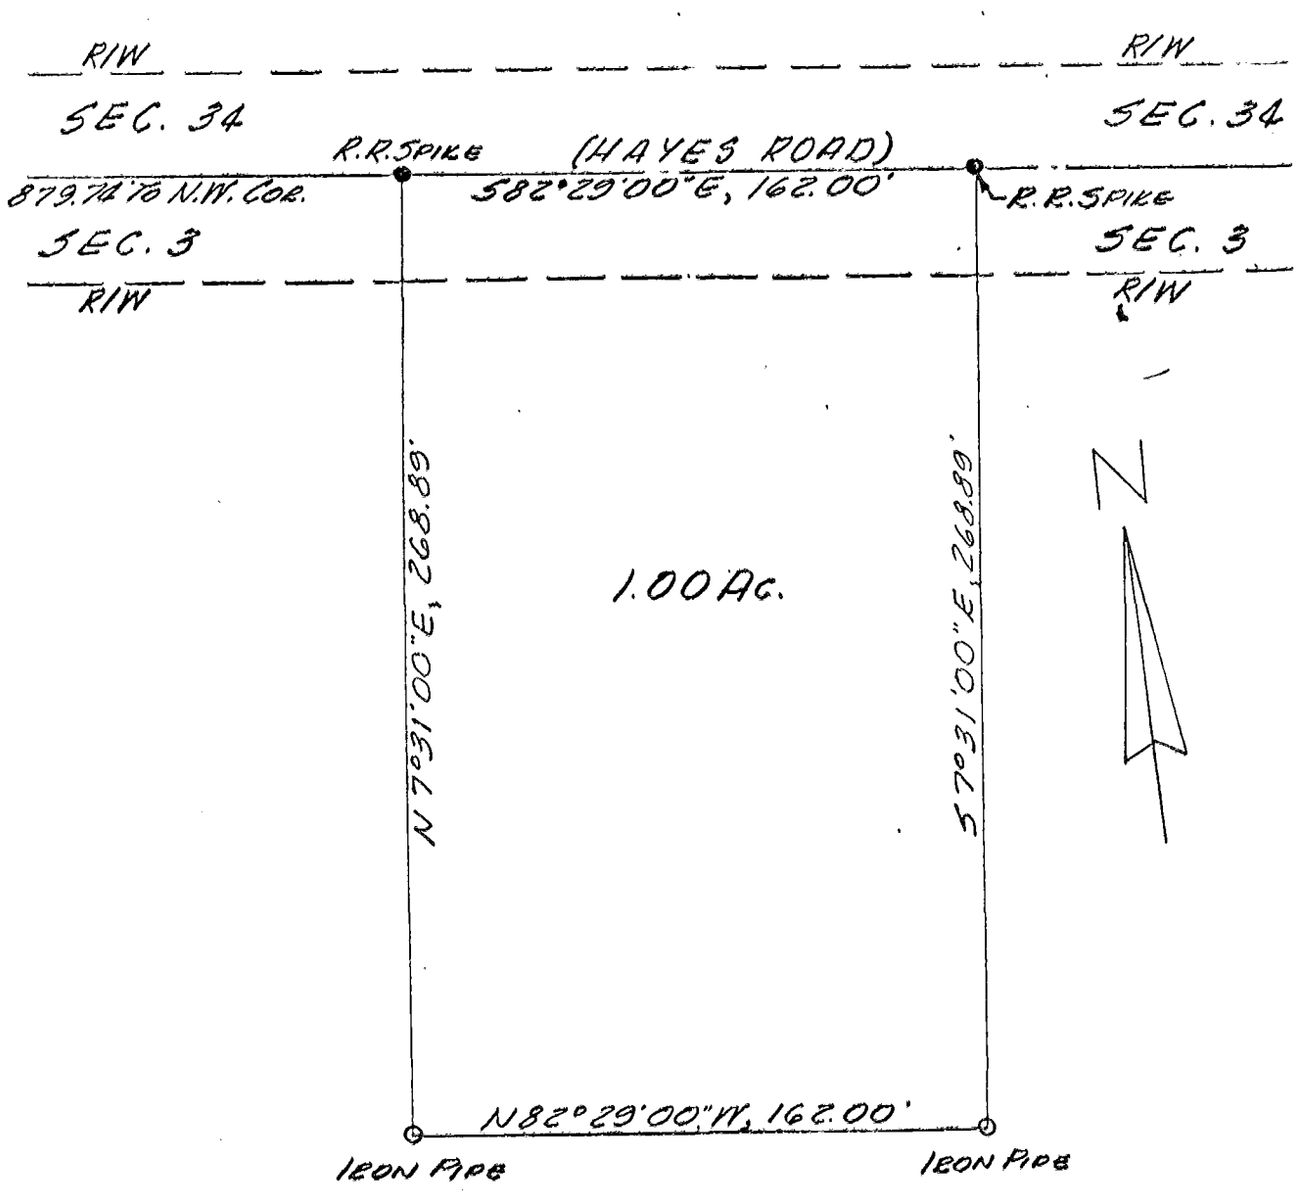

I hereby certify that the above plat was prepared from an actual survey.

Lewis M. Tolbert
Reg. Sur. #5727

3 0 4 8 5 1 9 7 4 1 1 1 1 1 0 6 1 5 HAYES ROAD 1 2 0 3 1 0 0