EVANS MECHWART HAMBLETON & TILTON

CIVIL ENGINEERS — SURVEYORS
GAHANNA, OHIO

SURVEY OF 6.243 Ac & 65 Ac

BEING THE WEST HALF OF THE N. W. QUARTER
SEC. 2. TWP. 10, R. 21, MATHEWS SURVEY,
MADISON TWP. FRANKLIN CO., OHIO.

SCALE 1"=300'
July 23, 1959

● = iron pin found
○ = iron pin set

DEED BOOK _____,
PLAT BOOK _____,

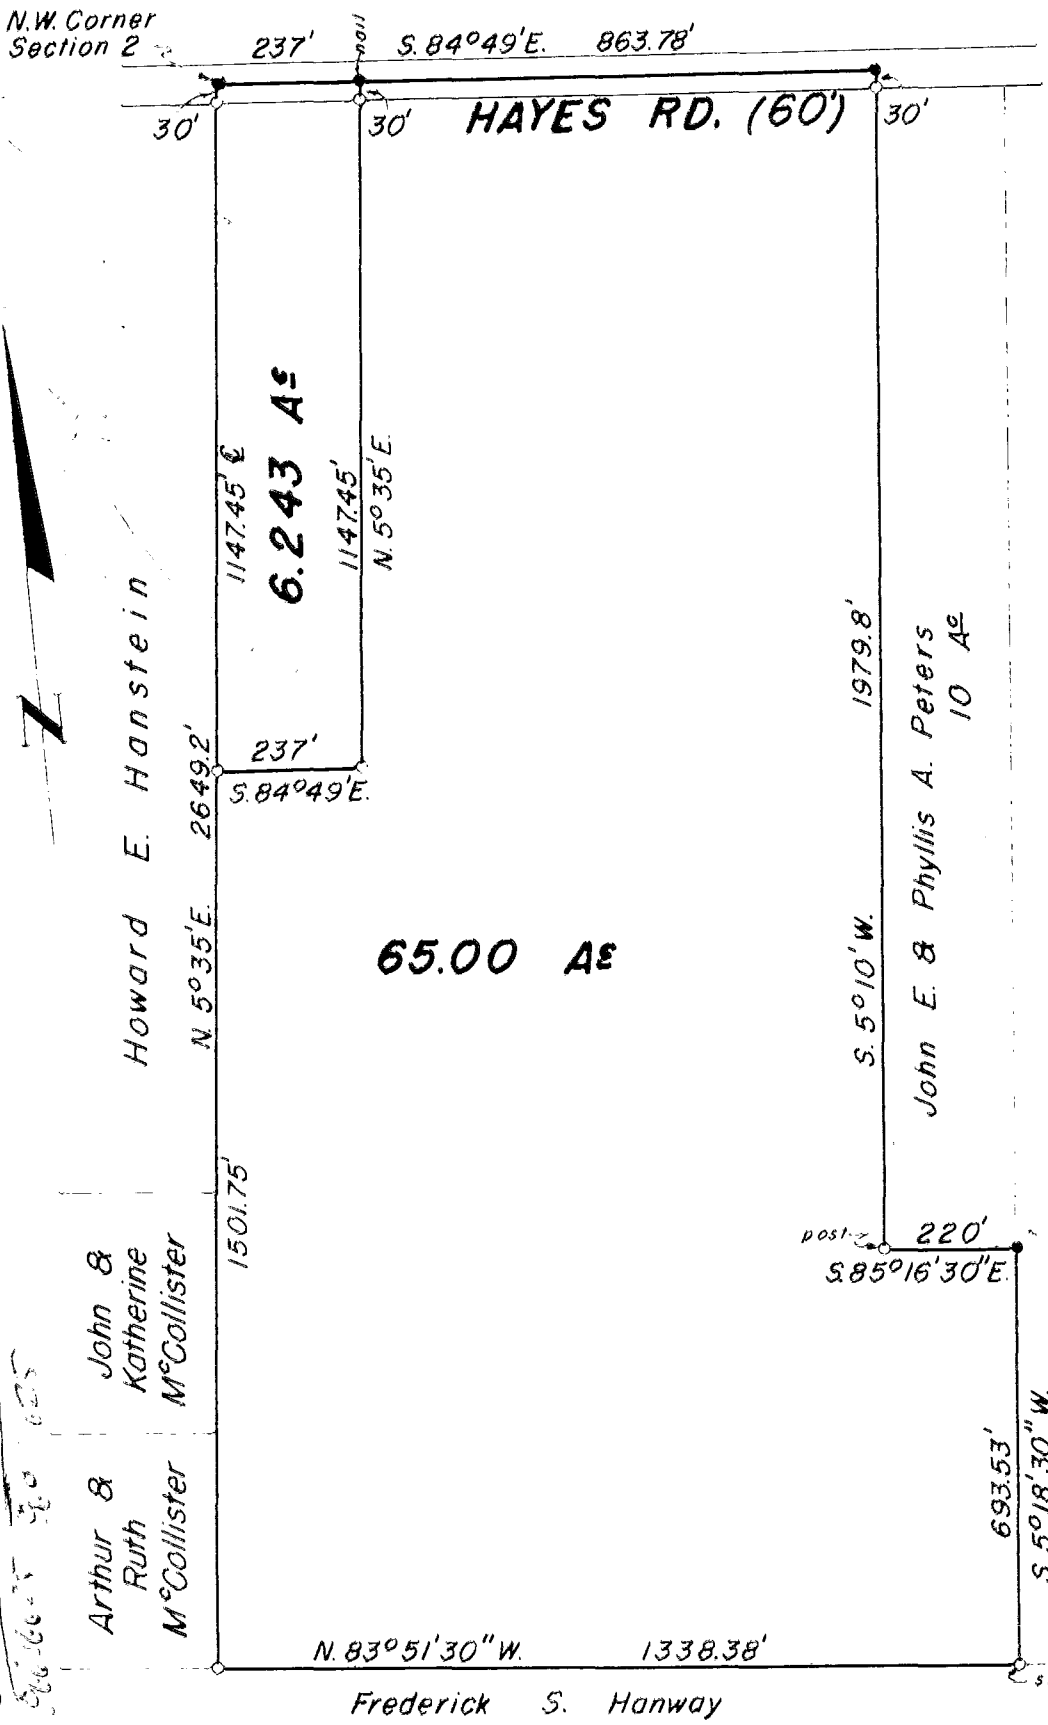

We hereby certify that the foregoing plat was prepared from an actual survey of the premises and shows the location of the boundaries.

EVANS MECHWART HAMBLETON & TILTON

BY _____
Registered Surveyor # 483

10418 -59-2341