



MADISON Twp

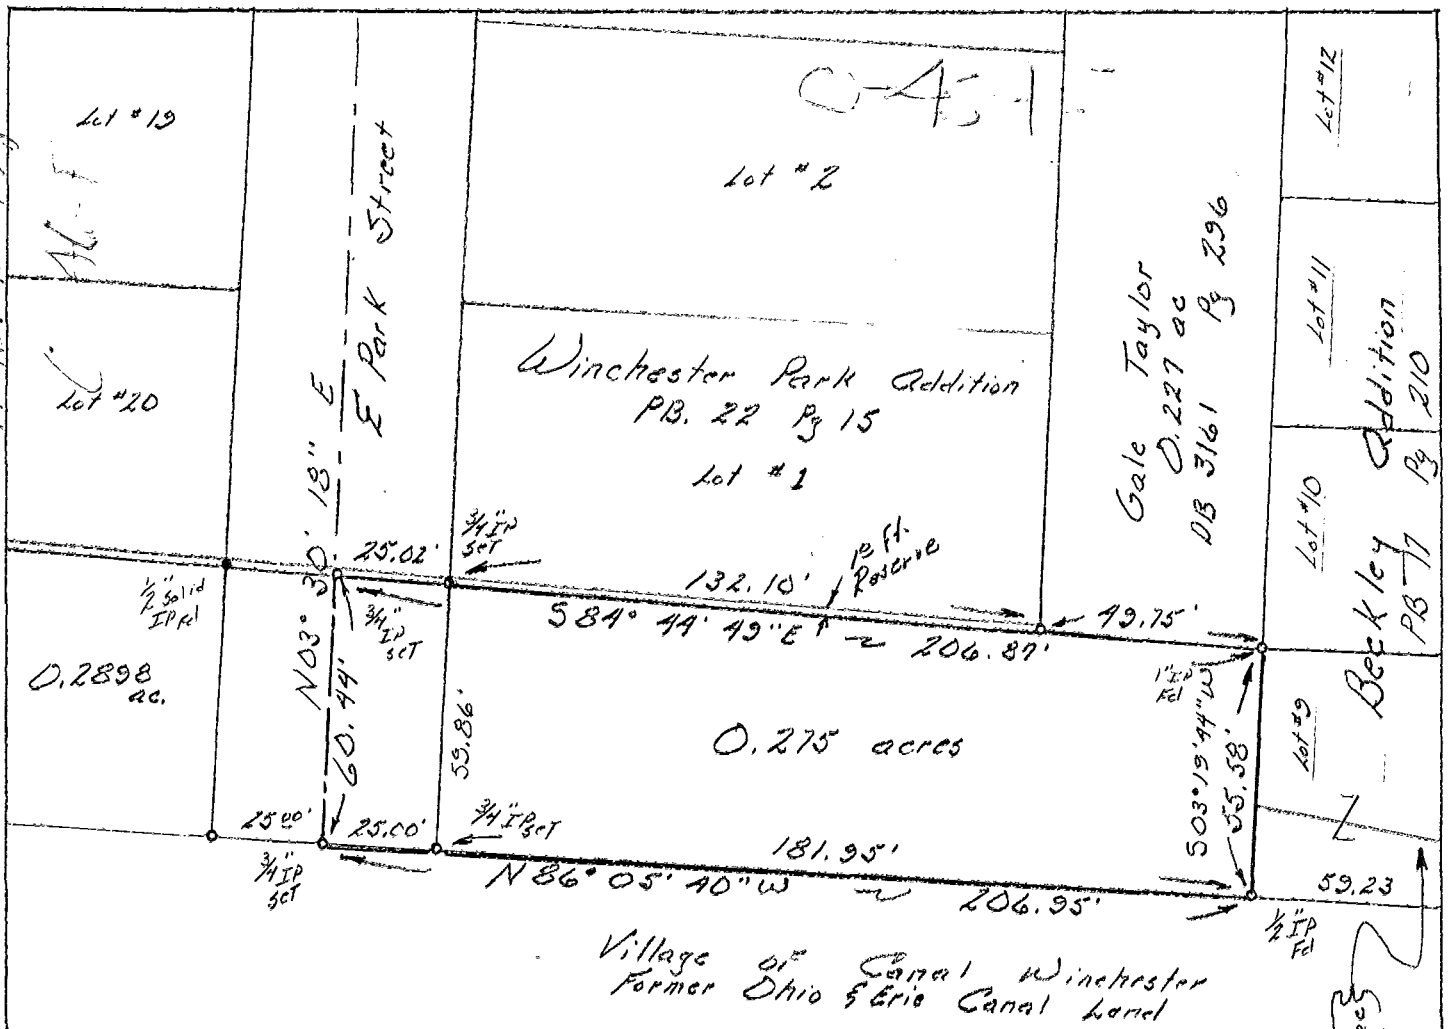

Village of Canal Winchester
Former Ohio Erie Canal Land


Survey of 0.275 acres
of the old Scioto Valley Traction R/w
in the Village of Canal Winchester,
Franklin County, Ohio.

Robert Ward

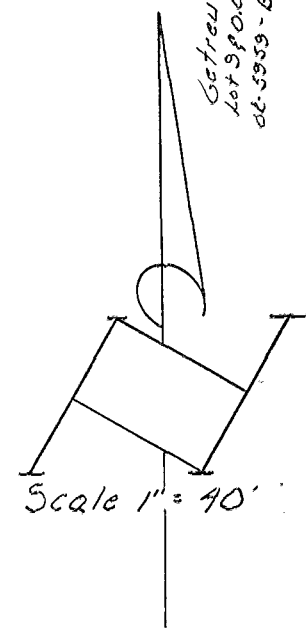

Louis F Haines

354 Kessler Street
Groveport, Ohio 43125
Phone 837-2181

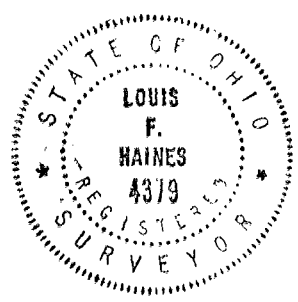

I HEREBY CERTIFY THE PLAT SHOWN HEREON
IS CORRECT AS SURVEYED BY US.
DATE: November 15, 1985
SIGNED: Louis F. Haines

9785700