

INDIANA RAILROAD (FORMERLY C&O R.R.)

590°00'00"W 353.10'

50°00'00"E 49.20'

50°10'01"E 387.49'

RICHARD E. GAYMAN  
D.R. 07931, D-04

RICHARD H. FISHER  
AND  
L.A. FISHER  
D.R. 9360, F-02

CARROLL E. CORNS  
AND  
KATHKYN E. CORNS  
D.B. 3747 PG. 331

POINT OF BEGINNING  
HENRY G. WENIG  
D.B. 3393 PG. 333

DLATHA E. BENSON  
D.B. 1428 PG. 263

GARY ROBERT STAMMLER  
AND  
ERNESTINE STAMMLER  
D.R. 00235, E-06

WILLIAM A. RAY  
AND  
CONNIE I. RAY  
D.R. 4463, B-16  
(0.375 AC.)

GAIL W. BURRIER  
D.R. 05110, J-18  
05111, A-01  
A-03

0.054  
ACRE TRACT

WILLIAM A. RAY and CONNIE I. RAY  
D.R. 11721 F-03  
(0.315 ac. ORIG.)

THE BASIS OF BEARINGS  
ARE TO AN ASSUMED  
MERIDIAN AND ARE USED  
TO DENOTE ANGLES ONLY.



FRANKLIN COUNTY  
FAIRFIELD COUNTY

POINT OF COMMENCING


TRINE STREET (50' R/W)

RICHARD E. GAYMAN  
D.R. 07931, D-04  
PARCEL NO. 2  
(10.815 AC. ORIG.)


LEGEND

- MONUMENT FOUND FRAN. CO. ENGR.
- 3/4" I.D. IRON PIPE FOUND
- 3/4" I.D. IRON PIPE SET
- ✱ 5/8" D.D. IRON PIPE FOUND
- ▽ POINT

Approved  
CANAL WINCHESTER  
PLANNING COMMISSION  
BY *J. Petrus*  
Zoning Officer  
9-5-89

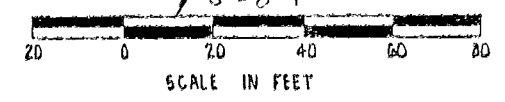

I HEREBY CERTIFY THAT THIS PLAT WAS PREPARED FROM AN ACTUAL FIELD SURVEY AND IS CORRECT TO THE BEST OF MY KNOWLEDGE.

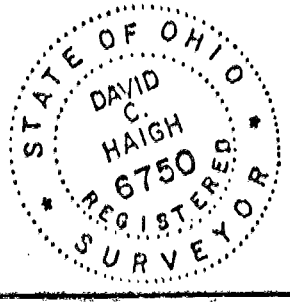

BY: *David C. Haigh*  
DAVID C. HAIGH  
REGISTERED SURVEYOR NO. 6750

SURVEY OF A 0.054 ACRE TRACT FOR WILLIAM A. RAY

SITUATED IN THE VILLAGE OF CANAL WINCHESTER, COUNTY OF FRANKLIN, THE STATE OF OHIO  
BEING A PART OF SECTION NO. 30, TOWNSHIP NO. 15, RANGE NO. 20.

SCALE: 1" = 40' REVISED: MARCH 31, 1989 (TRB)

15425567100

2-7