GARY W. LYONS AND JOAN S. DE LIBERA
LOCATION
MADISON TOWNSHIP - FRANKLIN COUNTY
RANGE 21, TOWNSHIP 10, SECTION 8

Scale 1"= 50 Date P.B. P. D.V. 3193 P. 680 Lot No.

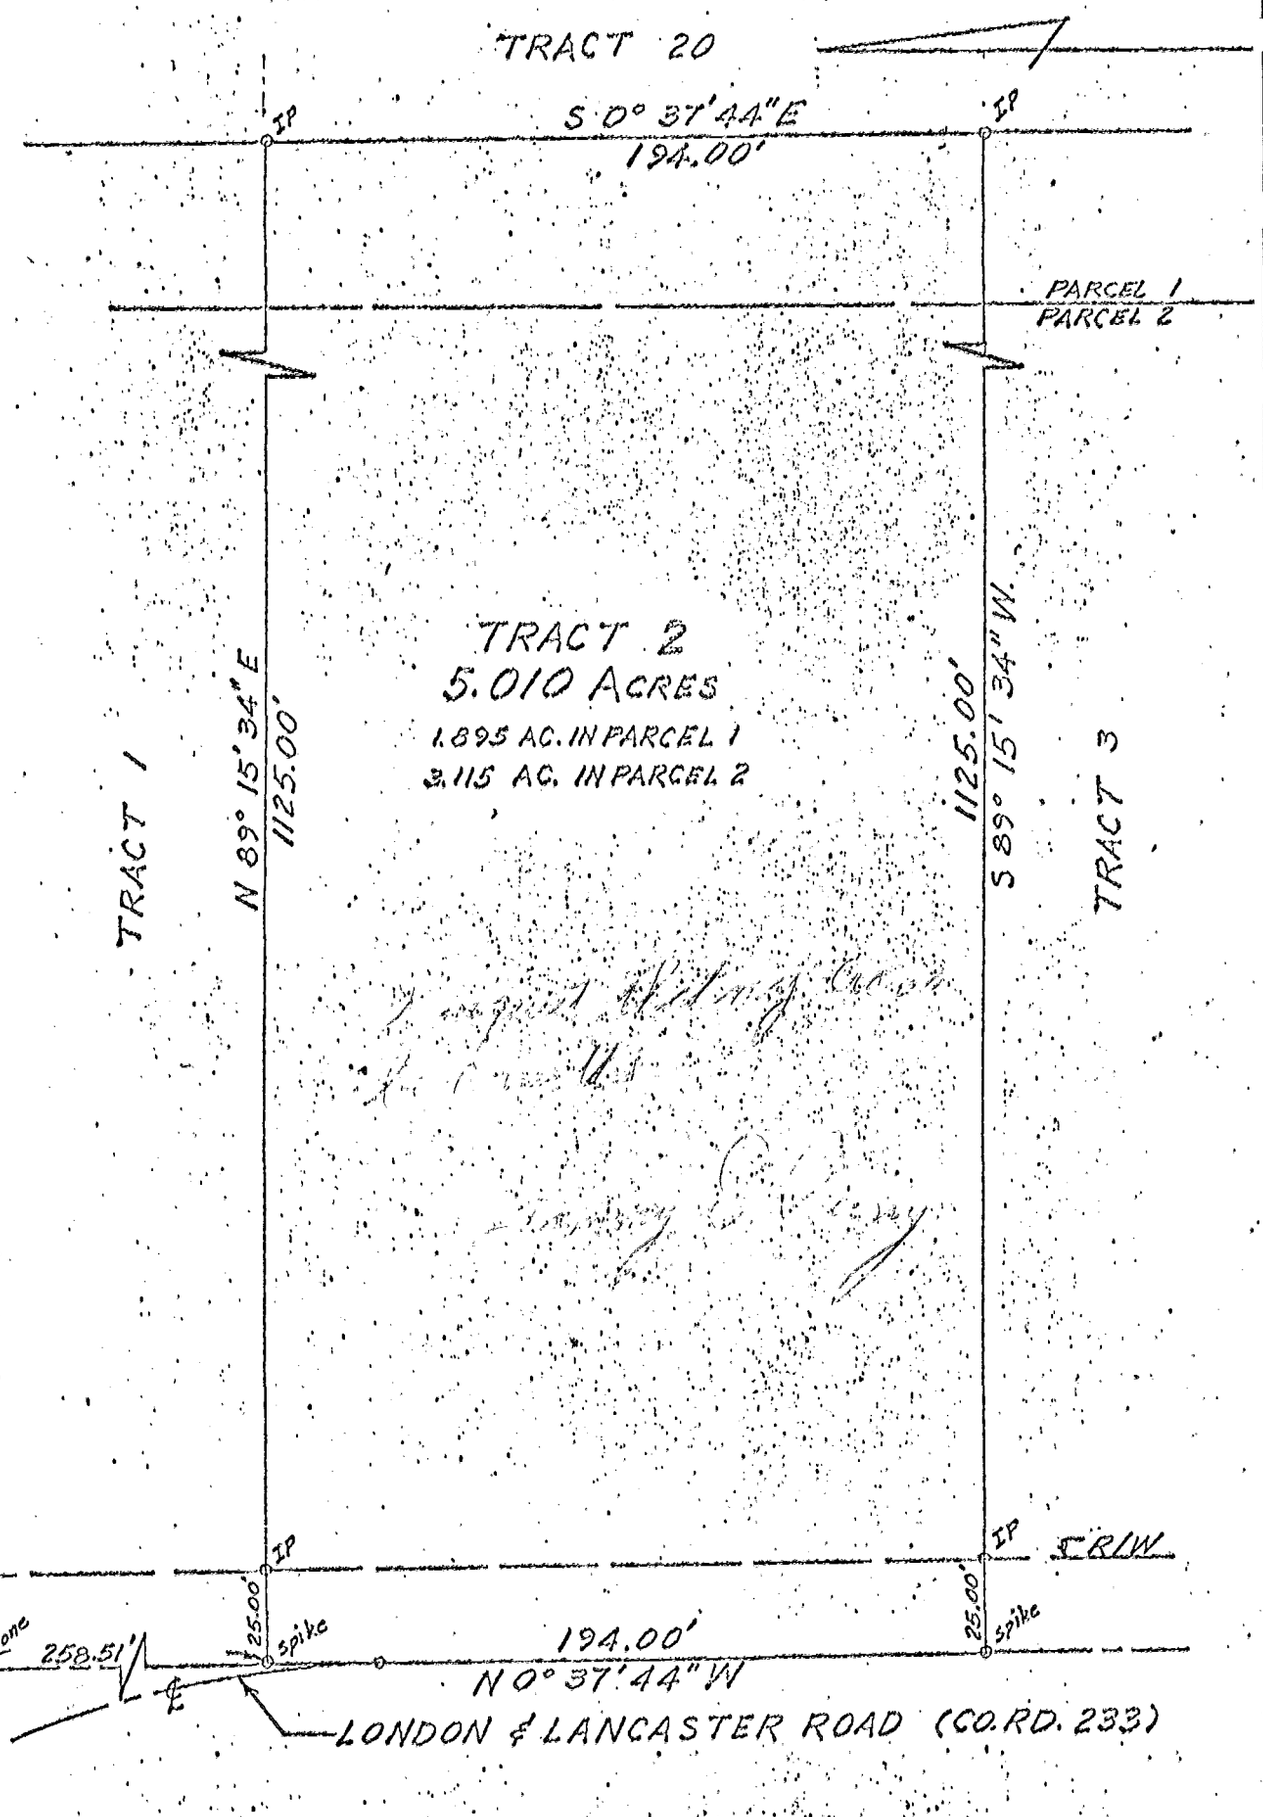

I hereby certify that the foregoing drawing was prepared from an actual survey of the premises.

Drawn by HRT

Henry L. Kuser
Registered Surveyor No. 5219

KUSER, GARTEN AND STRIGER, INC.
CIVIL ENGINEERS AND LAND SURVEYORS