

NANCY L. DOUGLAS
DONALD C. MILLER
105.4444 ACRES
INST#200103260060611

RAYMOND E. BAISE II
KIMBERLY A. FIELDS
4.23 ACRES
OR-21520-H-06

FRED A. BABITT
3.706 ACRES
DB-316 PG-395

EARL G. WATKINS
1/2 TRUST
2.55 ACRES
OR-34314-D-03

C/L LITTLE WALNUT CREEK

MADISON TWP.
FRANKLIN CO.

TRUSTEE'S
HOPEWELL
M.E. CHURCH
1.53 ACRES
DB-34 PG-350

MADISON TWP.
PICKAWAY CO.

BOUNDARY SURVEY OF A 0.4005 ACRE TRACT
IN THE SW 1/4 SEC-9, TWP-10, RGE-21.
MADISON TWP., FRANKLIN CO., OHIO:


FOR
TRUSTEES, HOPEWELL M.E. CHURCH




Louis F Haines

354 Kessler Street
Groveport, Ohio 43125
Phone 837-2181

I HEREBY CERTIFY THE PLAT SHOWN HEREON
IS CORRECT AS SURVEYED BY US.
DATE: December 26, 2001
SIGNED: Louis J. Haines

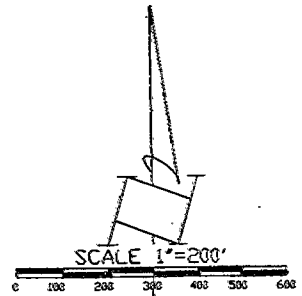

BASIS OF BEARINGS:
EAST PROPERTY LINE OF THE
HOPEWELL CHURCH 1.53 ACRE TRACT
DB-34 PG-350, AS N 39°45'W FROM
THAT DEED.

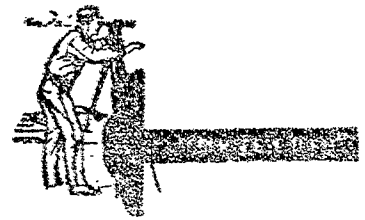

MADISON Twp.

0-57-A

85606550