



86356625

MADISON Twp?

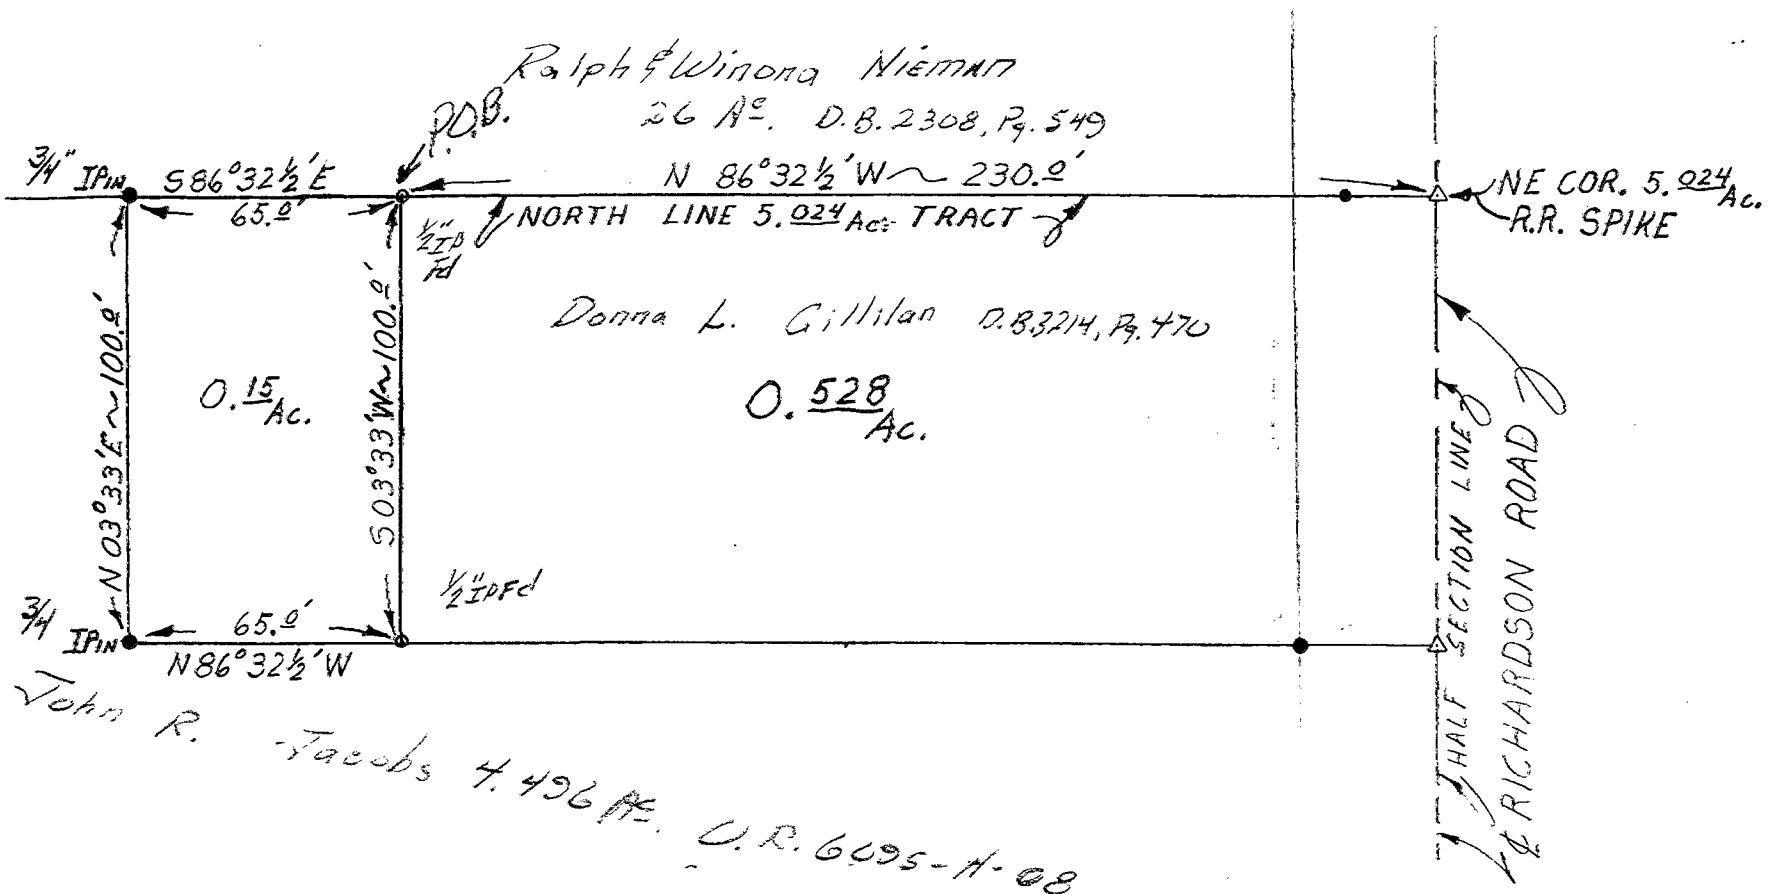


Note:  
BEARINGS ARE  
ASSUMED AND  
RELATIVE ONLY TO  
THIS SURVEY.

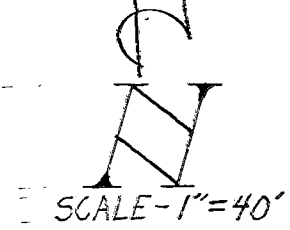

John R. Jacobs 4.496 A. U.R. 6095-A-08


SURVEY OF 0.15 ACRES  
in the NW 1/4, Sec. 3, Twp. 10, Rge. 21,  
Madison Twp., Franklin Co.,  
Ohio: For

Donna Gillilan

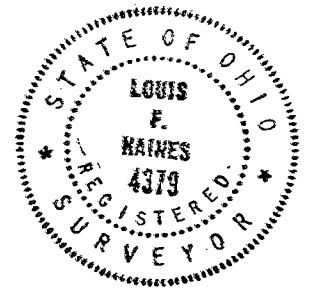

**Louis F Haines**  
354 Kessler Street  
Groveport, Ohio

I HEREBY CERTIFY THE PLAT SHOWN HEREON  
IS CORRECT AS SURVEYED BY US.  
DATE: Jan. 4, 1991  
SIGNED: Louis F. Haines

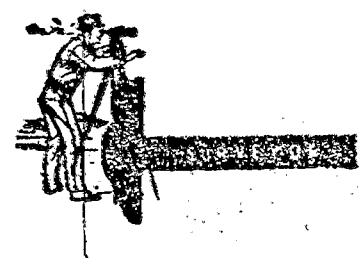

**Louis F Haines**

354 Kessler Street  
Groveport, Ohio 43125  
Phone 837-2181

96-496