


SCALE 1" = 100'



○ = IRON PIN

DECEMBER 9, 1991

RECORD REFERENCES D.B. 2977, Pg. 319

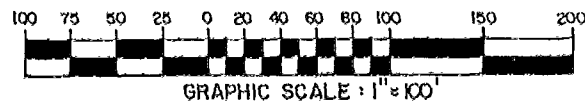

BASIS OF BEARINGS: The bearings are based on the same meridian as the bearing shown along the centerline of Hayes Road being South 89°04'40" East.

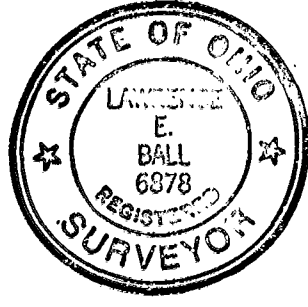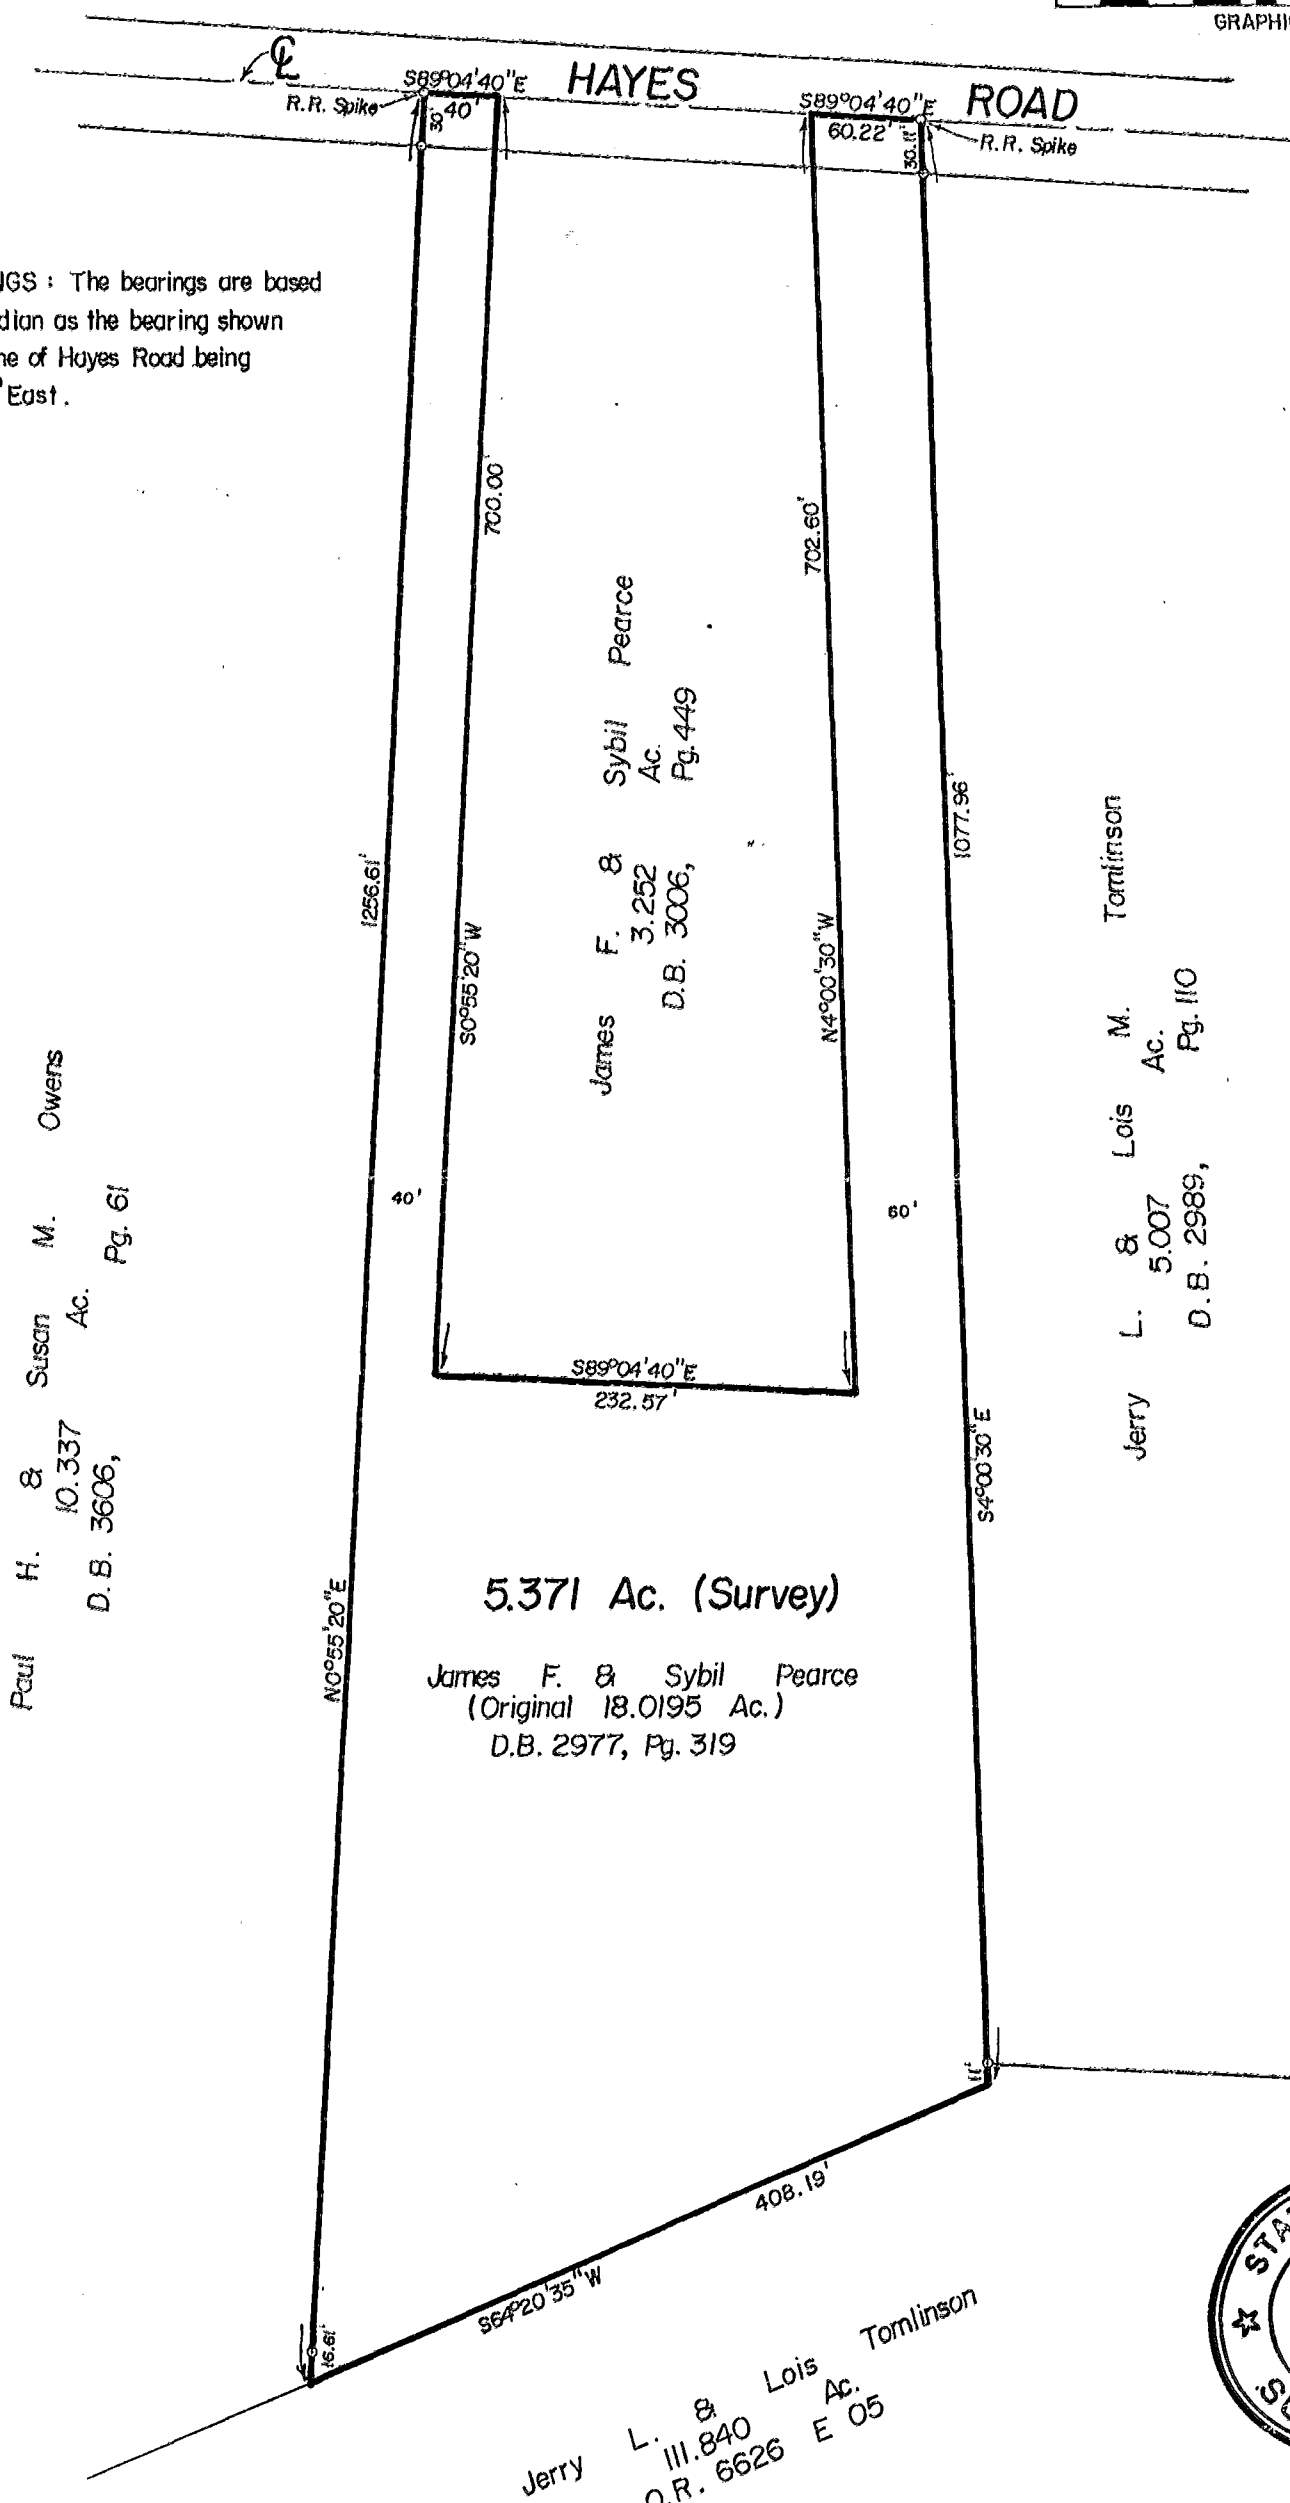

E.M.H.&T. INC.

By *[Signature]*
 Professional Surveyor No. 6878