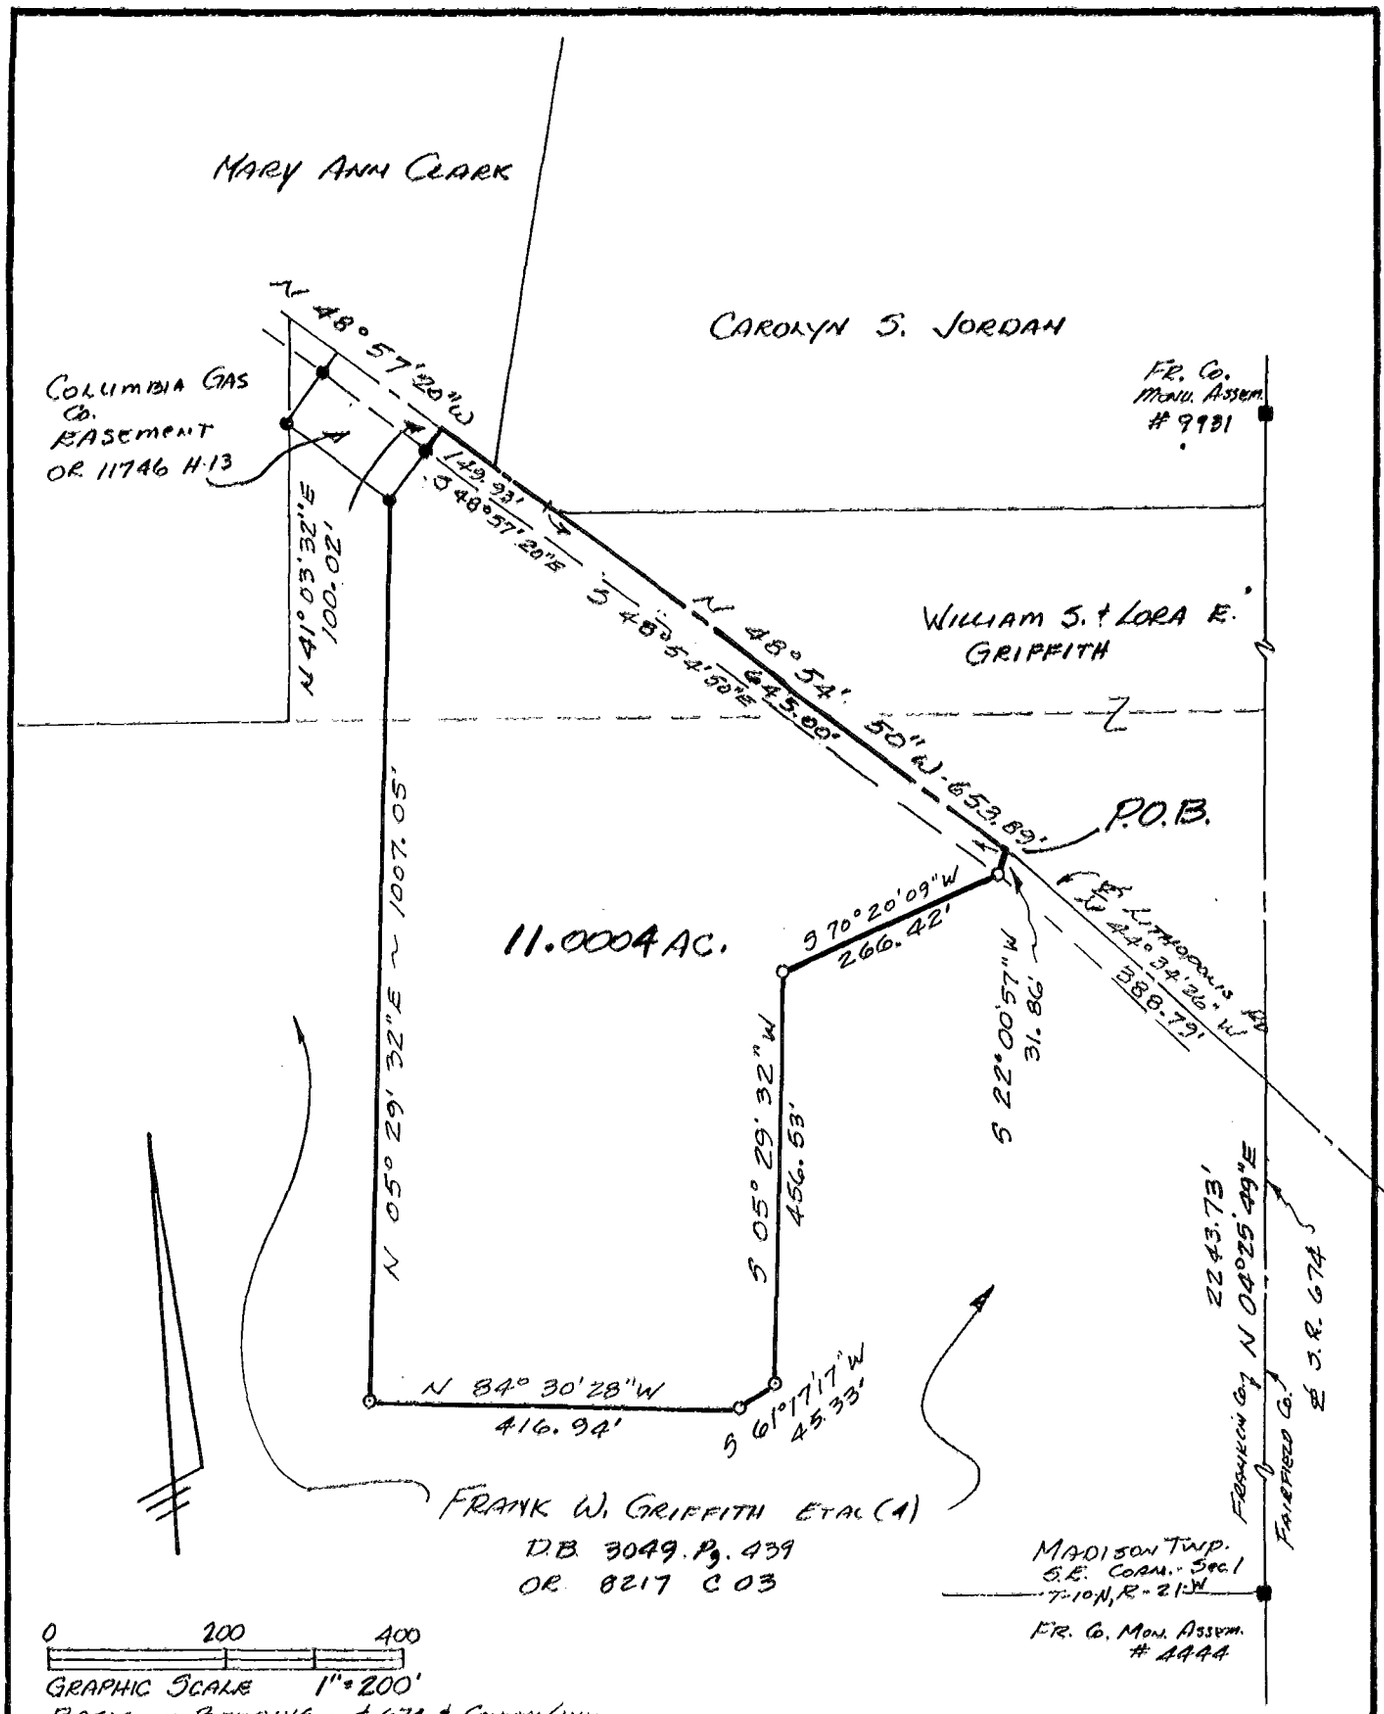

TO ALL PARTIES INTERESTED IN TITLE TO THE PREMISES SURVEYED:

I do hereby certify that this is a true and accurate survey made by me or under my supervision, and that all points are as called, and there are no encroachments either way across any line except as shown.

P.S. # 6814 Larry B. Felts

LEGEND

- ● .... Iron Pin Found
- ○ .... Iron Pin Set With Plastic I.D. Cap
- △ .... P.K. Nail or Spike

PLAT OF SURVEY - 11.0004 Ac.

NE ¼ SE Qtr. Sec. 1, T-10-N, R-21-W, Congress Lands, Madison Twp. Franklin Co, Ohio

FOR: BILL GRIFFITH

STATE OF OHIO LARRY BRANTON FELTS S-6814 REGISTERED SURVEYOR

D.B. 3049 Pg. 439	
OR 8217 C 03	
Scale: 1" = 200'	
Date: 10-27-95	
Drawn By: LBF	

AHLERS, MOE & ASSOC., INC.
Engineering & Surveying
360 W. Waterloo St.—P.O. Box 2
Canal Winchester, Ohio 43110 837-1178

Job No. 95-2220

MADISON TWP. T-10-N R-21-W

87946 C03

KEY BLUE PRINT CO. N-48676