


MADISON TWP.

0-52-A

0-52-A


Concrete Monument
NE cor
NE 1/4
Sec. 11

Virgil G. Harrison
130.89 ac.
DB 1688 Pg 237

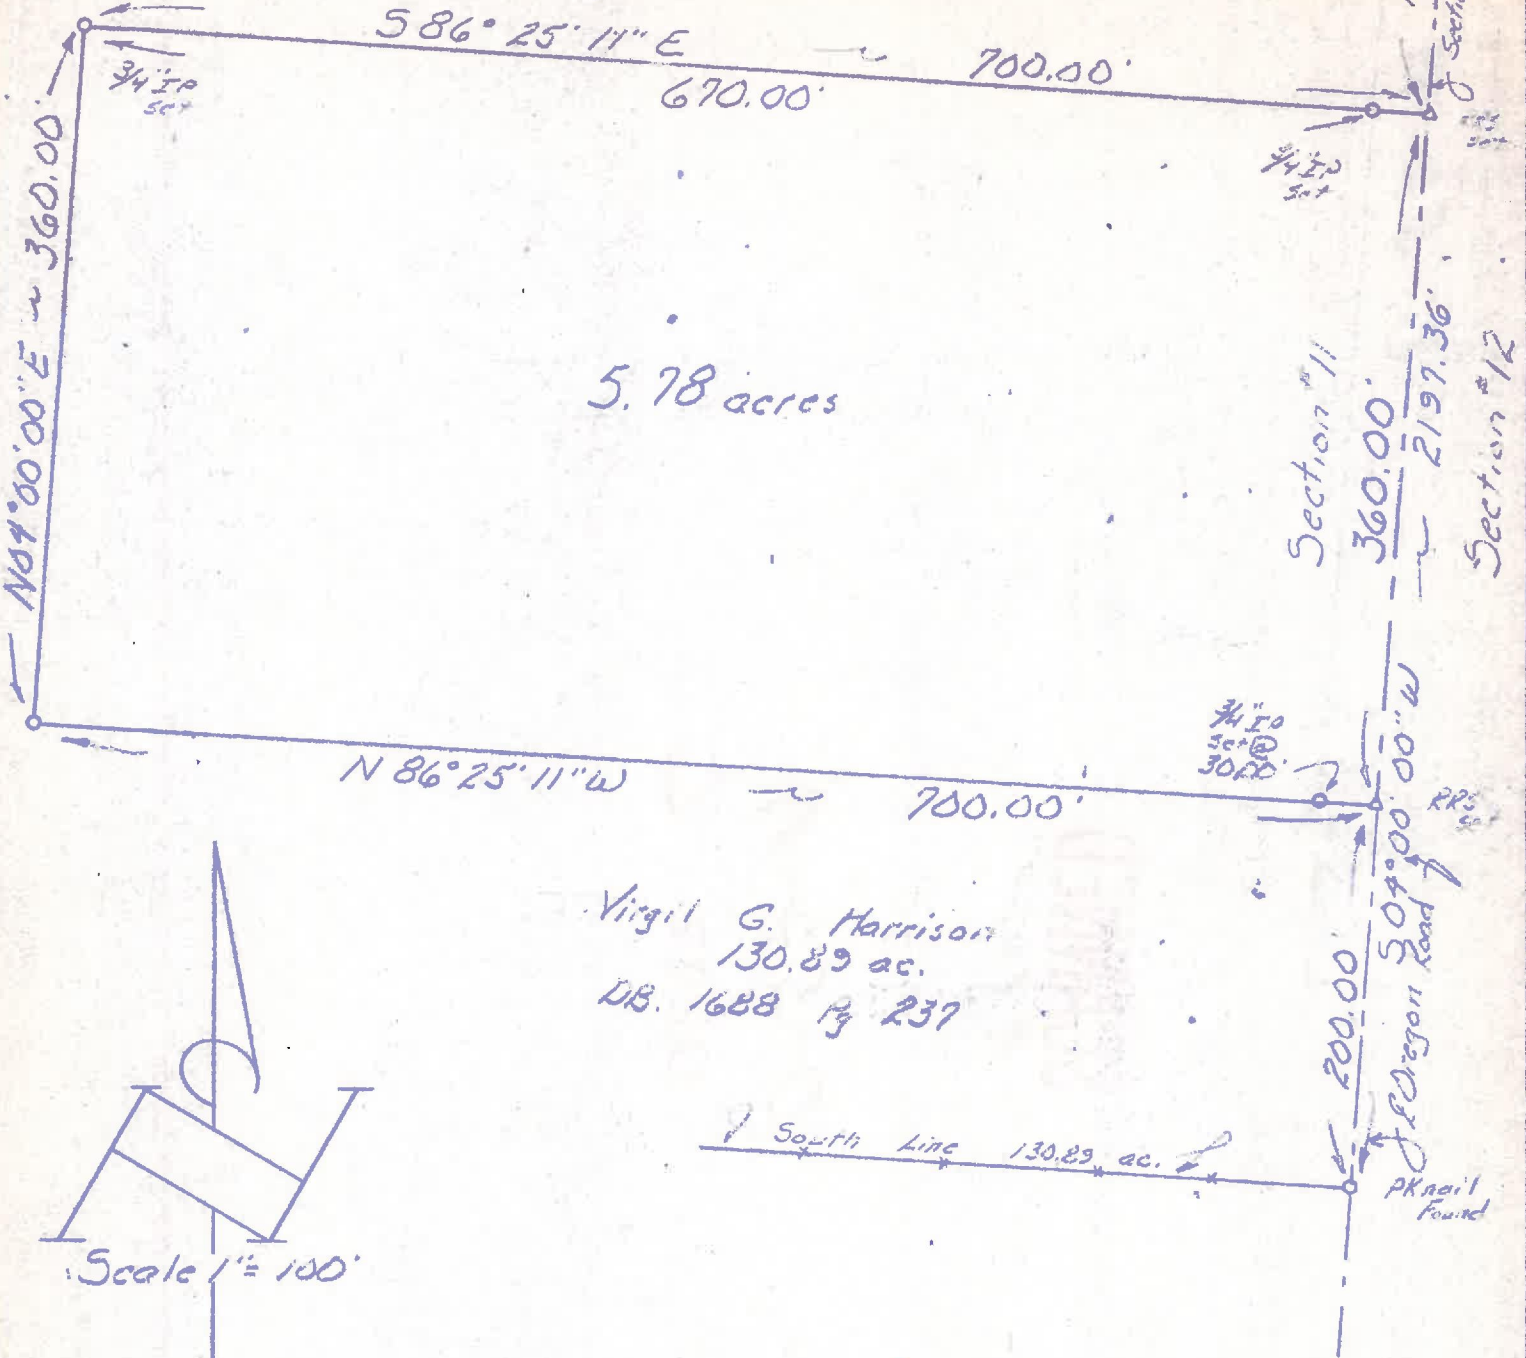

5.78 acres

Virgil G. Harrison
130.89 ac.
DB. 1688 Pg 237

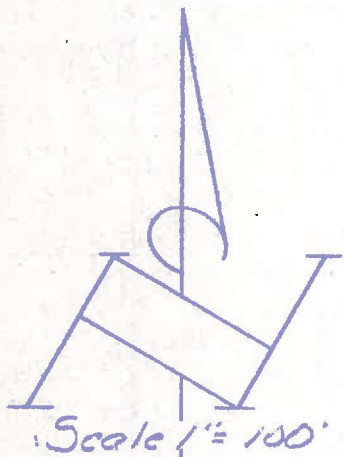

Survey of 5.78 acres
in the NE 1/4 section #11, Township 10.
Madison Twp., Franklin Co.,
Ohio: for

Virgil Harrison

Louis F Haines

354 Kessler Street
Groveport, Ohio 48125
Phone 837-2181



I HEREBY CERTIFY THE PLAT SHOWN HEREON
IS CORRECT AS SURVEYED BY US.
DATE: December 2, 1984
SIGNED: Louis F. Haines

87106575