


PART OF LOT NO. 4
CHARLES F. LAMB'S SUBDIVISION
P.B. 19, PG. 46

O-46-E
MADISON Twp

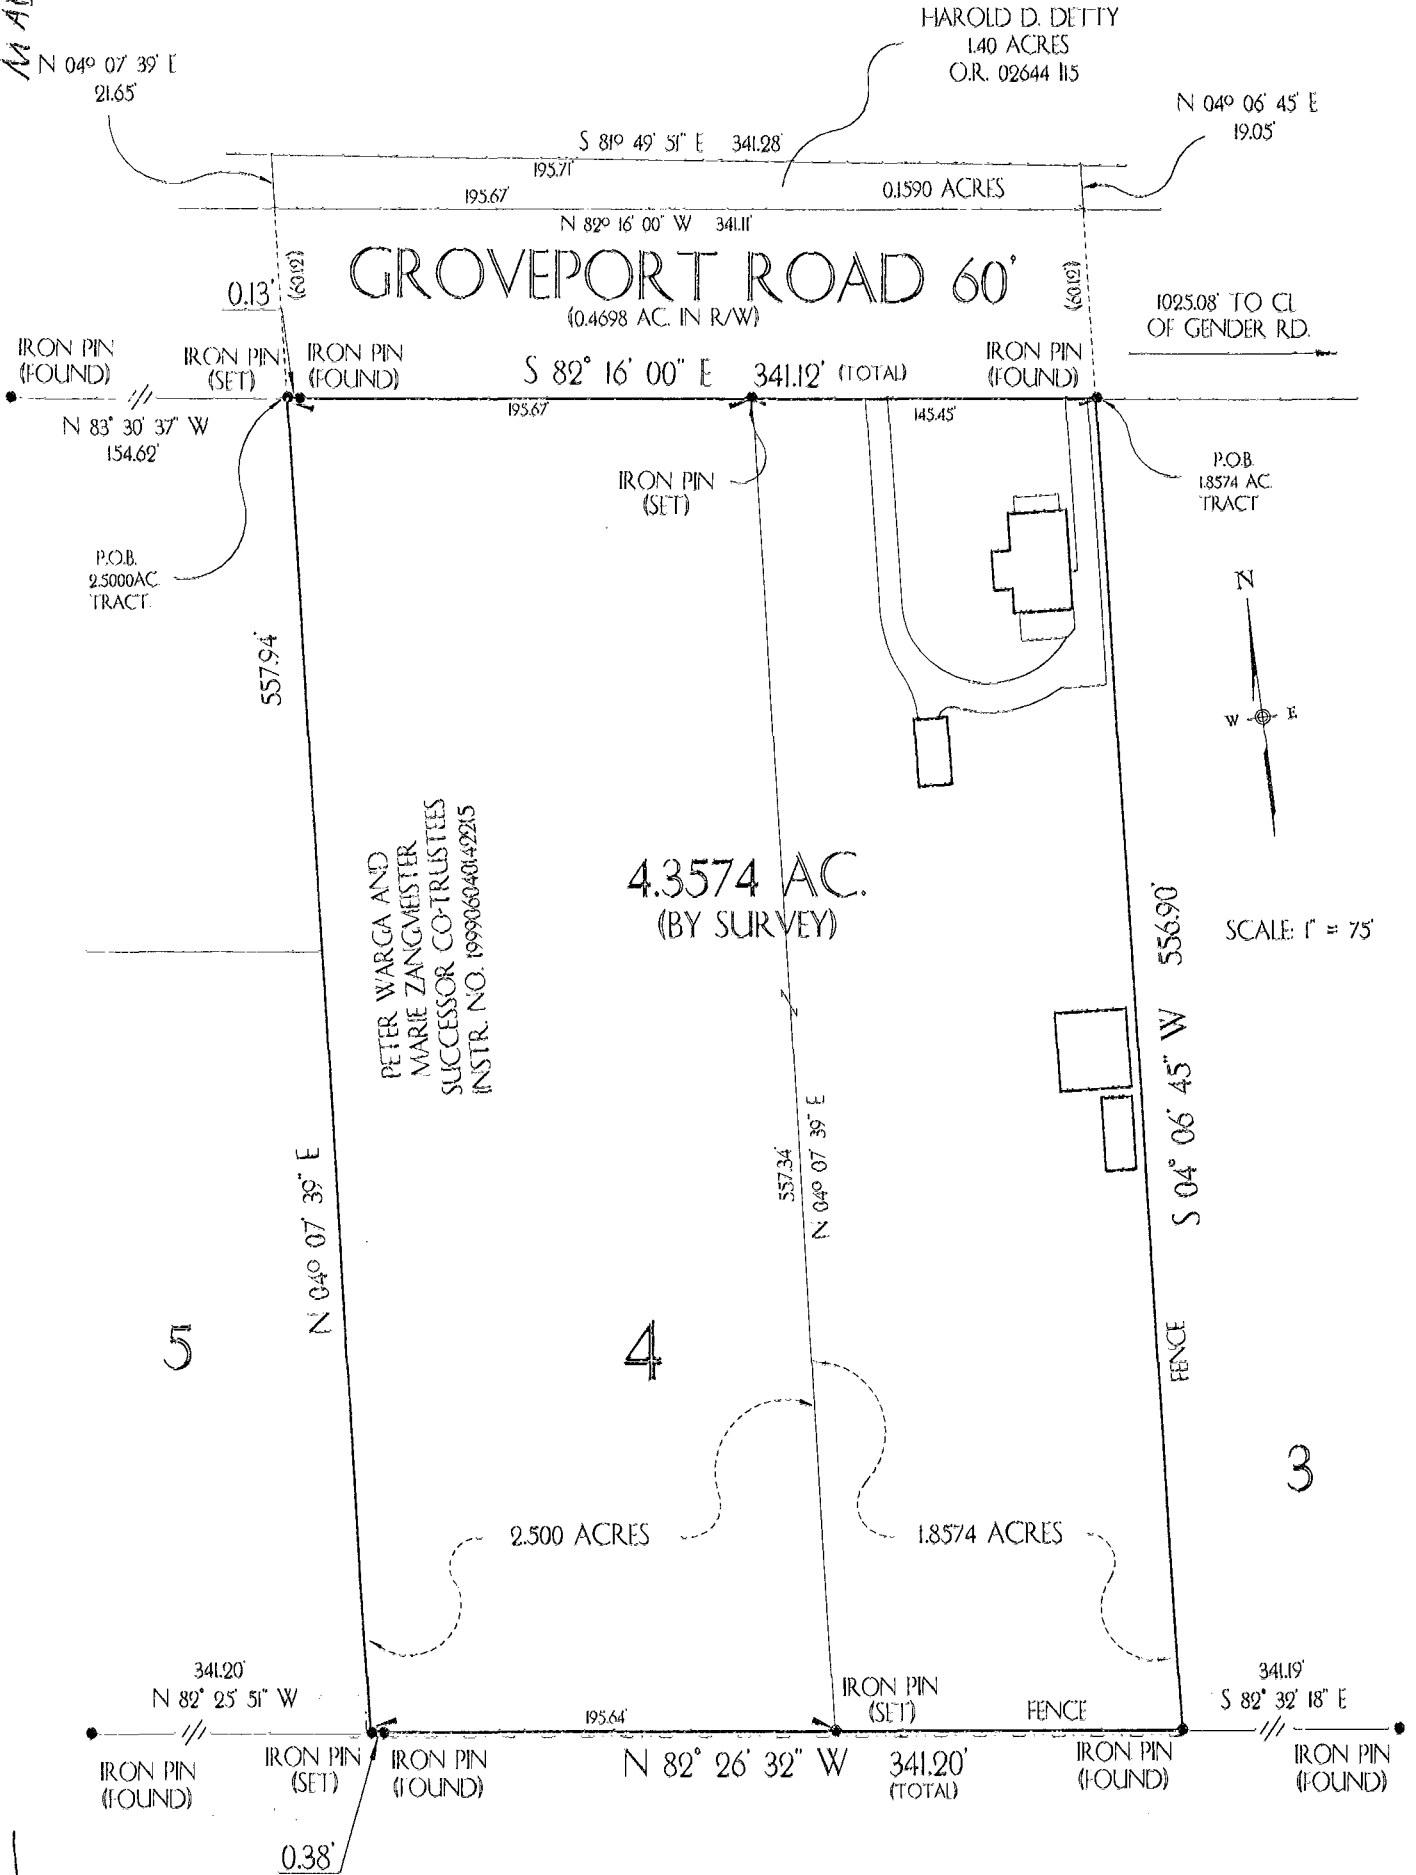

87356725
87356700