


0-109-B

0-109-B

0-109-B

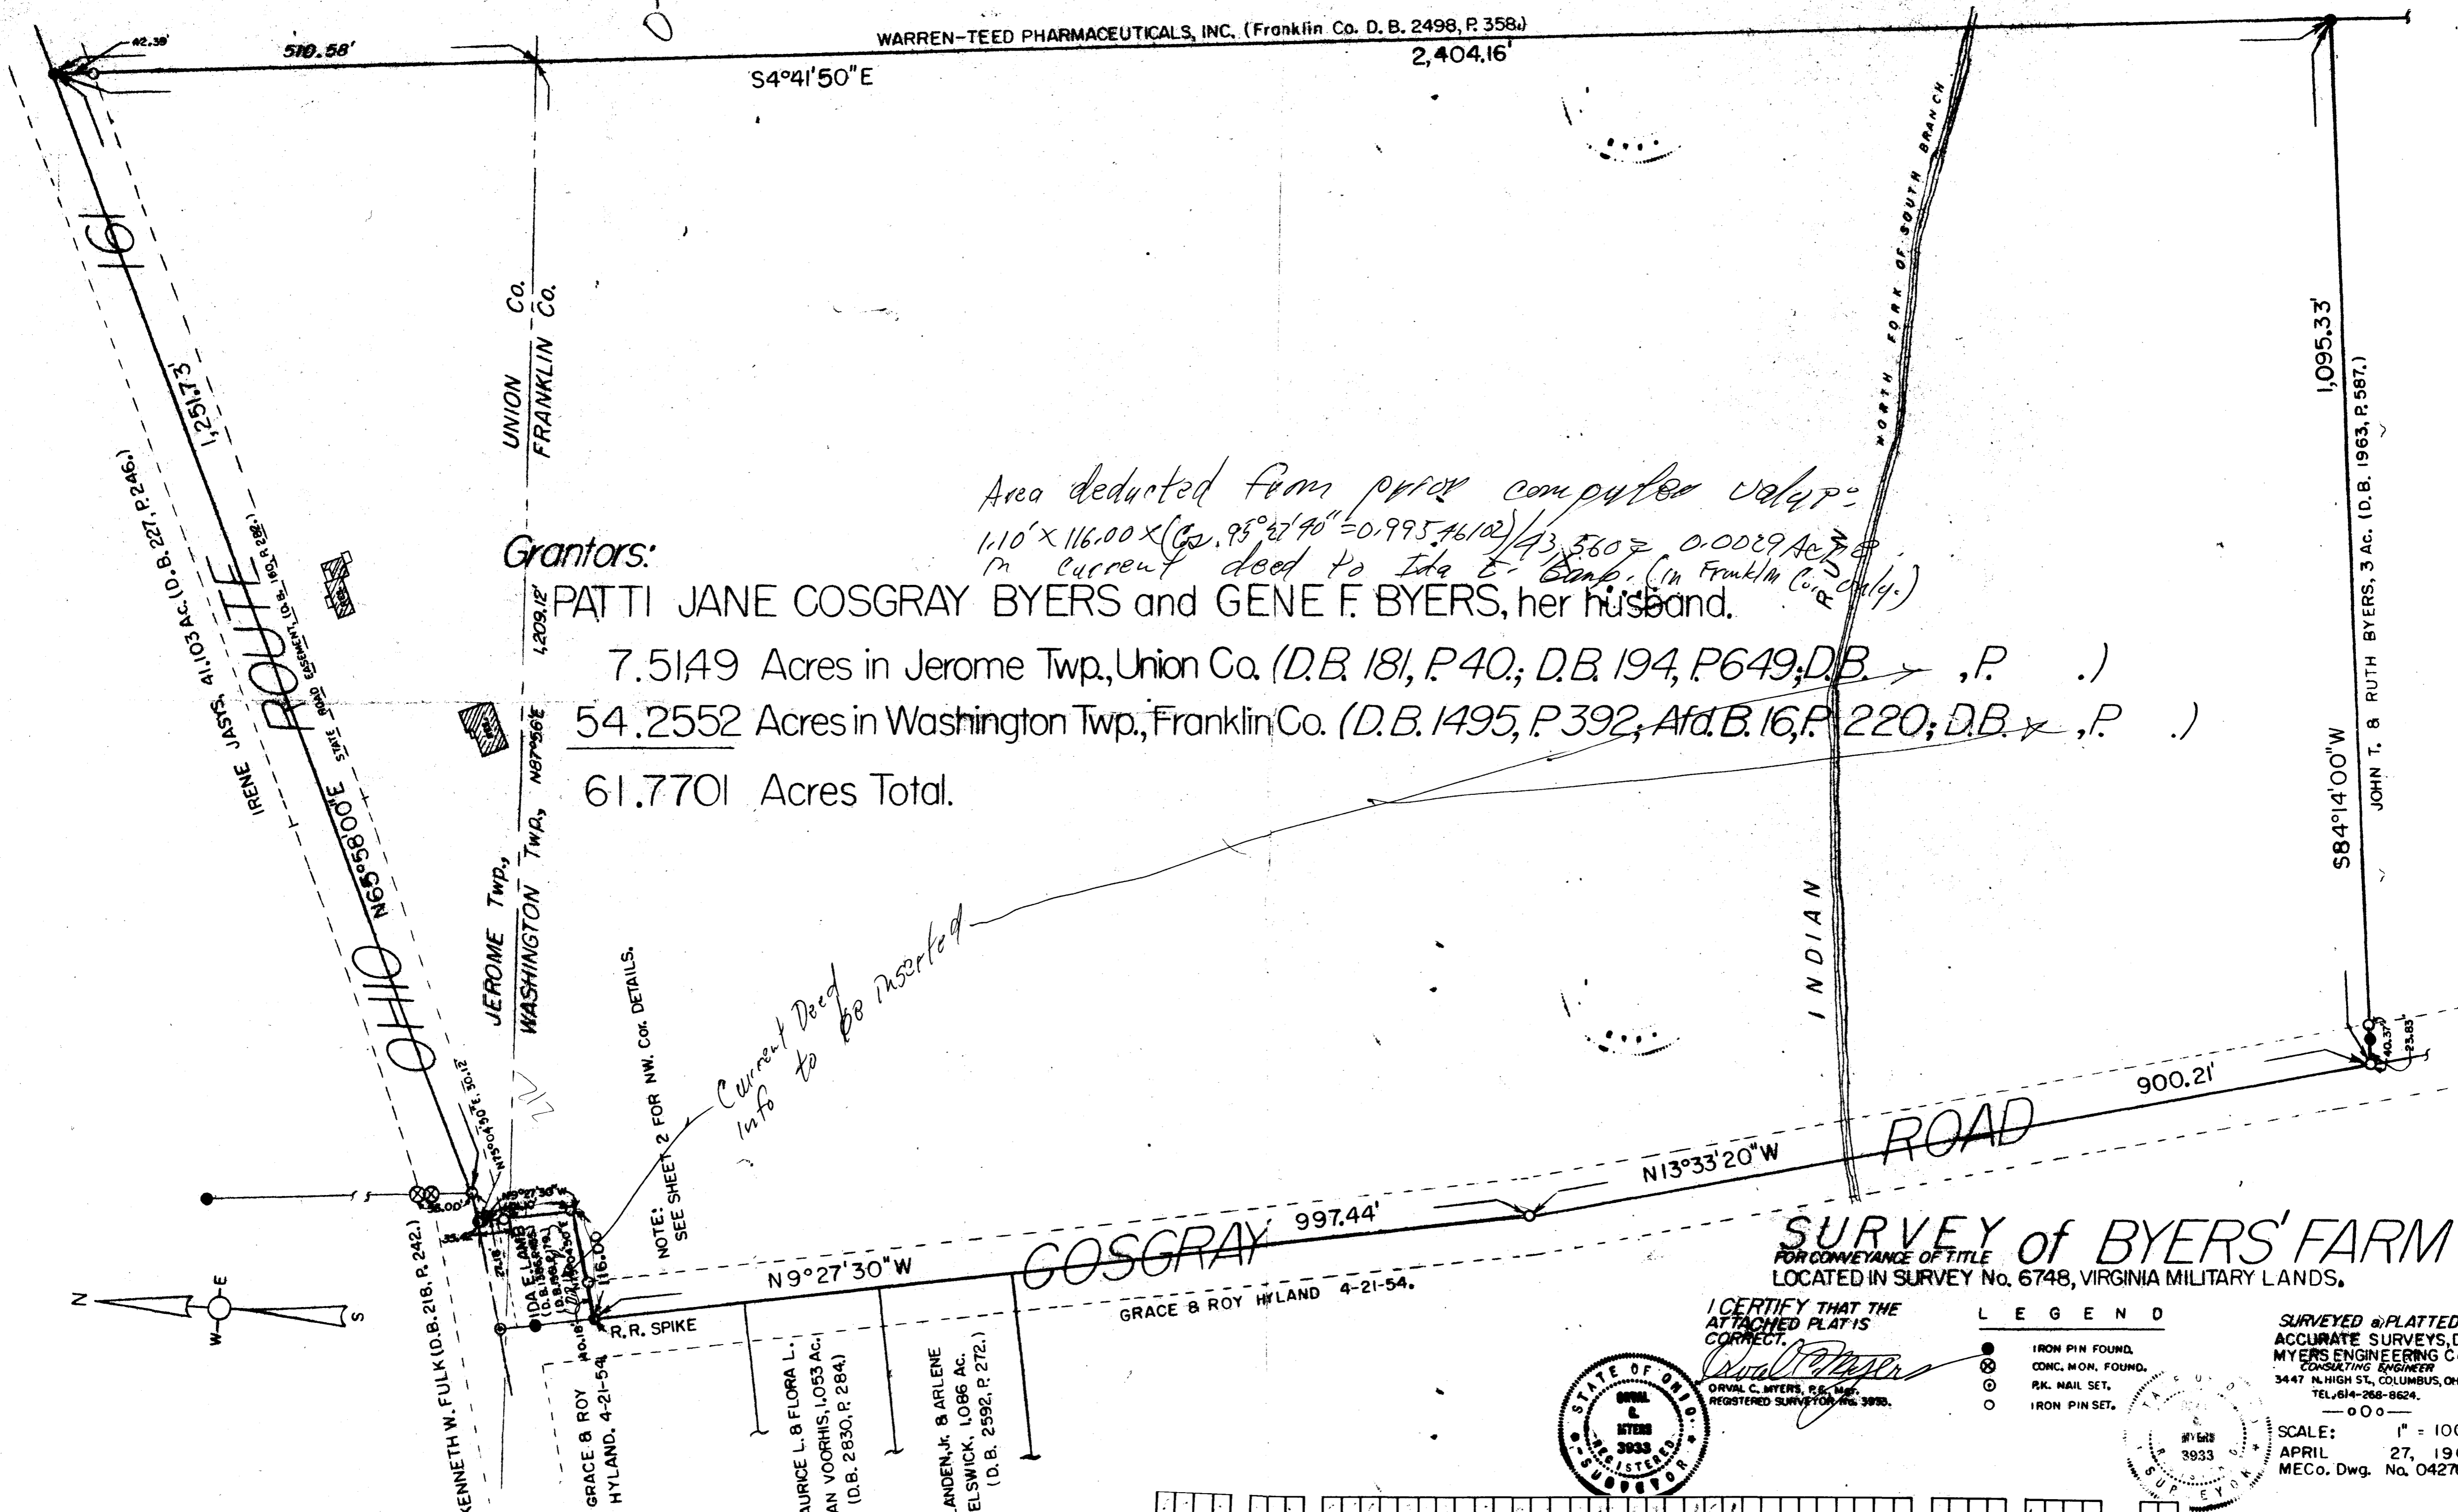

WARREN-TEED PHARMACEUTICALS, INC. (Franklin Co. D. B. 2498, P. 358.)

S4°41'50"E

2,404.16'

510.58'

Grantors:

PATTI JANE COSGRAY BYERS and GENE F. BYERS, her husband.

7.5149 Acres in Jerome Twp., Union Co. (D.B. 181, P. 40.; D.B. 194, P. 649; D.B. , P. .)

54.2552 Acres in Washington Twp., Franklin Co. (D.B. 1495, P. 392, Afd. B. 16, P. 220; D.B. , P. .)


61.7701 Acres Total.

Area deducted from prior computer value:
 $1.10' \times 116.00' \times (\cos 95^\circ 27' 40'' = 0.99576102) / 43,560 = 0.0029 \text{ AC} \approx 0.0001 \text{ AC}$
 in current deed to Ida E. Byers (in Franklin Co. only.)

SURVEY of BYERS' FARM

FOR CONVEYANCE OF TITLE
 LOCATED IN SURVEY No. 6748, VIRGINIA MILITARY LANDS.

I CERTIFY THAT THE ATTACHED PLAT IS CORRECT.

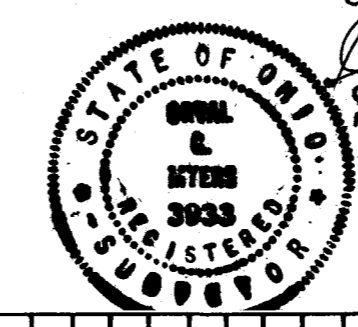

LEGEND

- IRON PIN FOUND.
- ⊗ CONC. MON. FOUND.
- ⊙ R.R. NAIL SET.
- IRON PIN SET.

SURVEYED & PLATTED by
 ACCURATE SURVEYS, Div. of
 MYERS ENGINEERING Co.
 CONSULTING ENGINEER
 3447 N. HIGH ST., COLUMBUS, OHIO: 43214.
 TEL: 614-268-8624.

SCALE: 1" = 100'.
 APRIL 27, 1968, REV. 9-21-68.
 MECo. Dwg. No. 042768-L

NOTE: SEE SHEET 2 FOR NW. COR. DETAILS.

Current Deed info to be inserted

