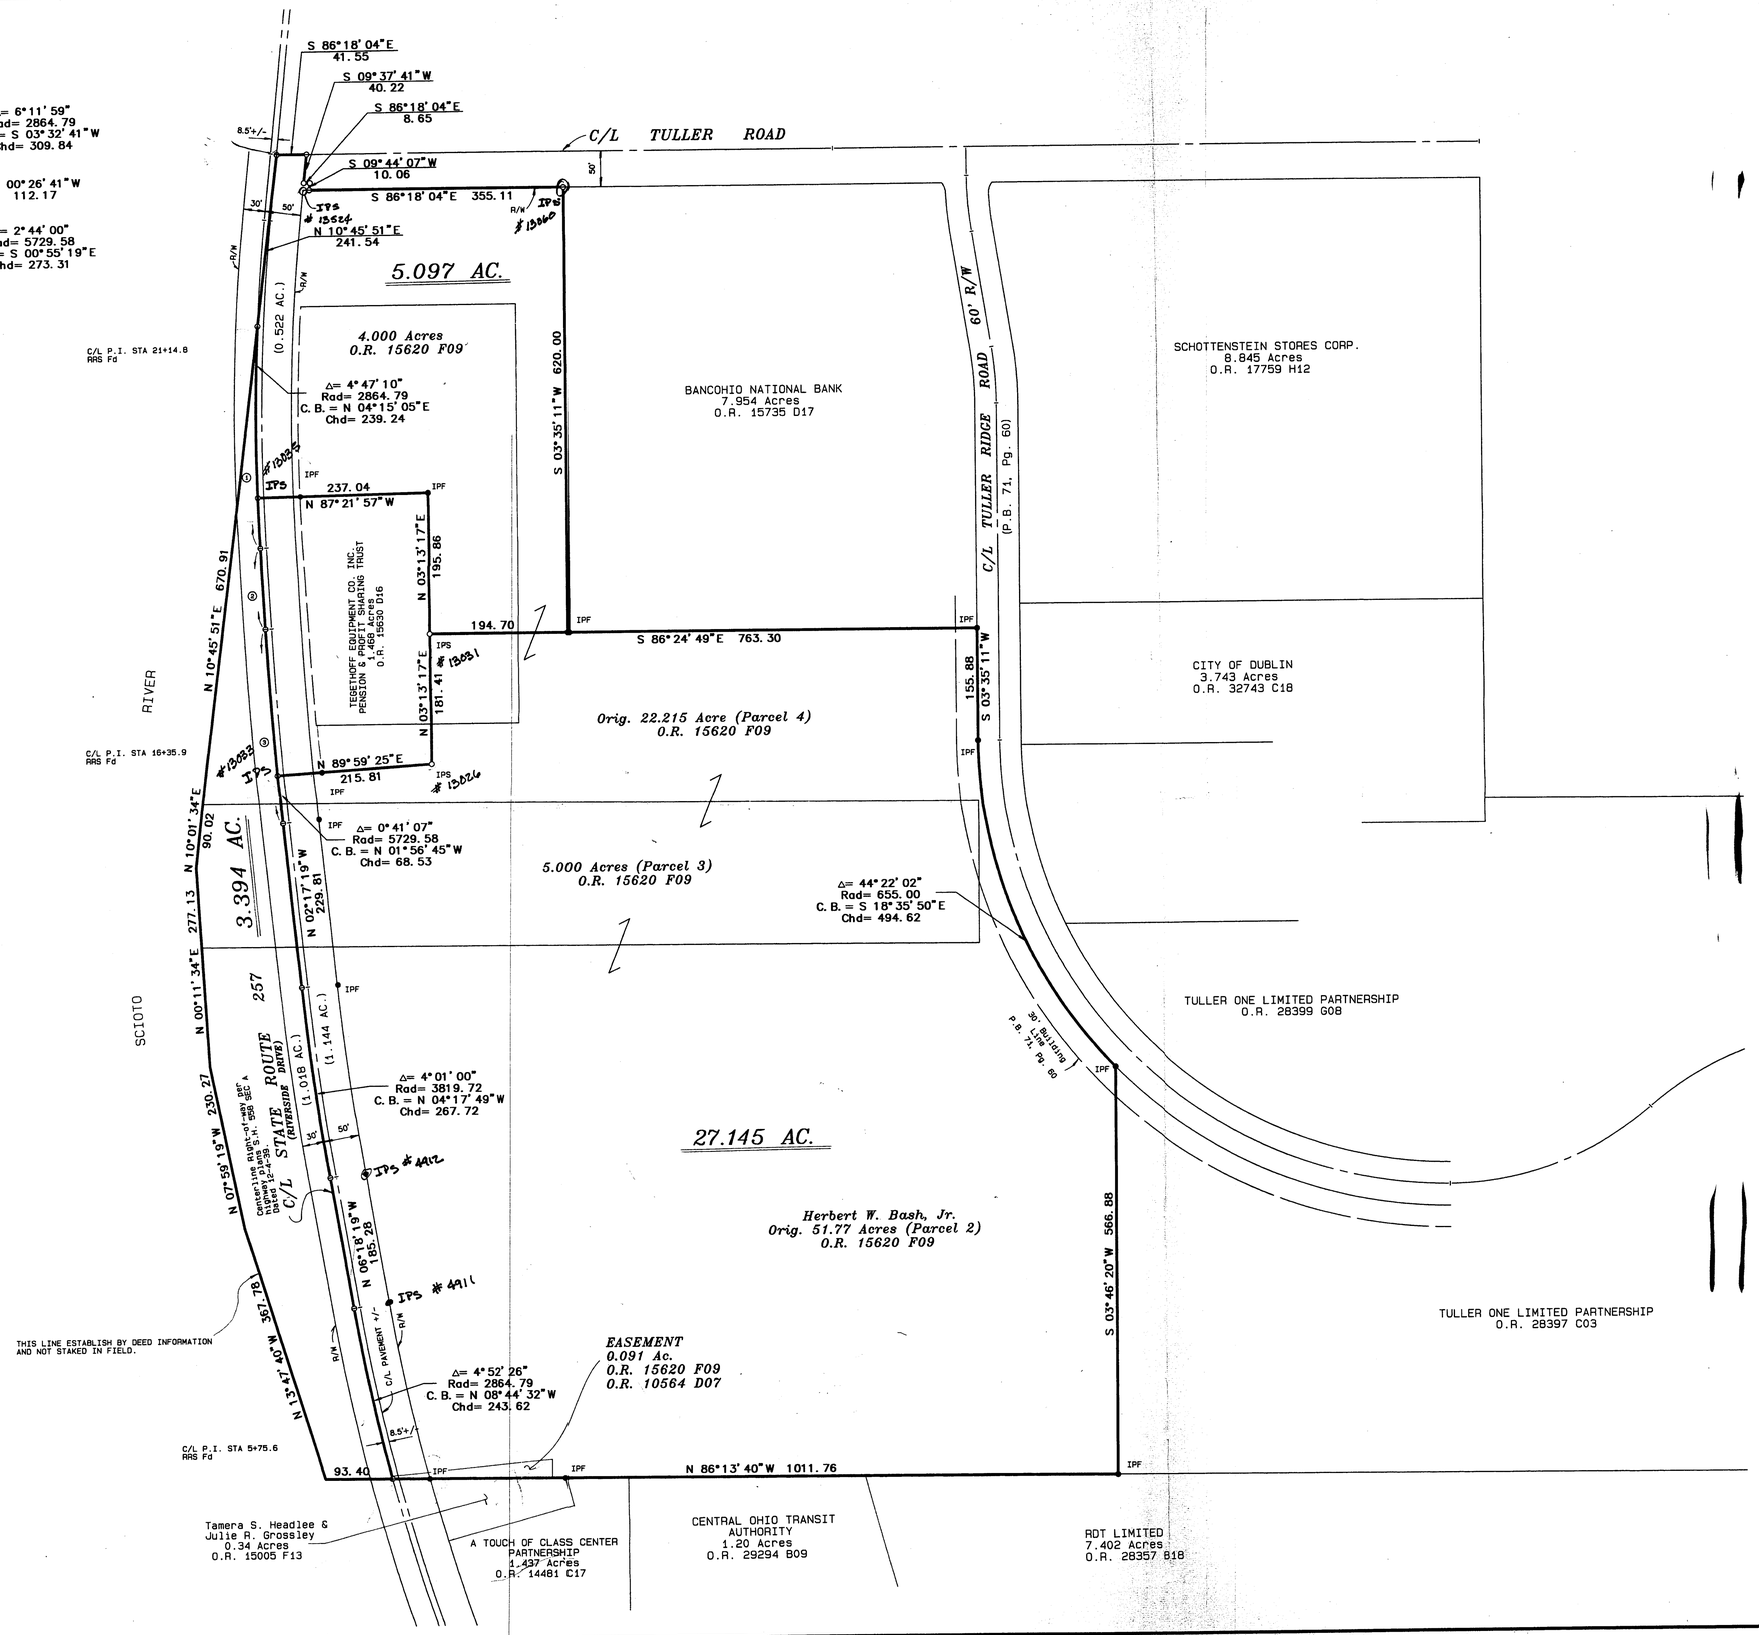

100 0 100 200
SCALE IN FEET

BASIS OF BEARING

The bearings shown hereon are based on the bearing of S 03°35'11" W, for the centerline of Tuller Ridge Road as shown of record on Plat Book 71, page 60.

Survey of

27.145, 5.097 and 3.394 ACRES

QUARTER TOWNSHIP 2, TOWNSHIP 2, RANGE 19
UNITED STATES MILATARY LANDS

City of Dublin, Ohio
Scale: 1" = 100' Date: Sept. 1996

Prepared by:

R.D. ZANDE & ASSOCIATES, INC.
1237 Dublin Road Columbus, Ohio 43215
(614) 486-4383

Registered Surveyor No. 6096

FINAL PLOT PLAN - 167[0,66]PF: SURVBH 995 12-Sep-96 01:32 PM / 15620H-889