N-48-B

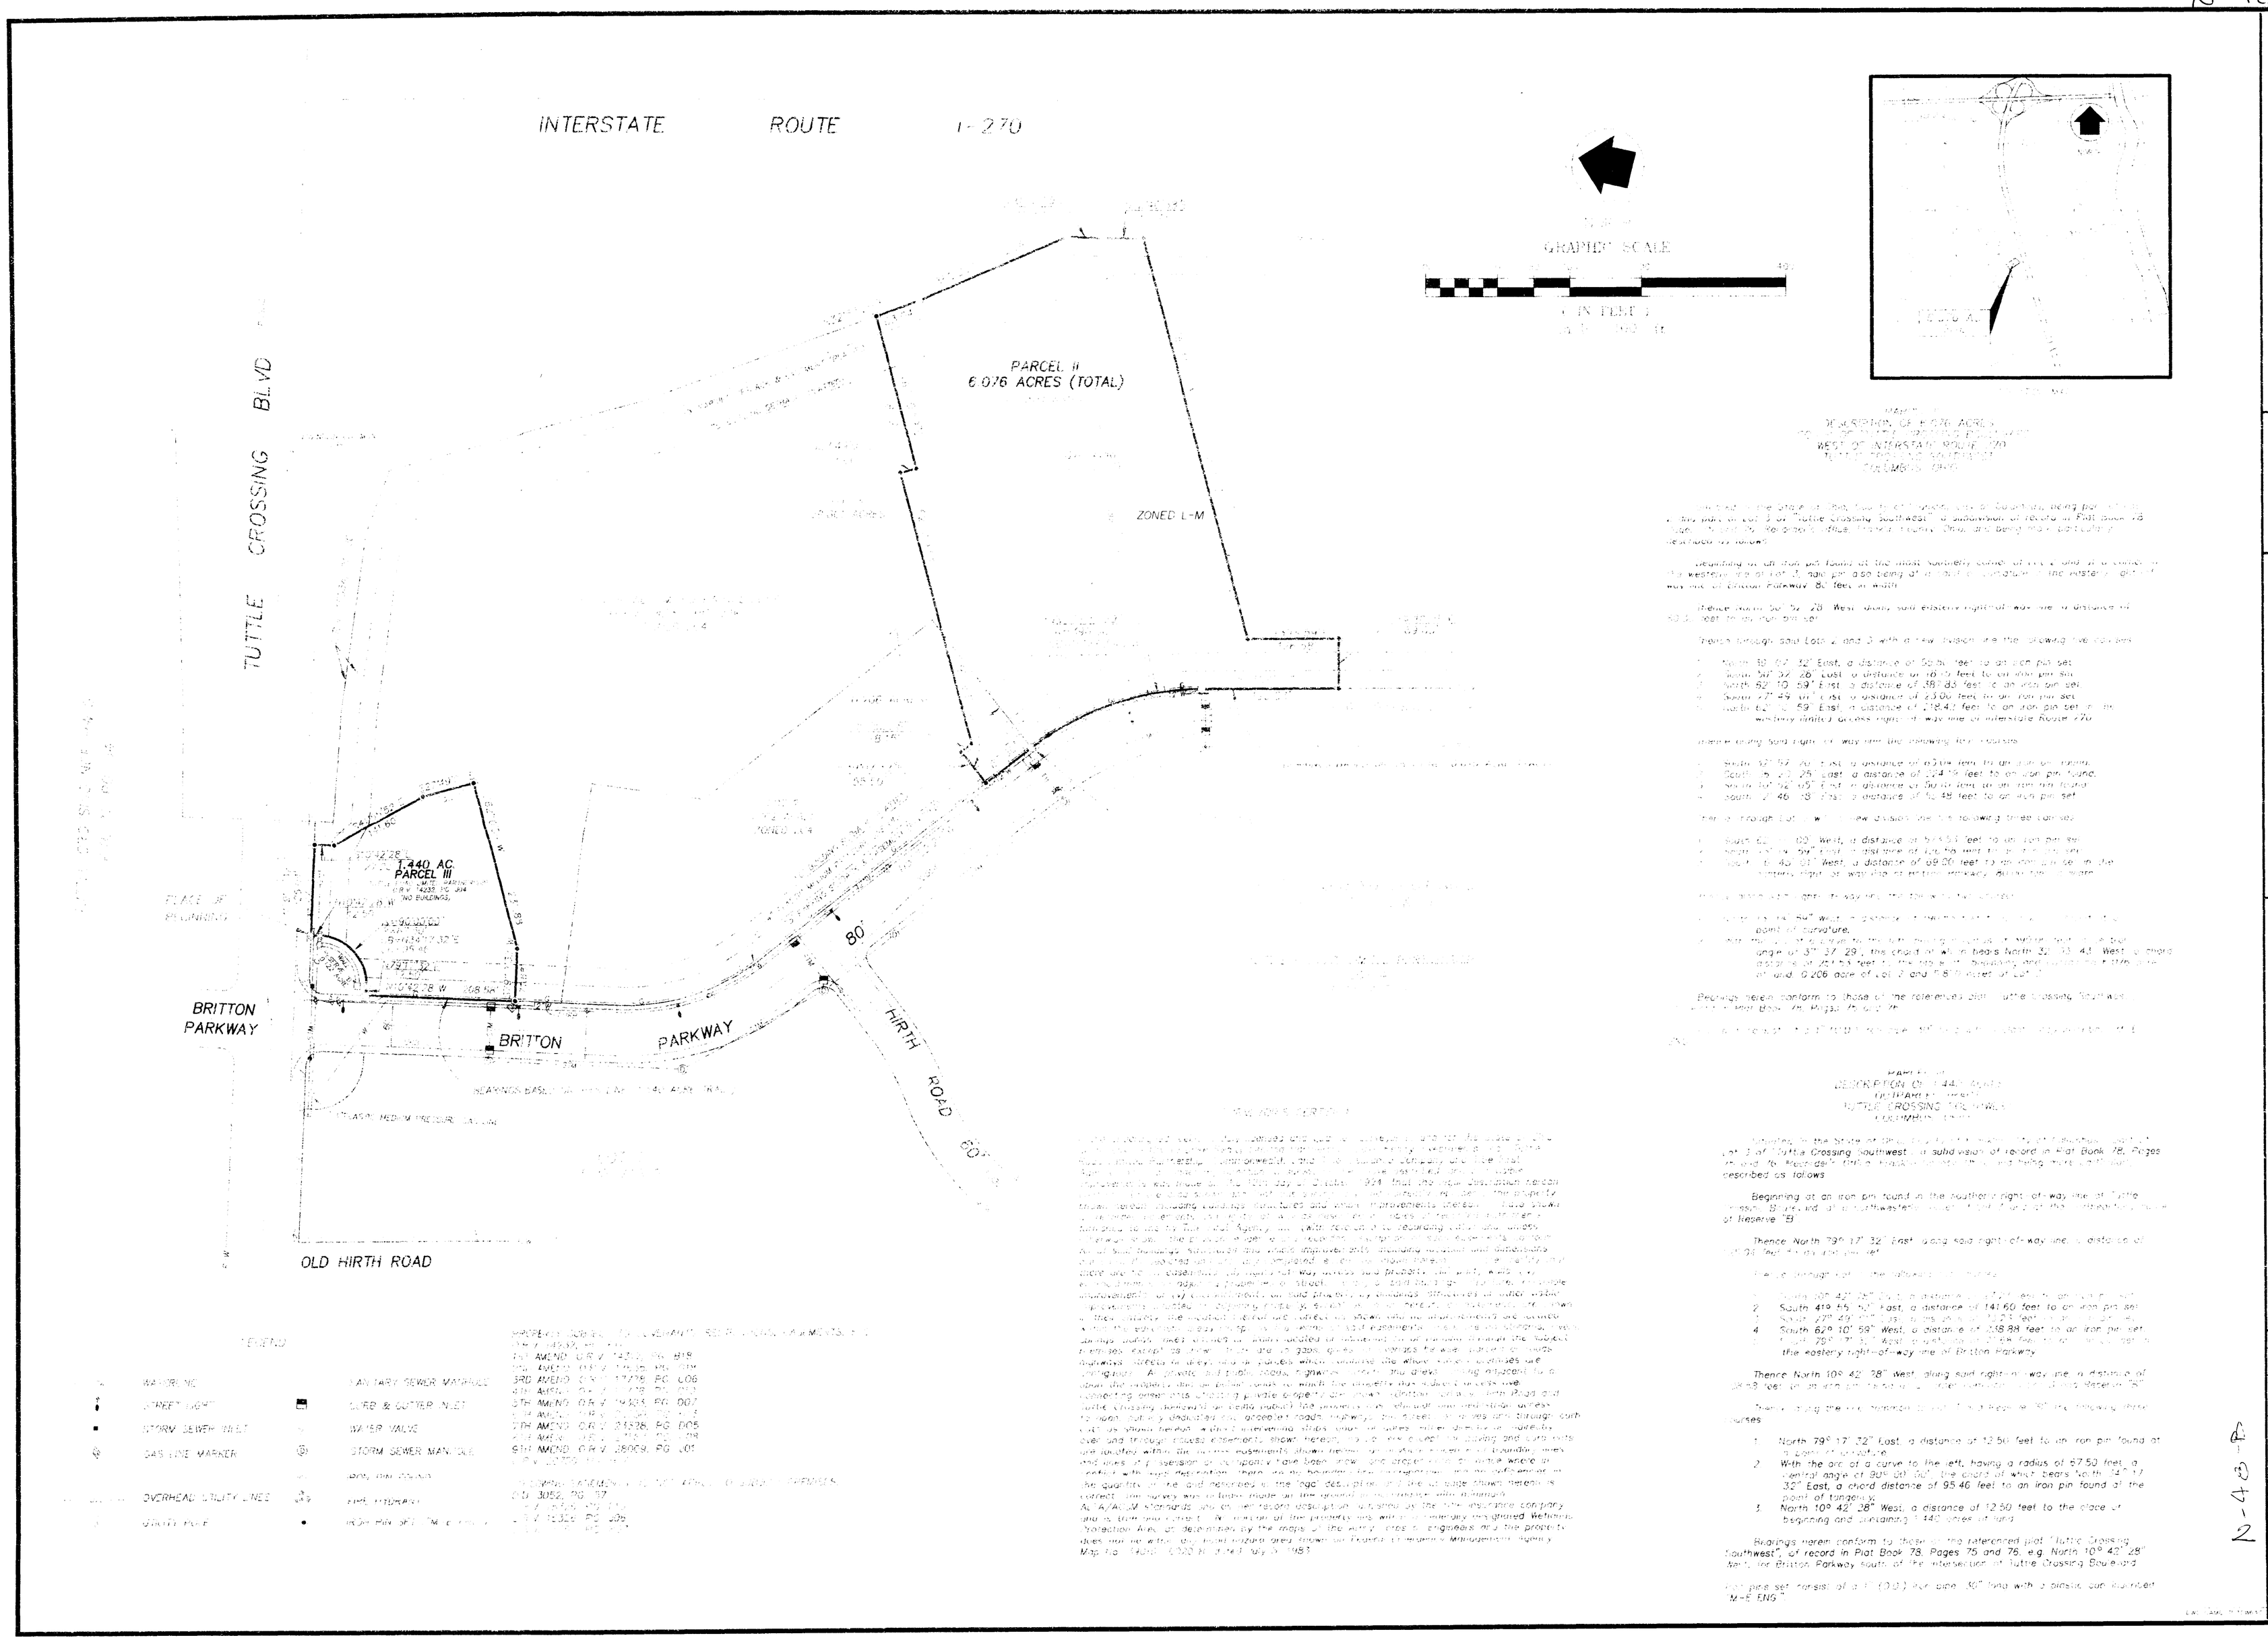

M-E CIVIL ENGINEERING INC
500 SOUTH FRONT STREET
COLUMBUS, OHIO 43215
PHONE: (614) 469-4903
FAX: (614) 469-4989

REGISTERED SURVEYOR

ALTA/ACSM SURVEY

PART OF LOTS 2 AND 3 TUTTLE CROSSING SOUTHWEST

COLUMBUS, OHIO

SCALE	HORIZ 1"=100'
	VERT
DATE	4/7/95
SHEET NO.	1/1
PRINT DATE	

M-E ENGINEERING INC

N-48-B