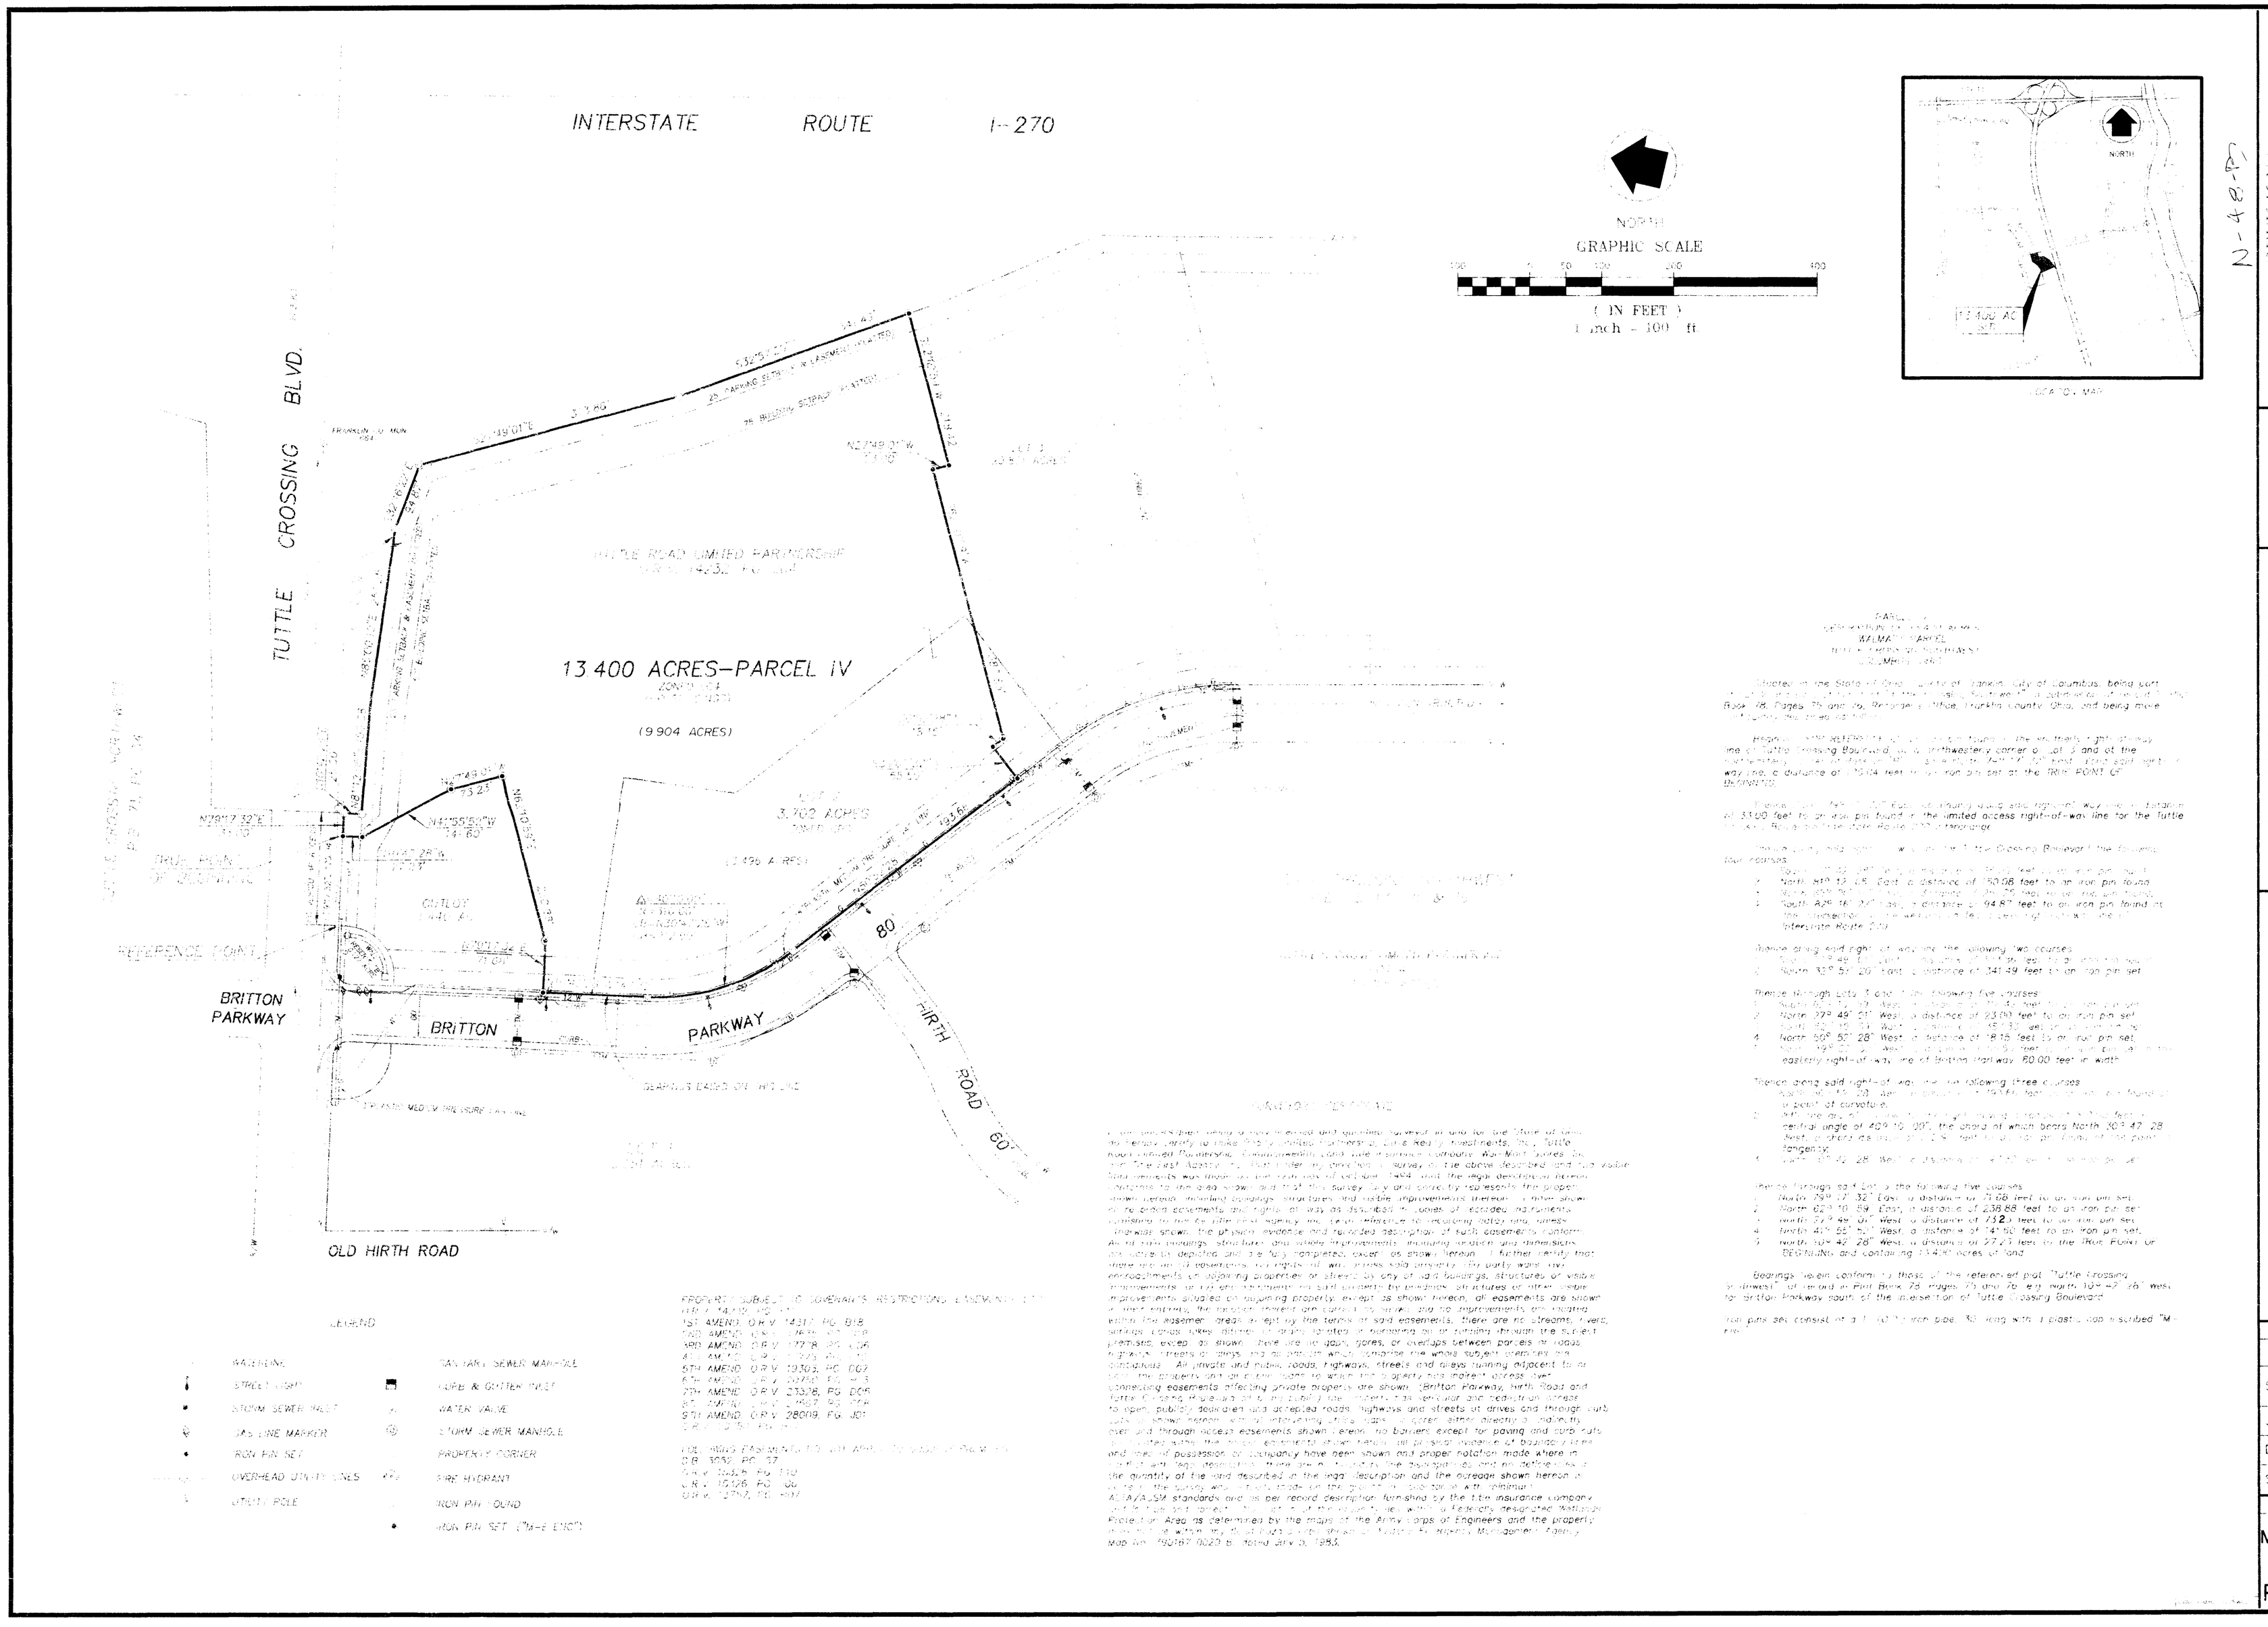
INTERSTATE ROUTE I-270
NORTH
GRAPHIC SCALE
(IN FEET)
1 inch = 100 ft.
TUTTLE CROSSING BLVD.
13.400 ACRES-PARCEL IV
(9.904 ACRES)
3.702 ACRES
BRITTON PARKWAY
BRITTON PARKWAY
HIRTH ROAD
OLD HIRTH ROAD
80
60
REFERENCE POINT
NORTH
REVISIONS
DATE BY DESCRIPTION
M-E ENGINEERING INC
CIVIL DIVISION
500 SOUTH FRONT STREET
COLUMBUS, OHIO 43215
PHONE: (614) 469-4903
FAX: (614) 469-4989
ALTA/ACSM SURVEY
LOT 2 AND PART OF LOT 3
TUTTLE CROSSING SOUTHWEST
COLUMBUS, OHIO
SCALE HORIZ. 1" = 100'
VERT.
JOB 91207
DATE APRIL 1995
SHEET NO. 1/1
PRINT DATE
M-E ENGINEERING, INC. COLUMBUS OHIO
APR 12 1995
PRINTED