
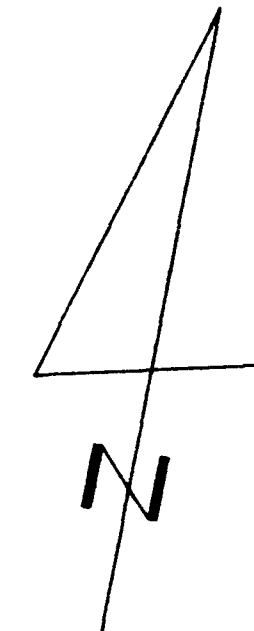


PLAT OF SURVEY
 BEING PART OF SURVEY NO. 2418,
 VIRGINIA MILITARY LANDS, CITY OF
 DUBLIN, FRANKLIN COUNTY, OHIO

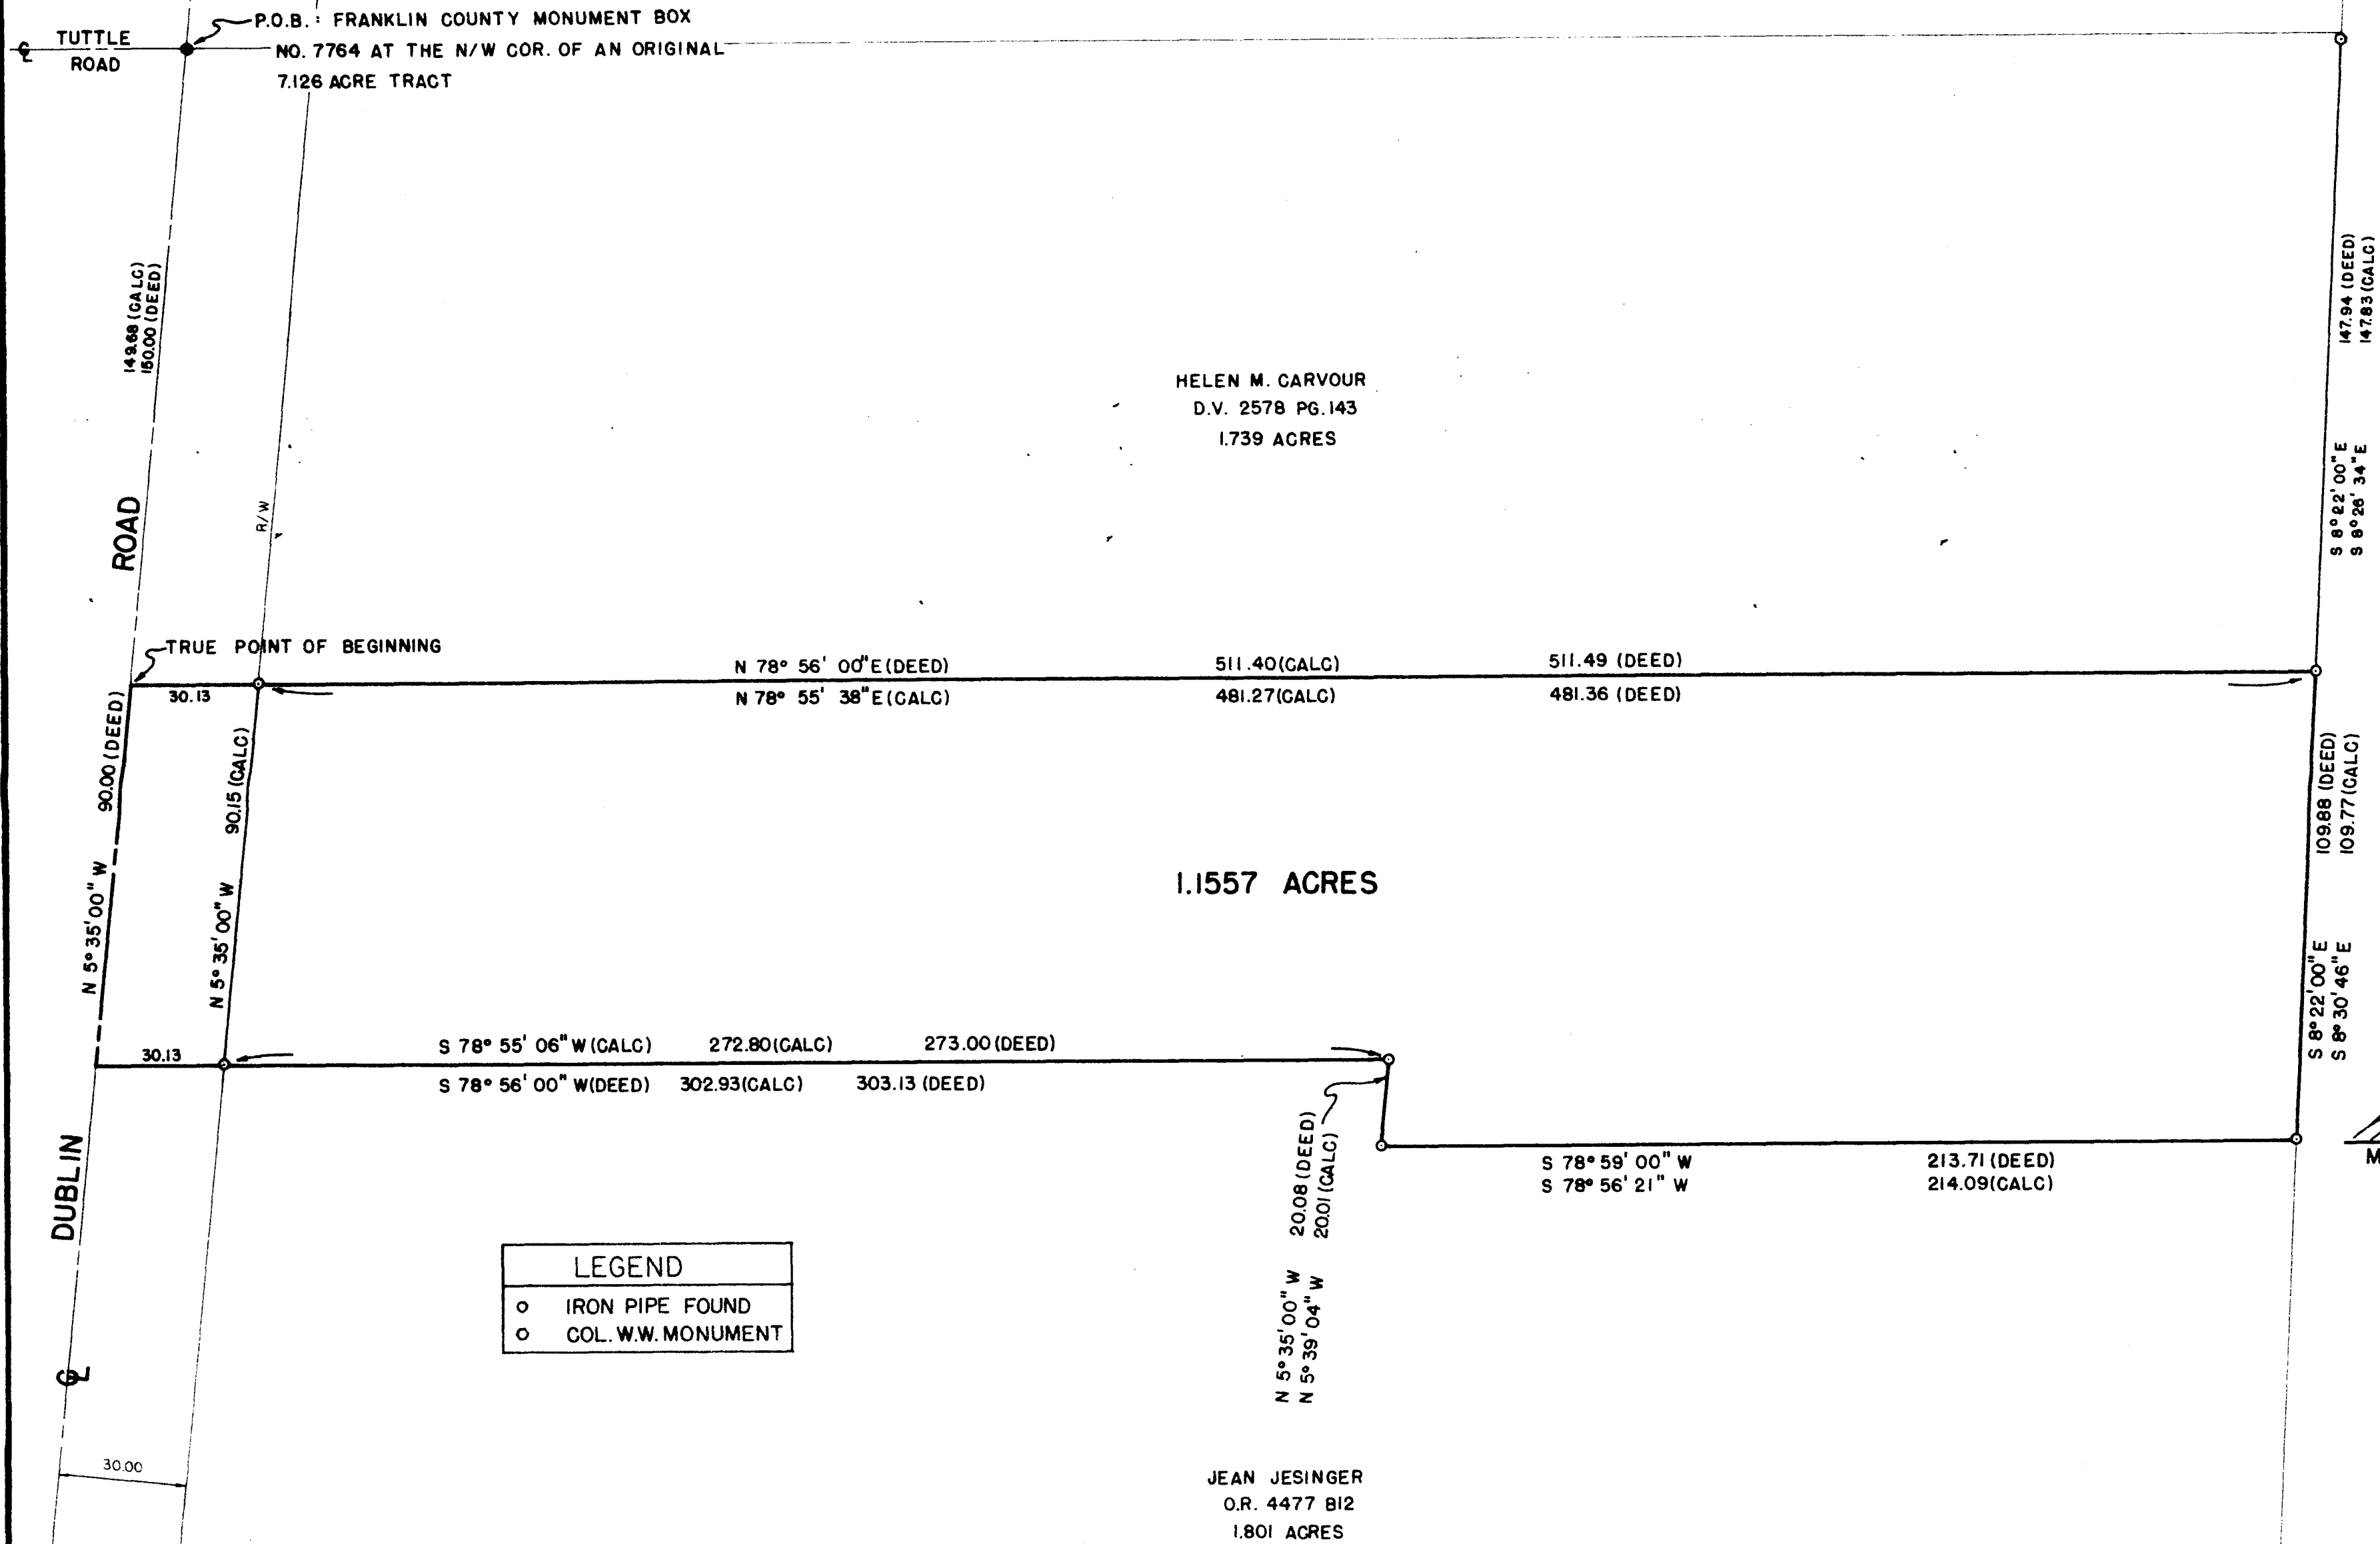

SCALE: 1" = 30'

THE CITY OF COLUMBUS
 SCIOTO RIVER

Malcolm A. Grove
 MALCOLM A. GROVE - REG. SURVEYOR NO. 6547



0 15 30 60 90

CURRY WILLIS & GROVE, INC.
 ENGINEERS AND SURVEYORS
 2160 TREMONT CENTER · COLUMBUS, OHIO 43221

NAME:
 JOEL MCCUEN

SCALE: 1" = 30' DRN. BY: D.B.P. JOB NO.
 DATE: 7-31-92 CHK. BY: M.A.G. 82-07-92