10/31/00
SPLIT
7735-7425

FIELD SURVEY
PLAT

PLAT OF 4.0003 ACRES IN VMS 6640 BROWN TWP.
#4322 ELLIOT ROAD FRANKLIN CO., OH.
HILLIARD P.O. ADDRESS
RICHARD B. STAHL & NANCY E. STAHL
PT. OF PAR. 672

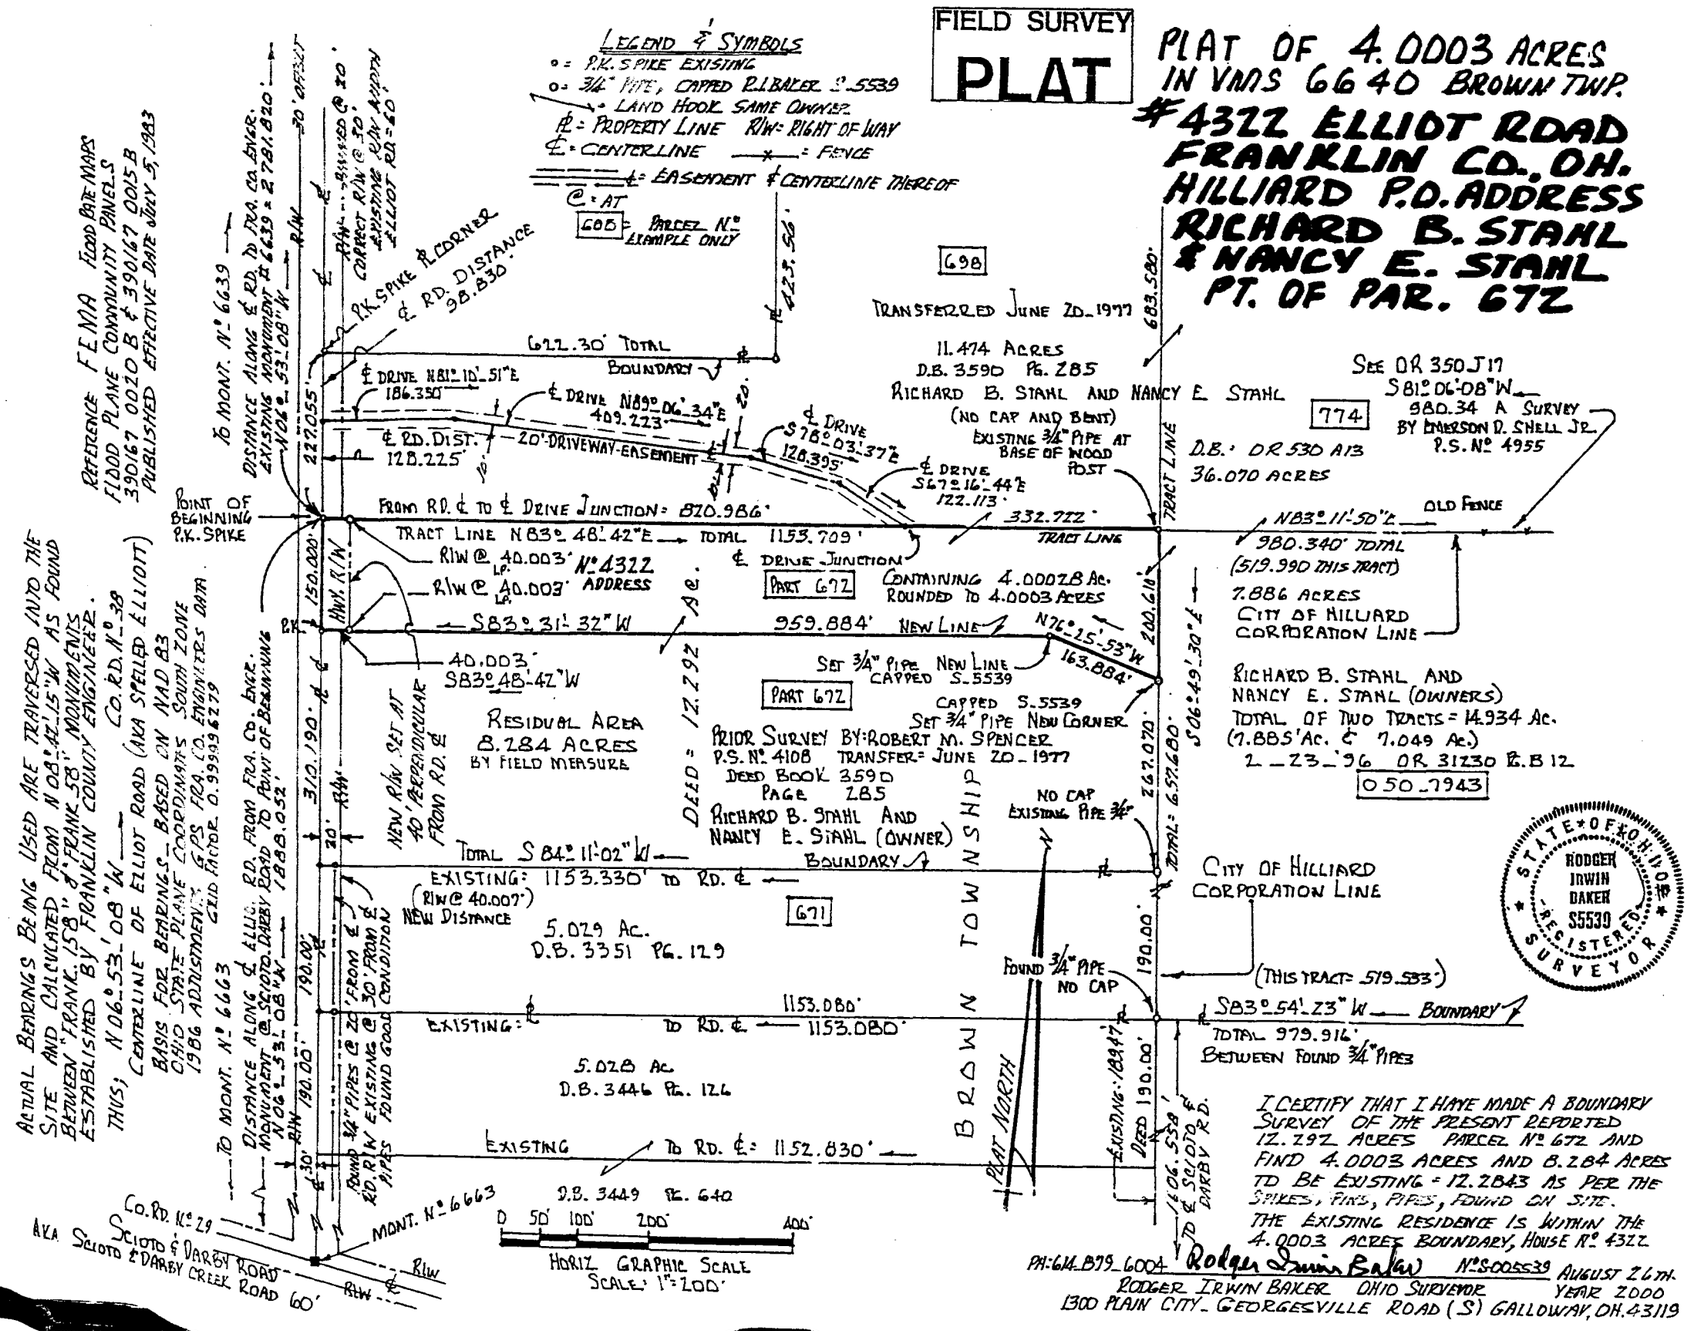

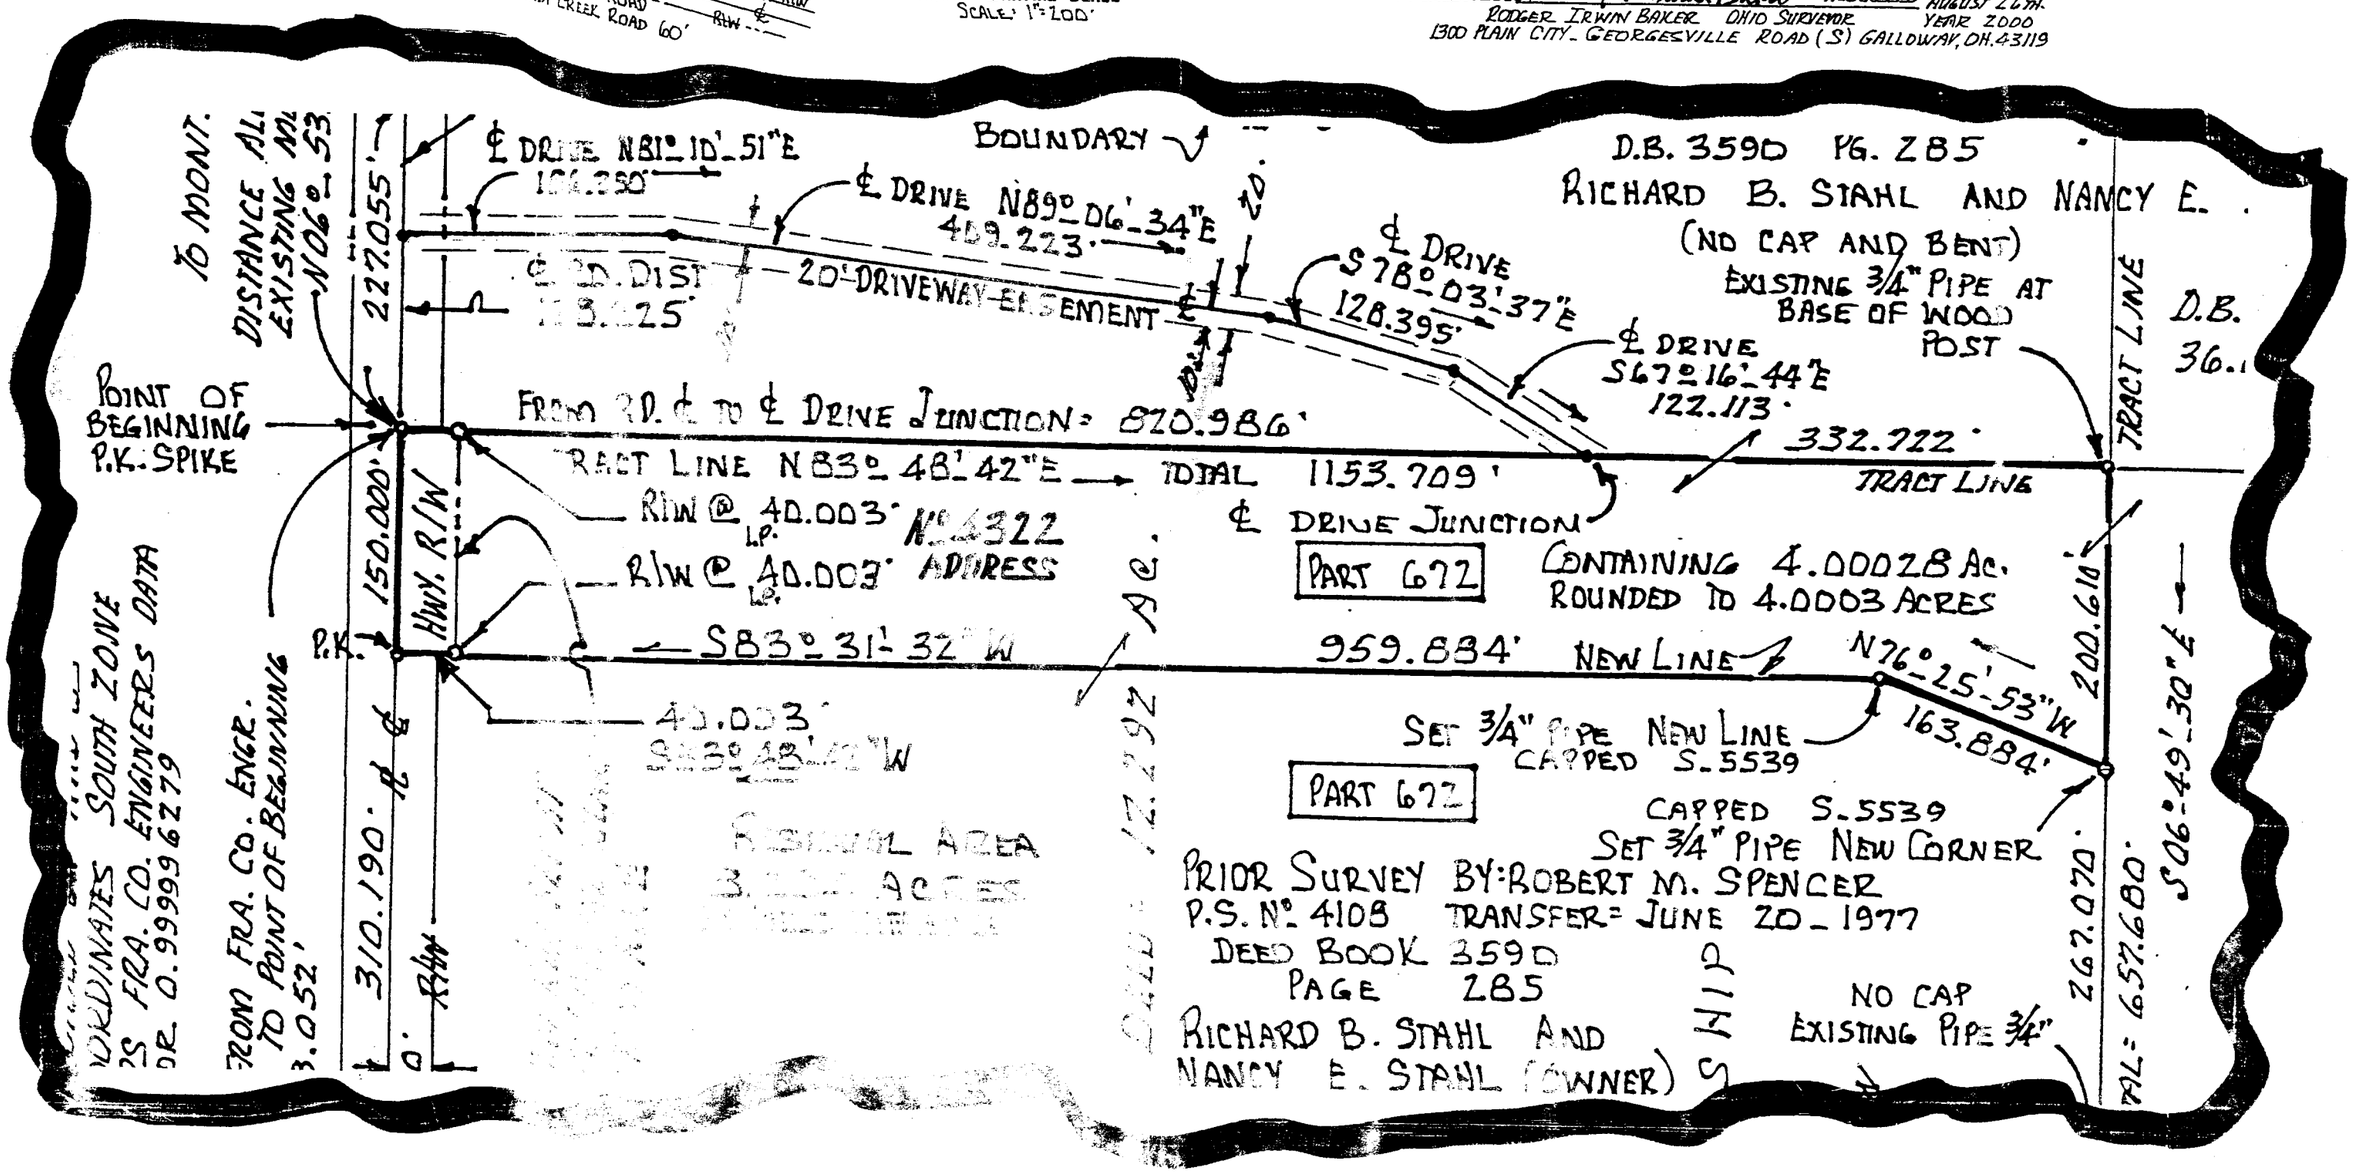

7735-7425