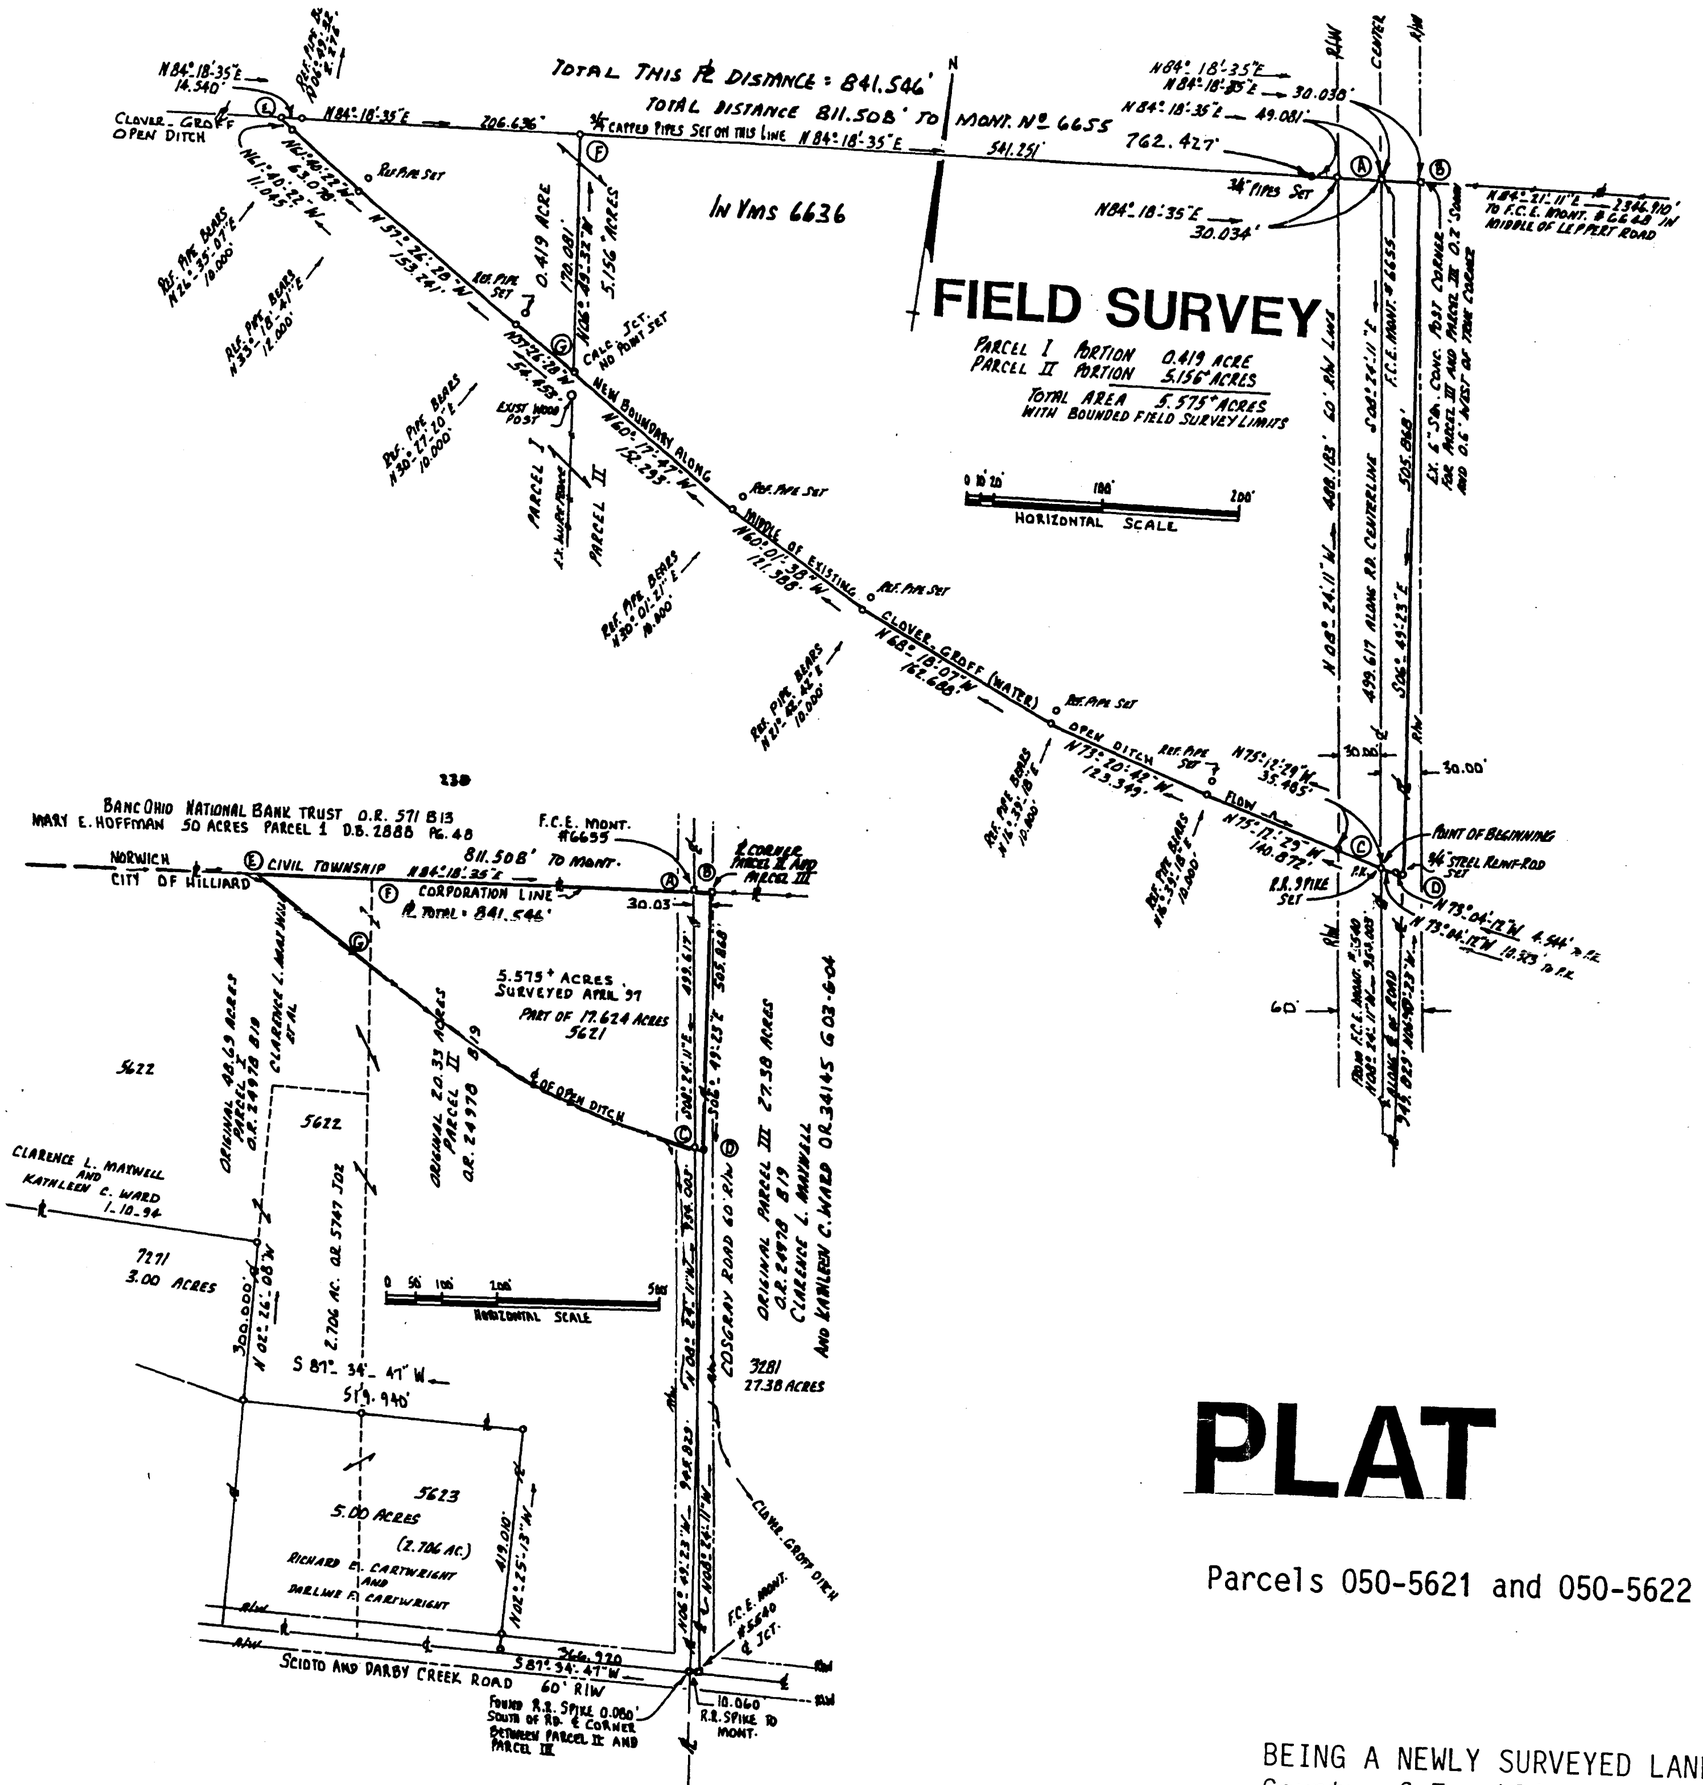

VICINITY SCHEMATIC FOR 5.575 + ACRES SURVEYED

STATE OF OHIO
RODGER IRWIN BAKER
S5539
REGISTERED SURVEYOR

Pipes are 3/4 inch diameter with caps stamped R.I.Ba
Bearings are based on O.R. 31230 B12

Surveyed in March and April, 1997 by the undersigned

Rodger I. Baker April 10, 1997

Rodger Irwin Baker PS # 005539
1300 Plain City-Georgesville Road (South)
Galloway, Ohio 43119

Tel: 614-879-6004

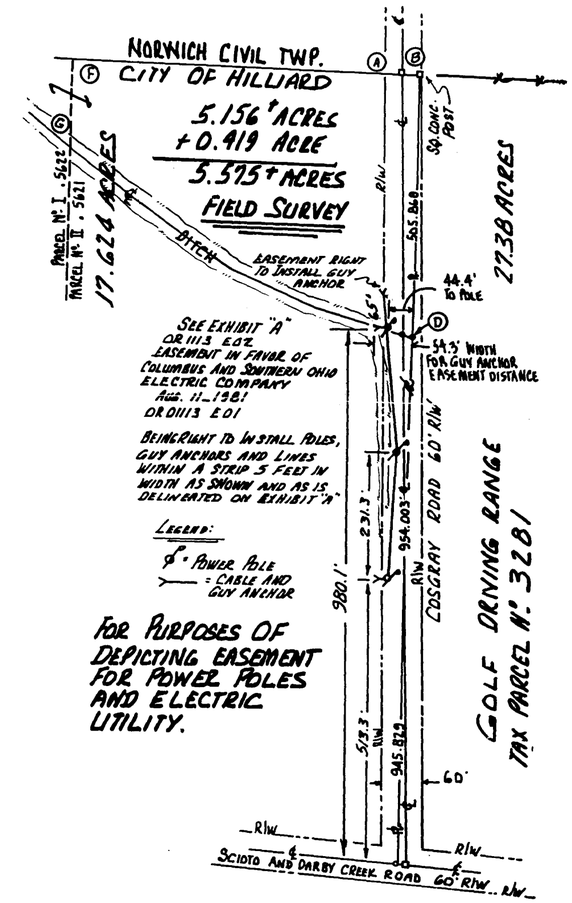

PLAT

Parcels 050-5621 and 050-5622 are in the names of Clarence L. Maxwell and Kathleen C. Ward

BEING A NEWLY SURVEYED LANDSPLIT IN VMS 6636, City of Hilliard, County of Franklin, State of Ohio...Being a portion of tax parcels 050-5621 and 050-5622...Fronting along Cosgray Road
For: Clarence L. Maxwell and Kathleen C. Ward