


SURVEY OF ACREAGE PARCEL
LOCATED IN VIRGINIA MILITARY SURVEY NO. 1462 &
VIRGINIA MILITARY SURVEY NO. 13950
CITY OF COLUMBUS, FRANKLIN COUNTY, OHIO

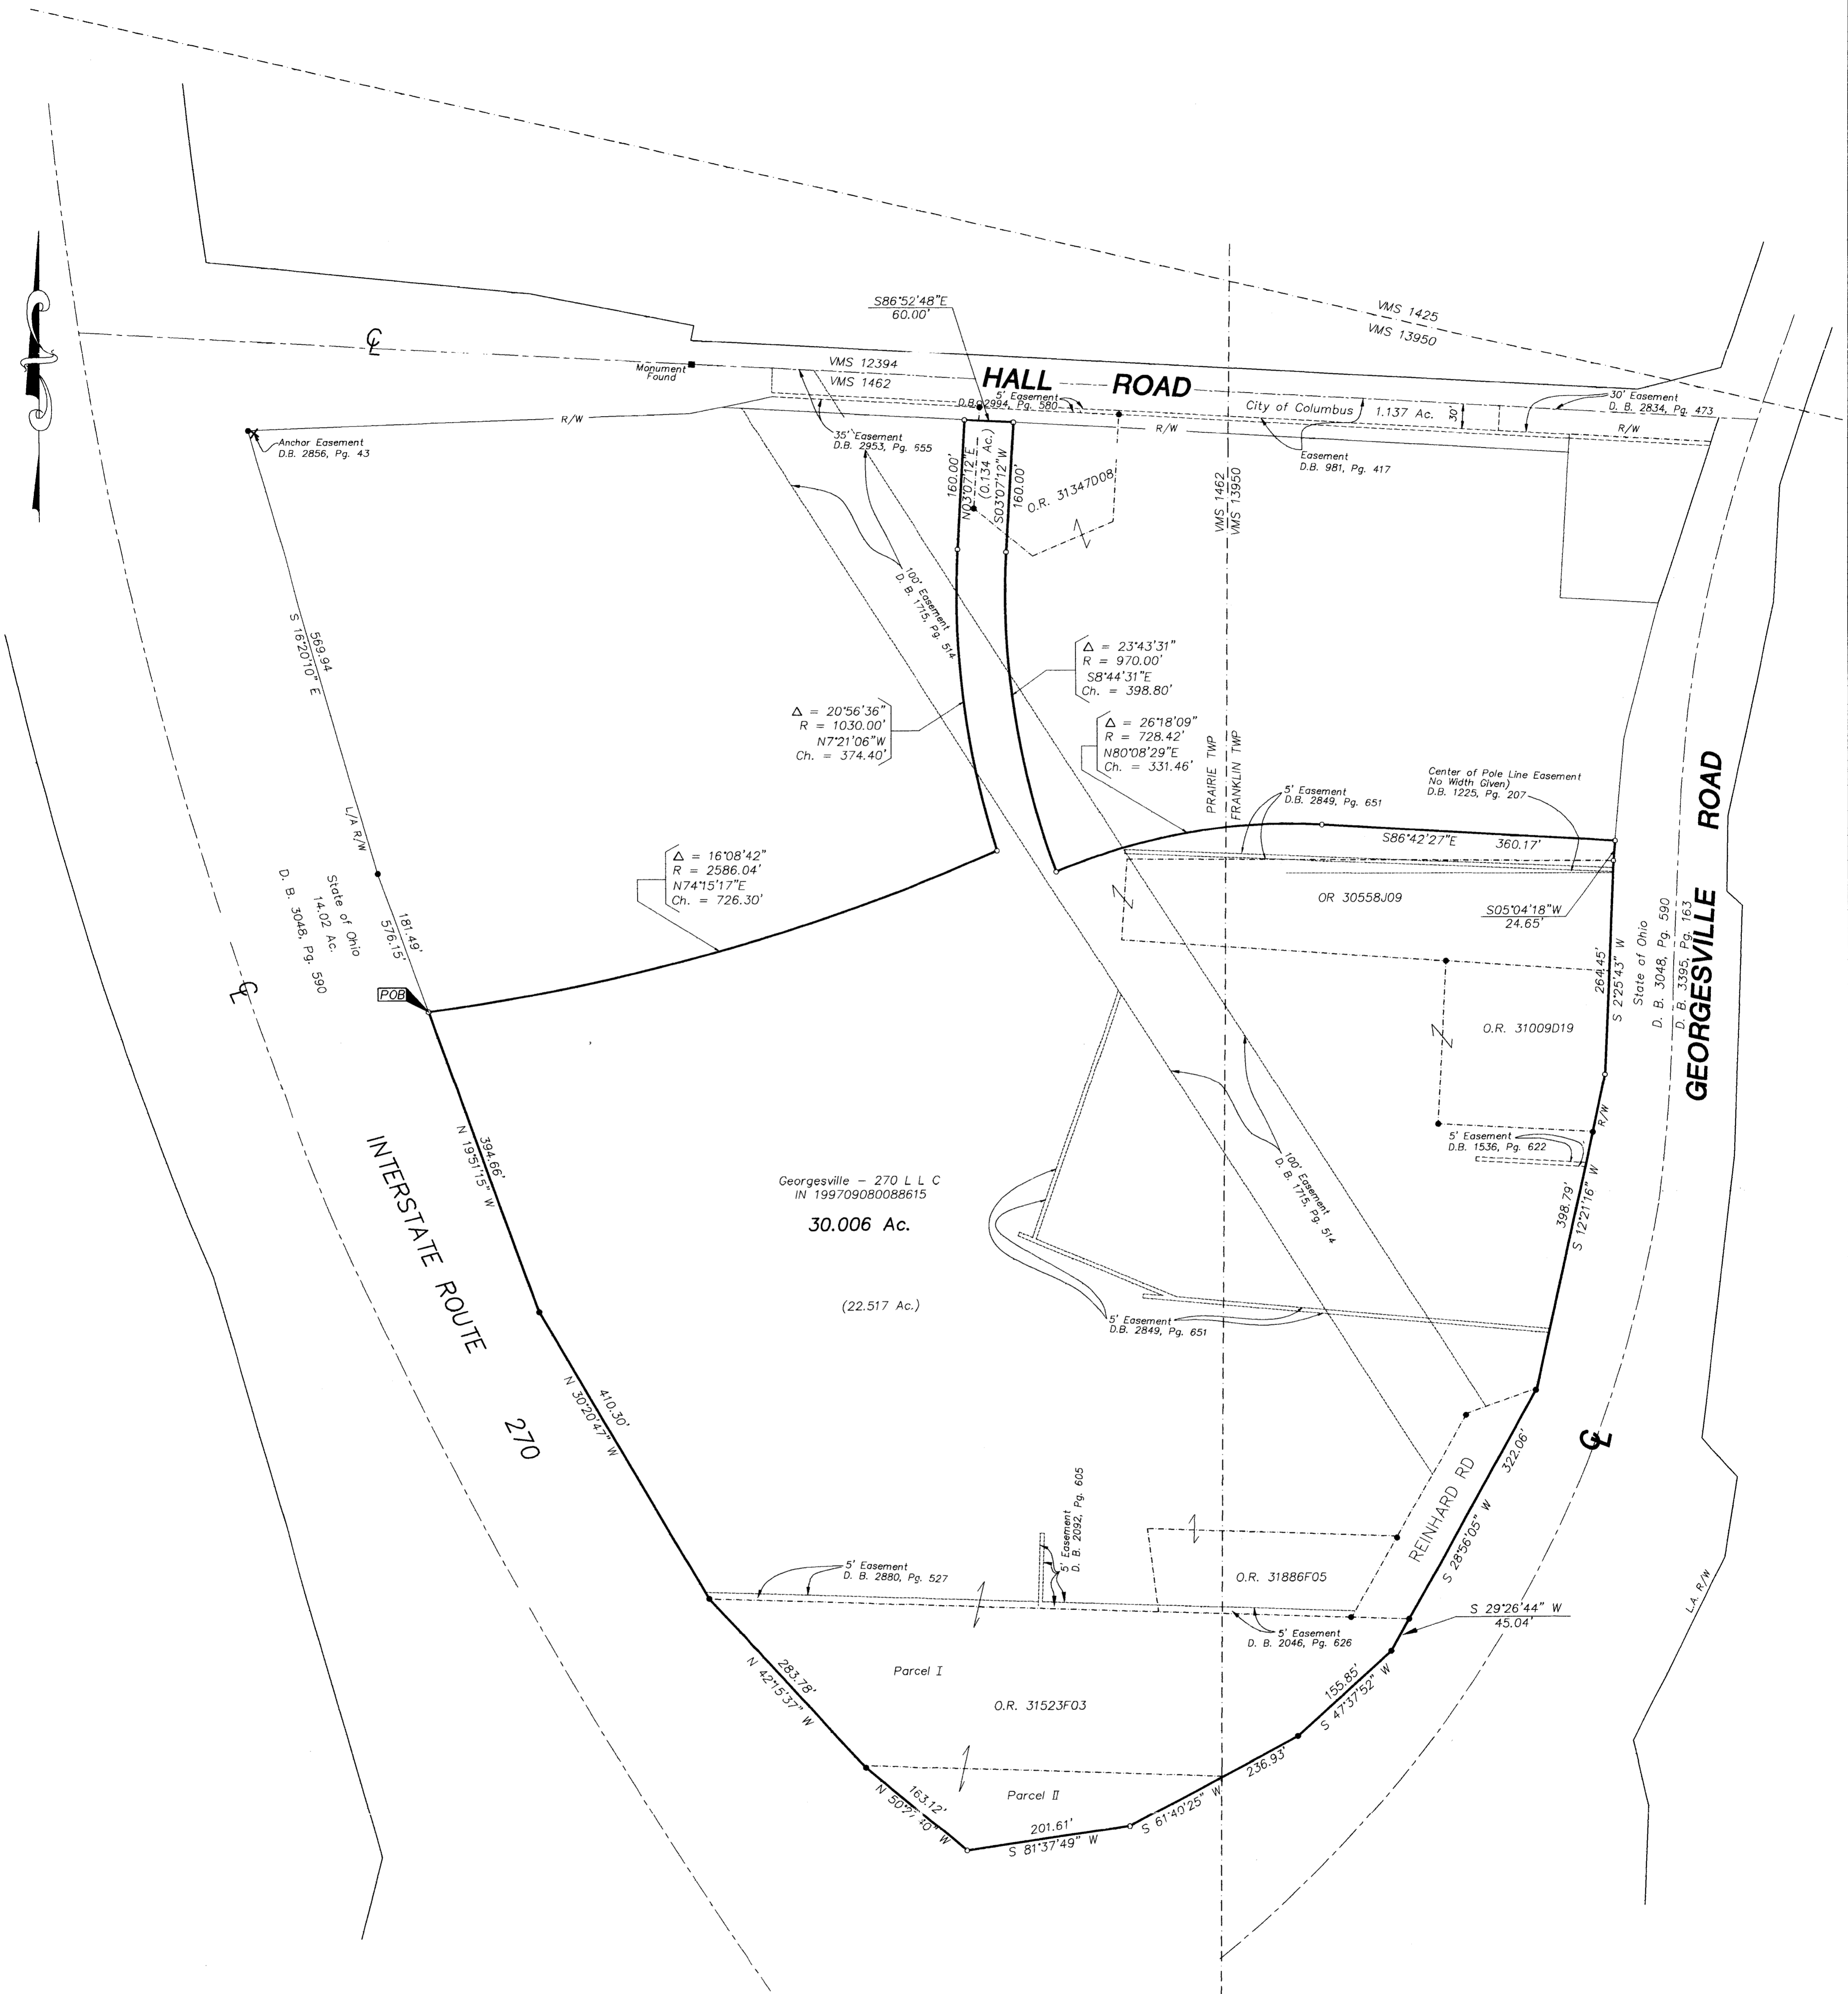

▲ = R.R. SPK. FND.
 △ = R.R. SPK. SET
 ● = I.P. FND.
 ○ = I.P. SET
 I.P.S. Set are 1 3/16" I.D. Iron
 pipe w/ cap inscribed EMH&T.



SURVEYED & PREPARED BY
EMT
 CONSULTING ENGINEERS & SURVEYORS
 170 MILL STREET
 GAHANNA, OHIO 43230
 (614) 471-5152

By *Jeffrey A. Miller* 12.22.99
 Professional Surveyor No. 7211

SCALE: 1" = 100' DECEMBER 22, 1999

\\SERVER-4\SVARNEY\PROJECT\S06981\DWG\S6981B1.DWG - 0 XREFS: - PLOTTED BY JMACLEAN - December 16, 1999 - 9:43 AM