


1" = 60'  
SCALE

Scale: 1" = 60'

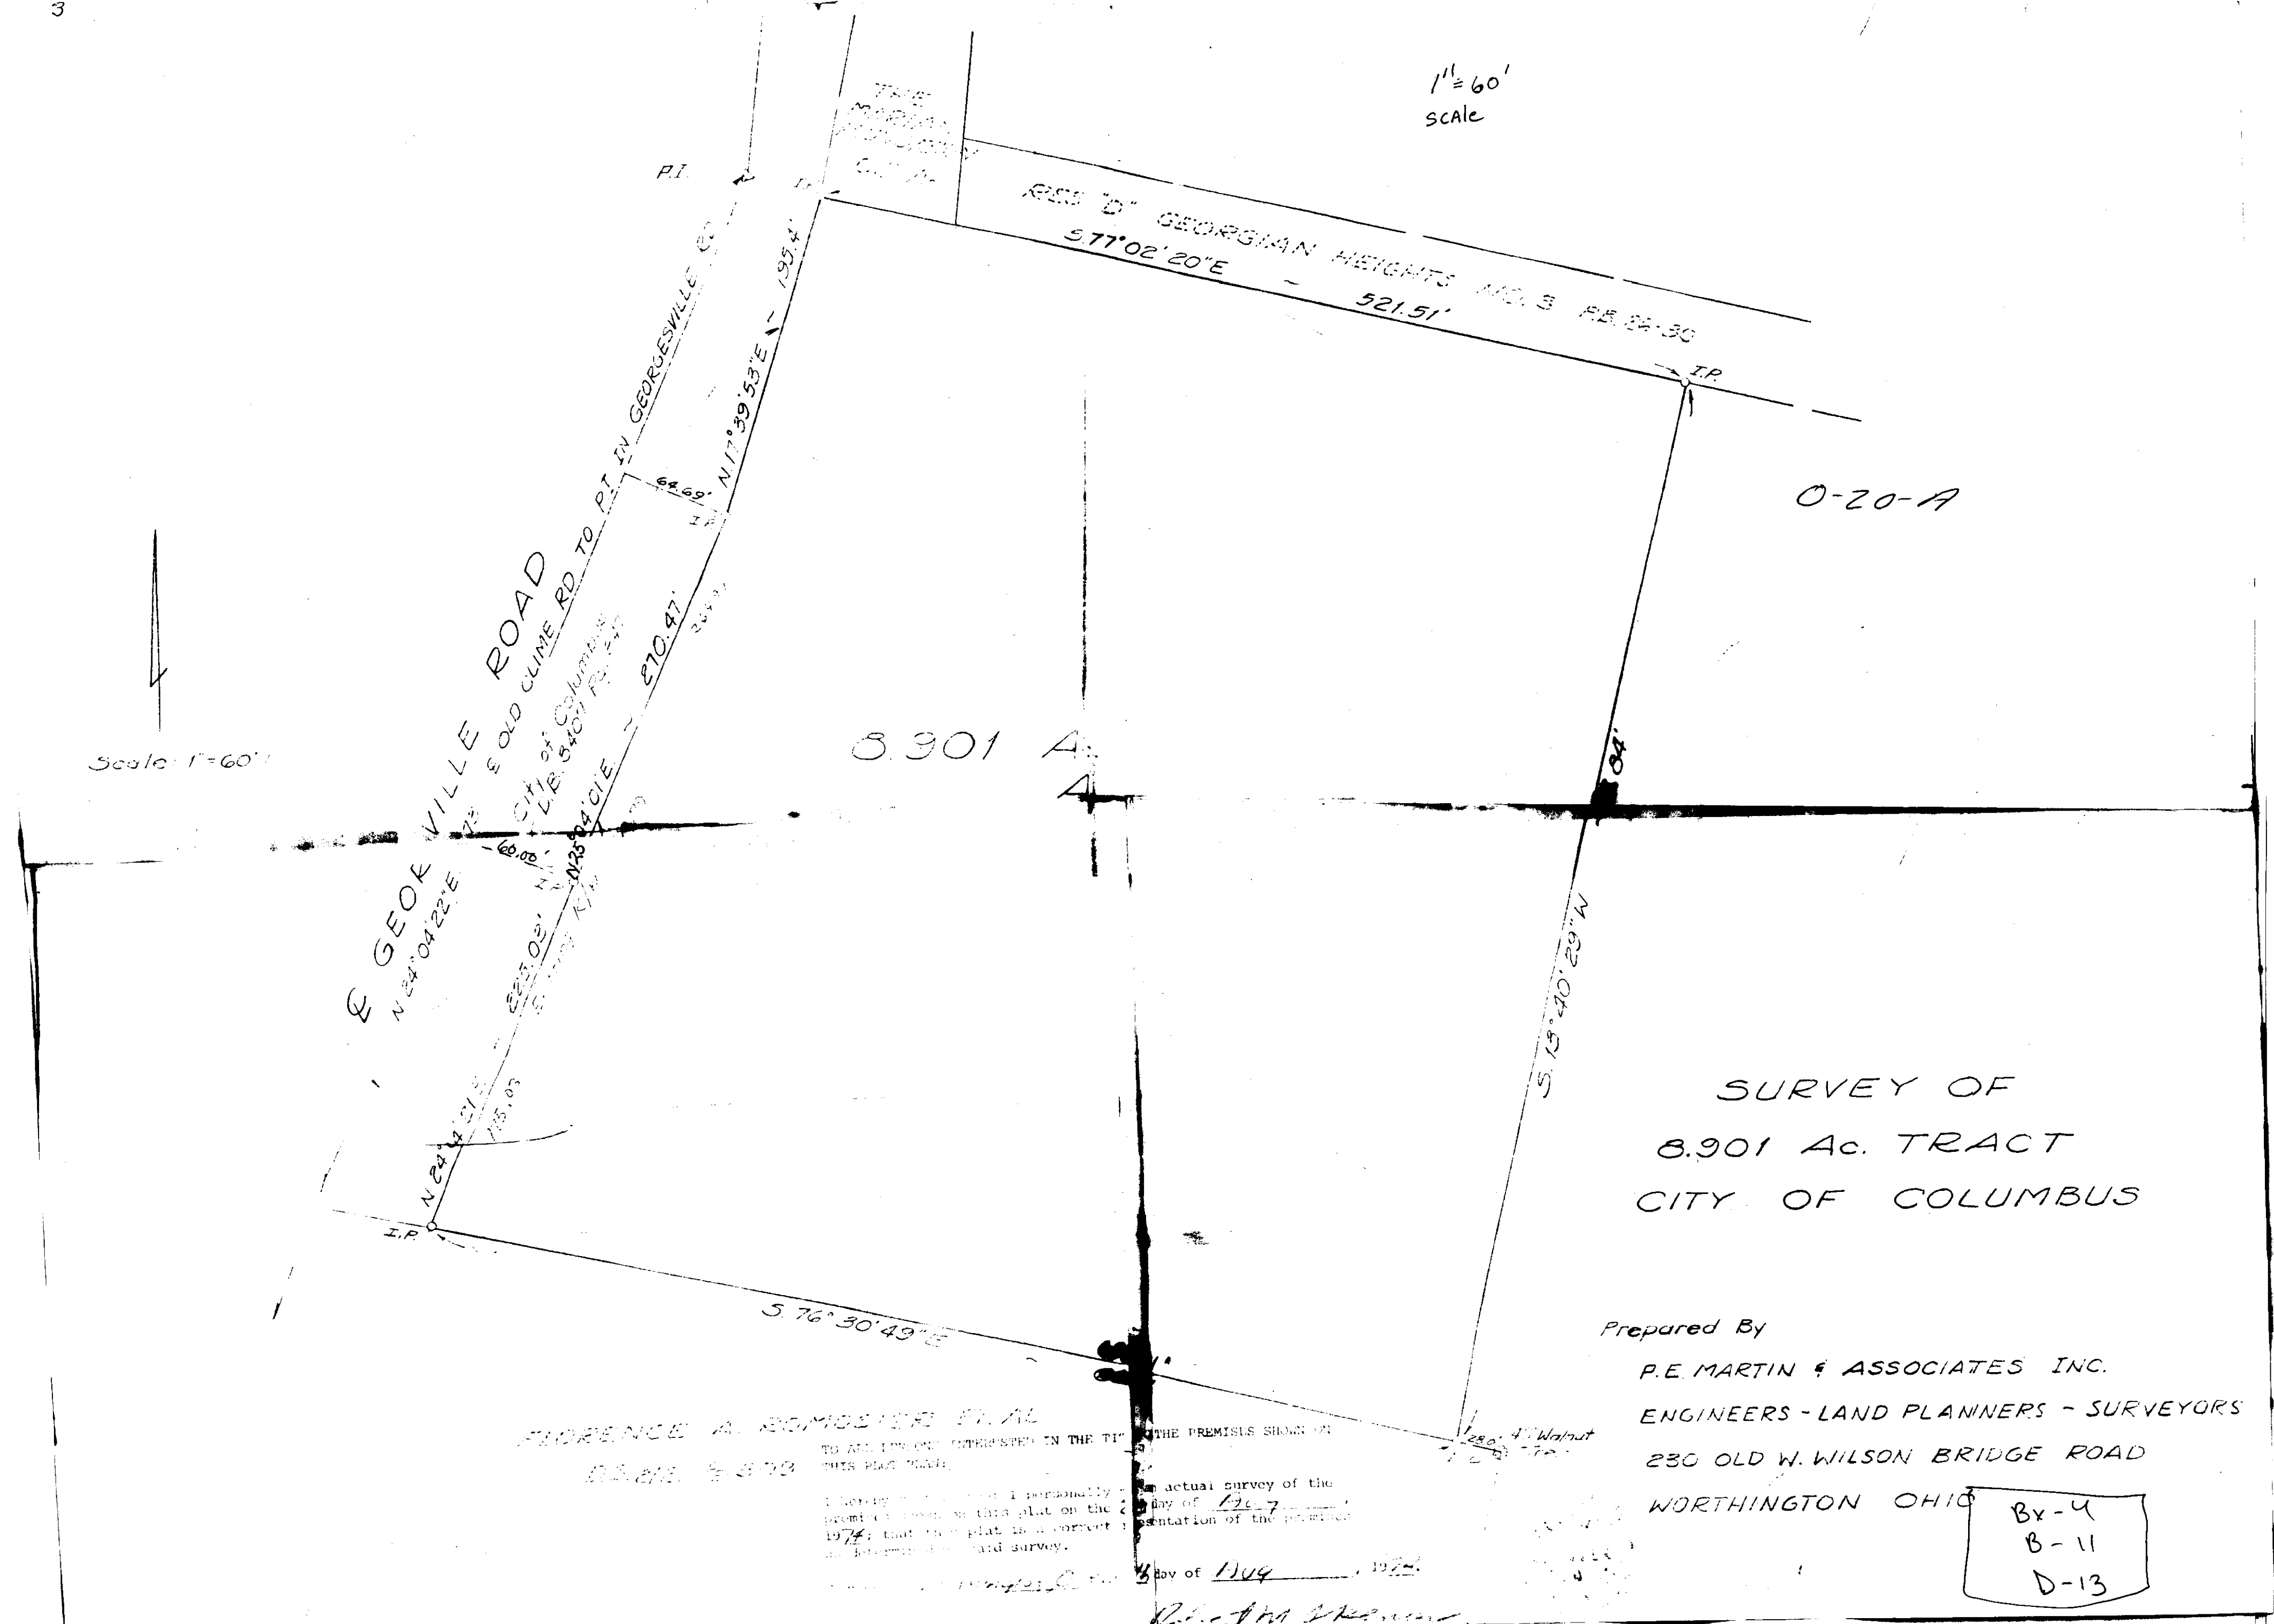

SURVEY OF  
8.901 Ac. TRACT  
CITY OF COLUMBUS

Prepared By  
P.E. MARTIN & ASSOCIATES INC.  
ENGINEERS - LAND PLANNERS - SURVEYORS  
230 OLD W. WILSON BRIDGE ROAD  
WORTHINGTON OHIO

Bx-4  
B-11  
D-13

FLORENCE A. ROMOSIDE ET AL  
8.901 Ac. Tract


Florence A. Romoside