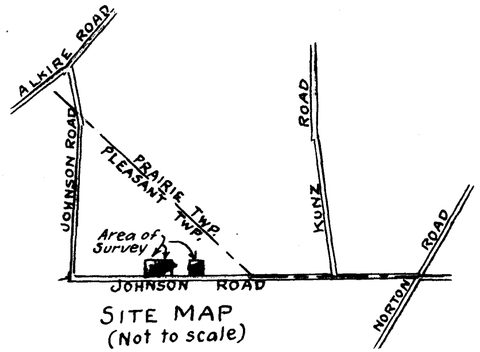

SITE MAP
(Not to scale)

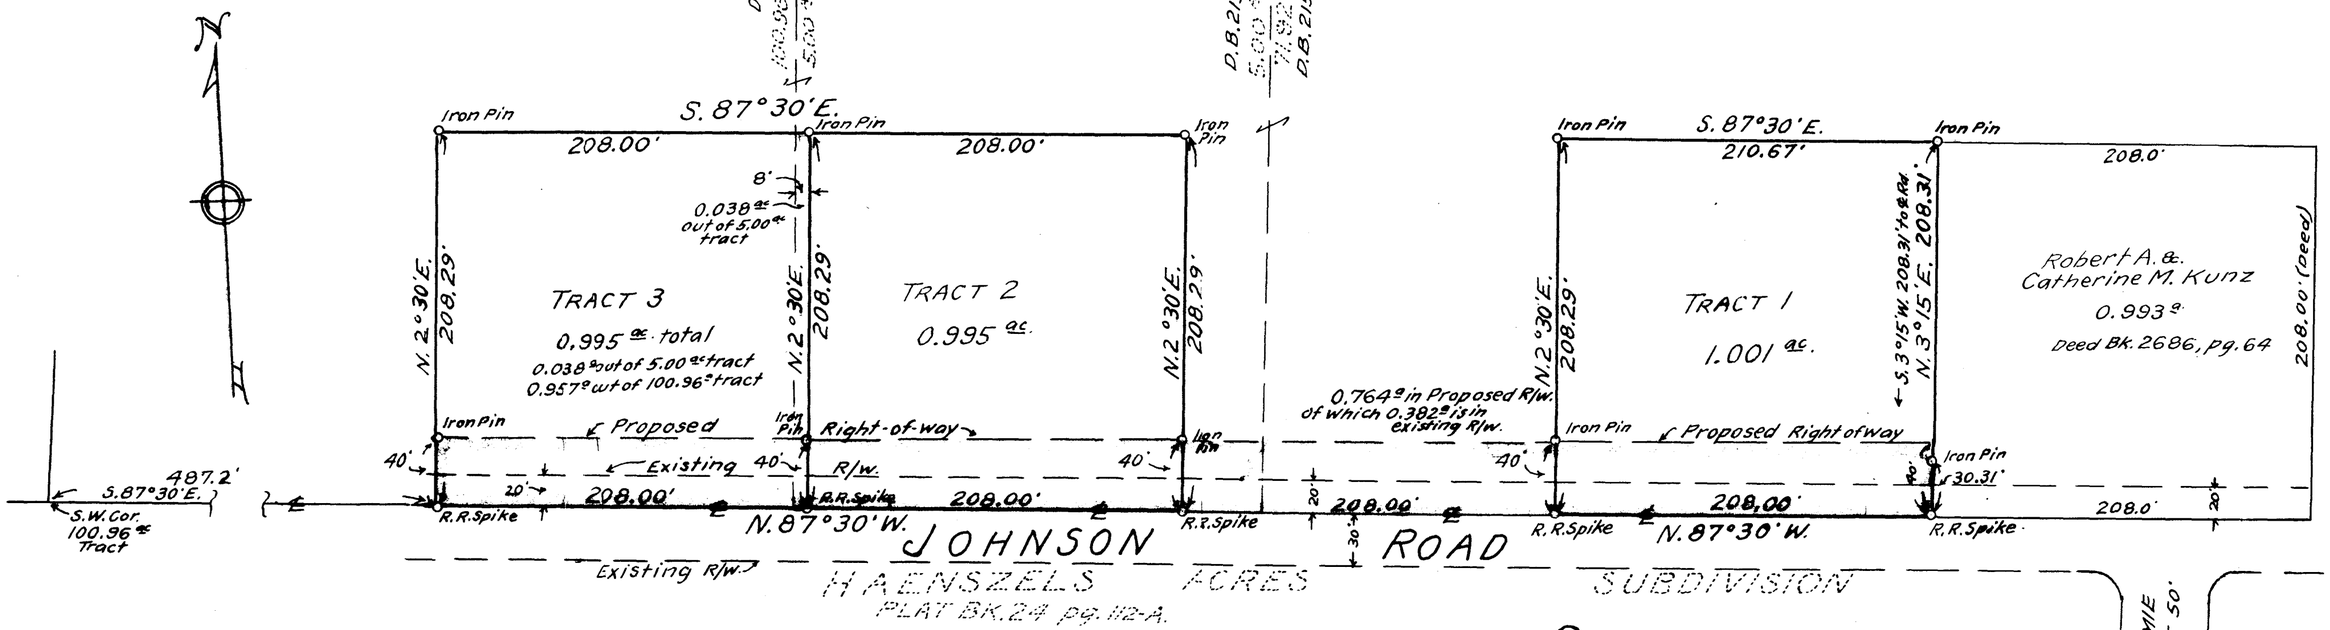

Reference; Being part of a 71.92 ac Deed Bk. 2154, pg. 450
Being part of a 5.00 ac Deed Bk. 2154, pg. 450
Being part of a 100.96 ac Deed Bk. 3148, pg. 696
0.957 ac out of 100.96 ac
1.033 ac out of 5.00 ac
1.001 ac out of 71.92 ac

HARVEY & PROBASCO
REGISTERED ENGINEERS & SURVEYORS

F. K. Harvey

SURVEY OF 3 TRACTS

VIR. MILITARY SURVEY NOS. 9222 & 10326
PLEASANT TWP. FRANKLIN COUNTY, OHIO
SCALE; 1" = 60'
AUG. 1973

2500 120 031 032 N JOHNSON RD 1973 0780 003 Compiled for; Mr. Frederick D. Kunz

0-78