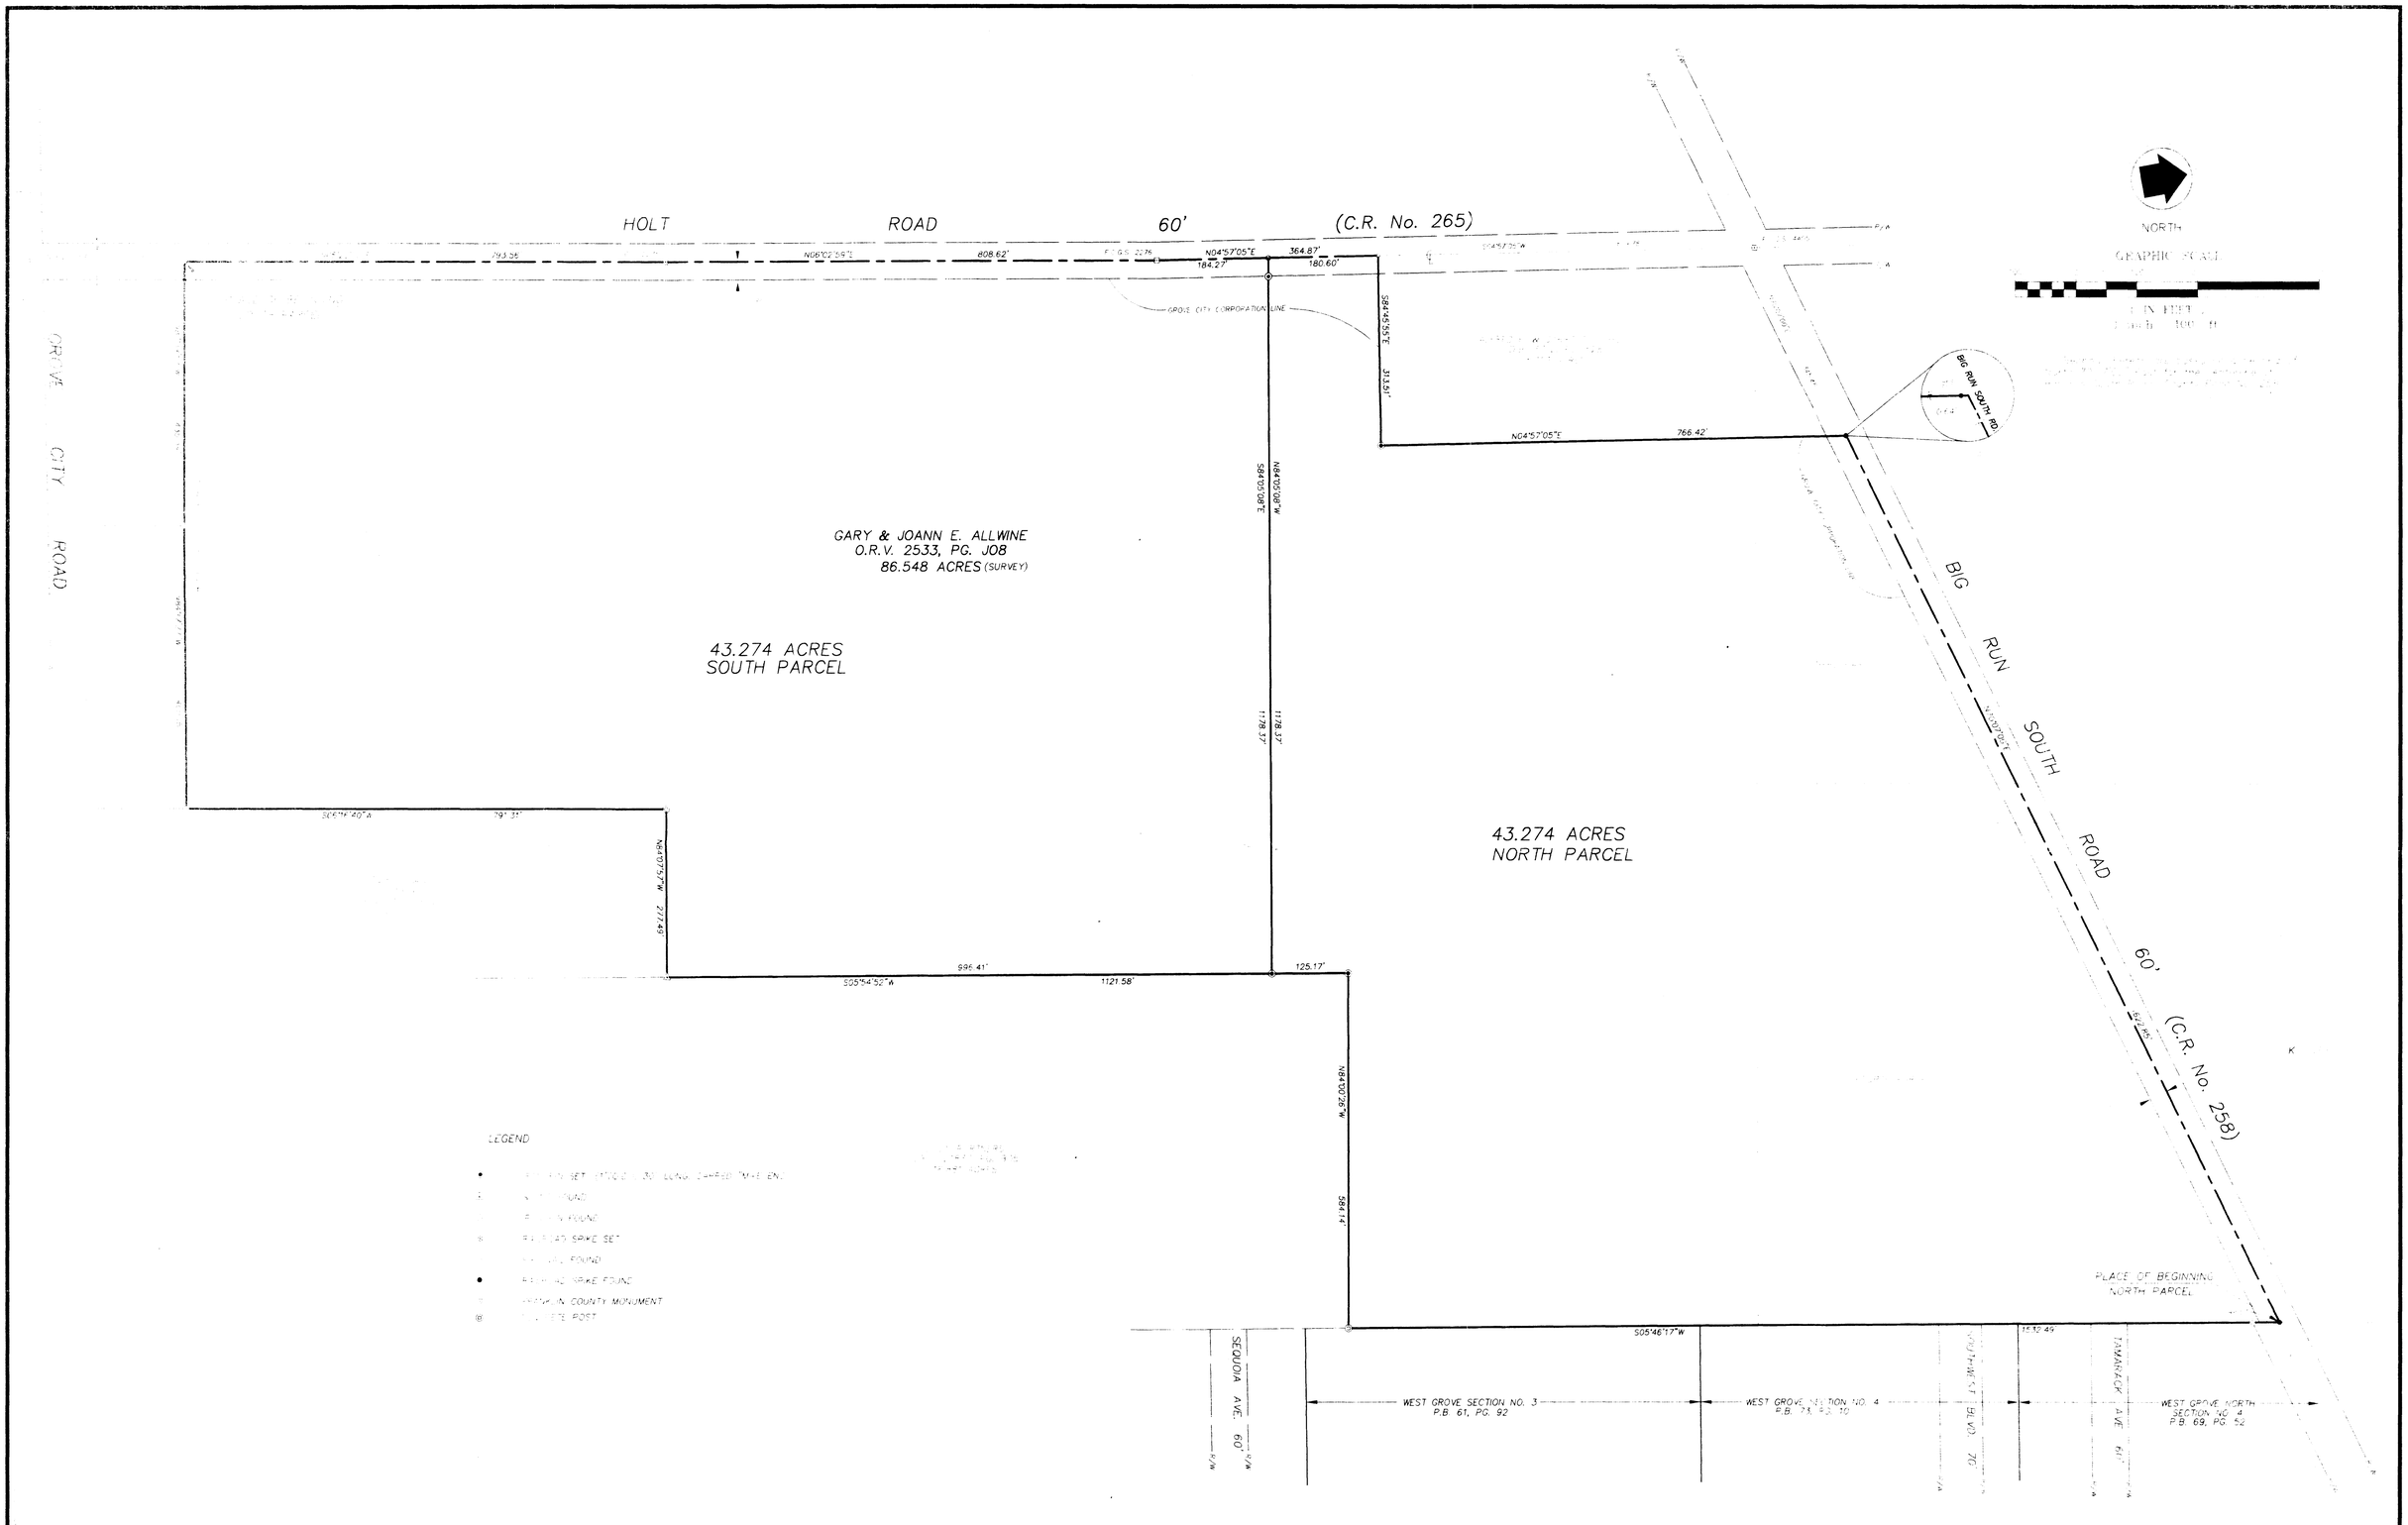

PRINT DATE	FIELD	PM	DRAWN
M-E ENGINEERING, INC.	EM	BW	DC
JUN 1 1994	SCALE	HORIZ 1"=100 VERT.	
PRINTED	JOB	543077-1-1-42	
	DATE	MAY 1994	
	SHEET NO.	1/1	

BOUNDARY SURVEY
PART OF V.M.S. No. 1388

ALLWINE PROPERTY
HOLT ROAD & BIG RUN SOUTH ROAD
GROVE CITY, OHIO

M-E ENGINEERING INC.
CIVIL DIVISION
500 SOUTH FRONT STREET
COLUMBUS, OHIO 43215
PHONE: (614) 469-4903
FAX: (614) 469-4989

REGISTERED SURVEYOR 6872 NO. 5/18/94 DATE

STATE OF OHIO ROBERT E. WAYNE 6872 REGISTERED SURVEYOR

REVISIONS		
DATE	BY	DESCRIPTION