



0-81-F

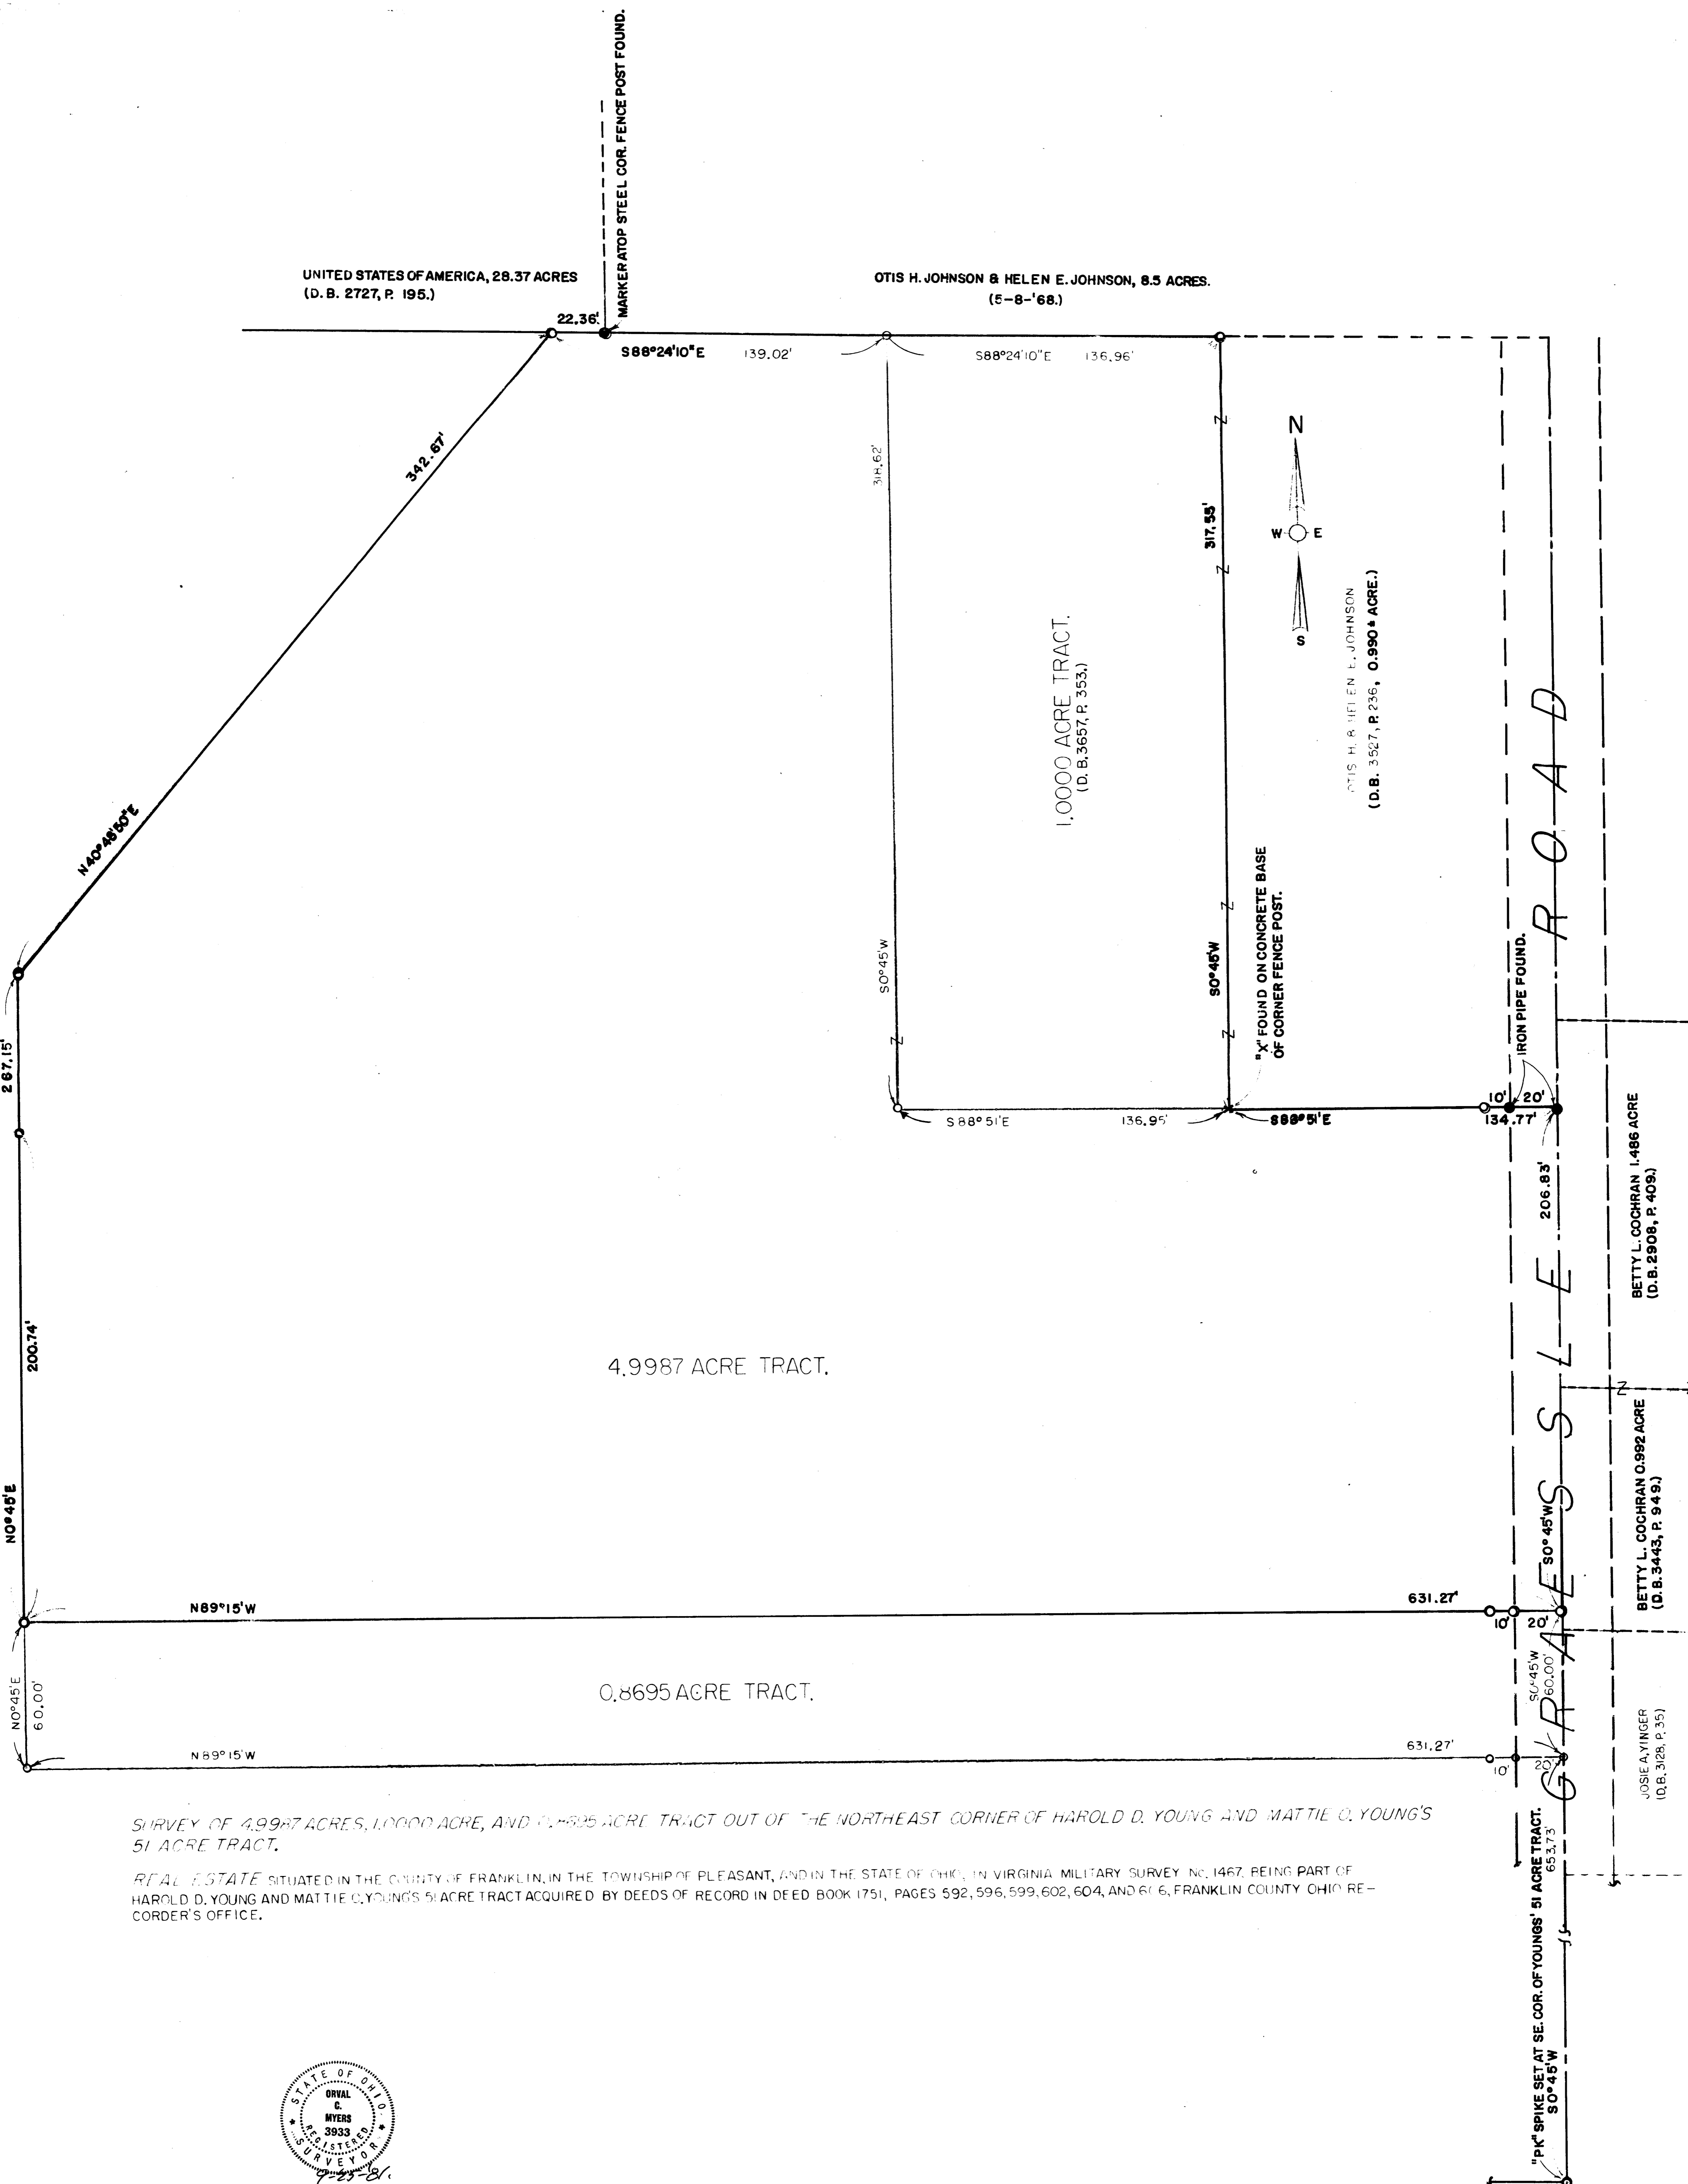

SURVEY OF 4.9987 ACRES, 1.0000 ACRE, AND 0.8695 ACRE TRACT OUT OF THE NORTHEAST CORNER OF HAROLD D. YOUNG AND MATTIE O. YOUNG'S 51 ACRE TRACT.

REAL ESTATE SITUATED IN THE COUNTY OF FRANKLIN, IN THE TOWNSHIP OF PLEASANT, AND IN THE STATE OF OHIO, IN VIRGINIA MILITARY SURVEY No. 1467, BEING PART OF HAROLD D. YOUNG AND MATTIE O. YOUNG'S 51 ACRE TRACT ACQUIRED BY DEEDS OF RECORD IN DEED BOOK 1751, PAGES 592, 596, 599, 602, 604, AND 616, FRANKLIN COUNTY OHIO RECORDER'S OFFICE.

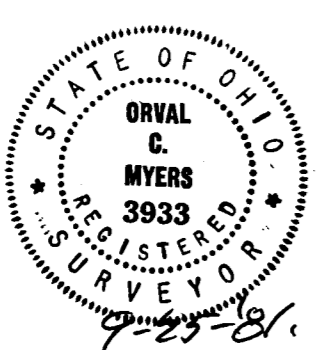

I CERTIFY THAT THIS DRAWING IS CORRECT.

Orval C. Myers
ORVAL C. MYERS, P. E.
REGISTERED SURVEYOR, OHIO No. 3933.

LEGEND

● IRON PIN (AS NOTED) FOUND.
○ IRON PIN SET.

SURVEYED & PLATTED BY

MYERS ENGINEERING CO.
CONSULTING ENGINEER
TEL. (614) 268-8624
498 OAKLAD PARK AVE.
COLUMBUS, OHIO 43214.

MECo. Dwg. No. 75-1020-1.
OCT. 20, 1975.
REV. MAY 15, 1978.
Rev. 7-25-81

SCALE: 1" = 30'.
NOTE: BEARINGS ARE BASED ON CENTERLINE OF ROAD AS 30°45'W FROM YOUNG'S DEED.