PROPERTY SURVEY FOR HUGH L. McKINLEY

Situated in the State of Ohio, County of Franklin, Township of Pleasant, and being part of Virginia Military Survey No. 1467, and being also part of a 101.63 Acre Tract belonging to HUGH L. McKINLEY, said 101.63 Acre Tract being Parcel No. 2 as recorded in Deed Book 1716, Page 529, Recorder's Office, Franklin County, Ohio

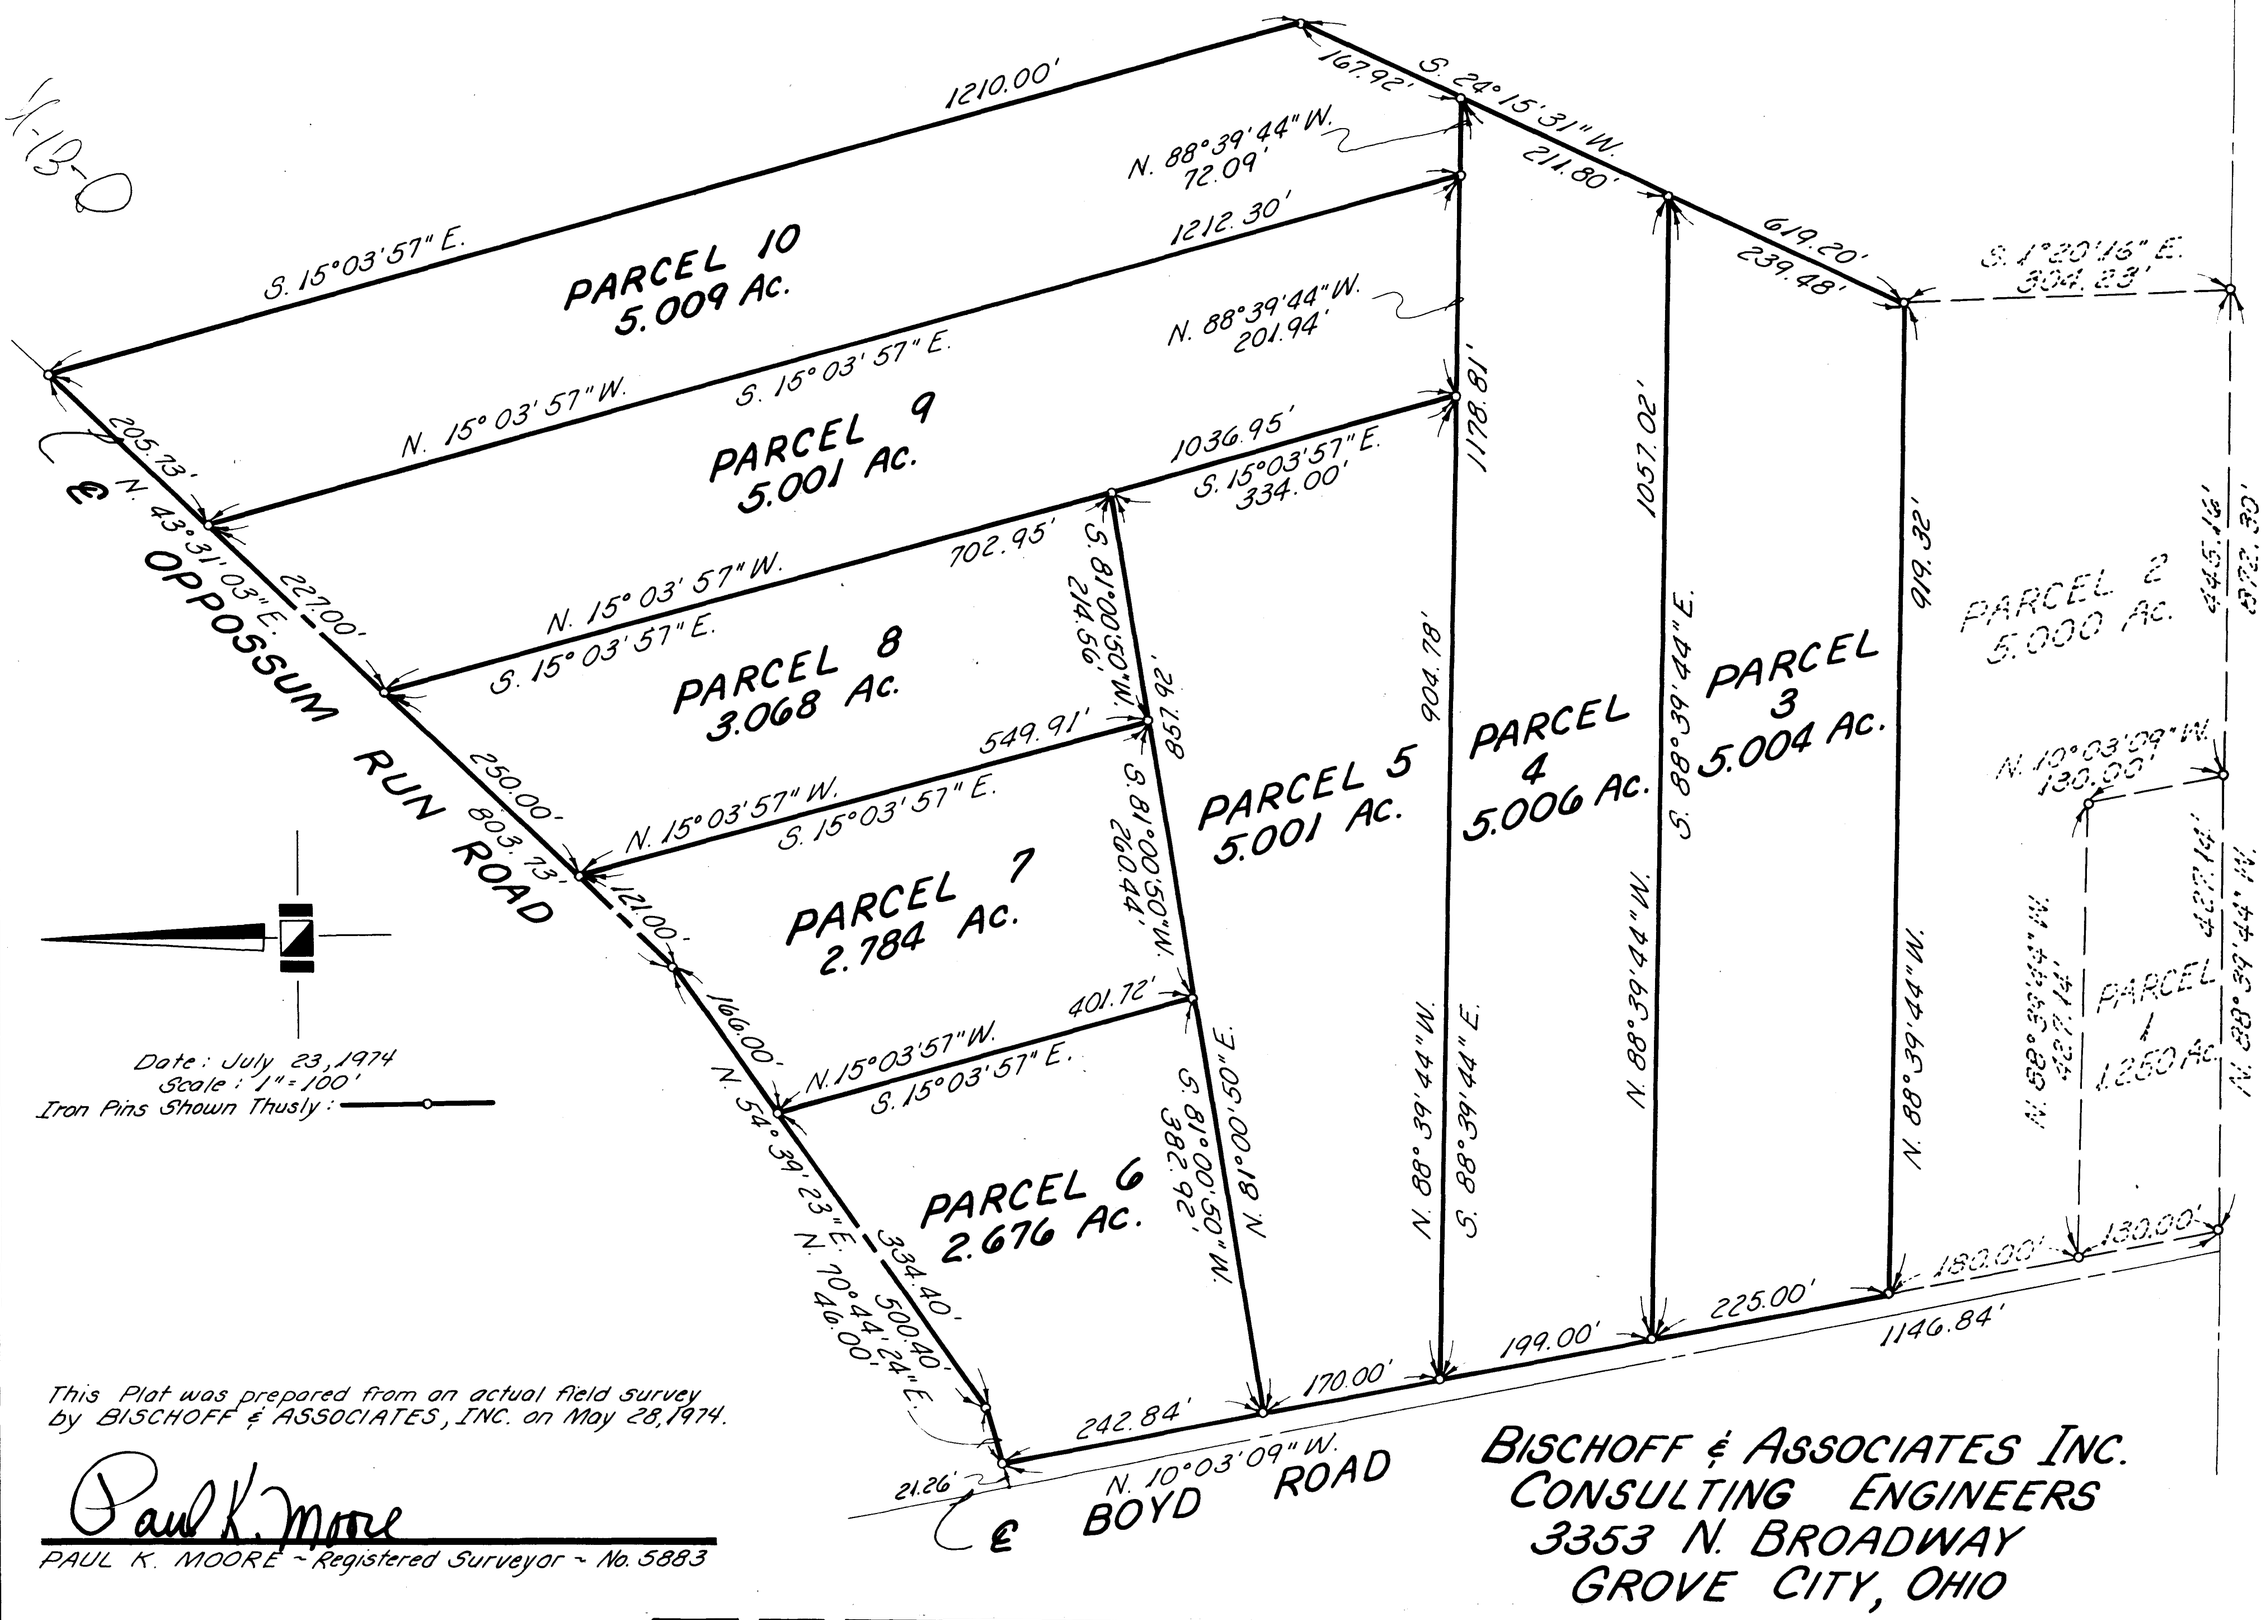

This Plat was prepared from an actual field survey by BISCHOFF & ASSOCIATES, INC. on May 28, 1974.

Paul K. Moore

PAUL K. MOORE ~ Registered Surveyor ~ No. 5883

BISCHOFF & ASSOCIATES INC.
CONSULTING ENGINEERS
3353 N. BROADWAY
GROVE CITY, OHIO

0400 120 026 030 S OPOSSUM RUN RD 1974 0810 030