
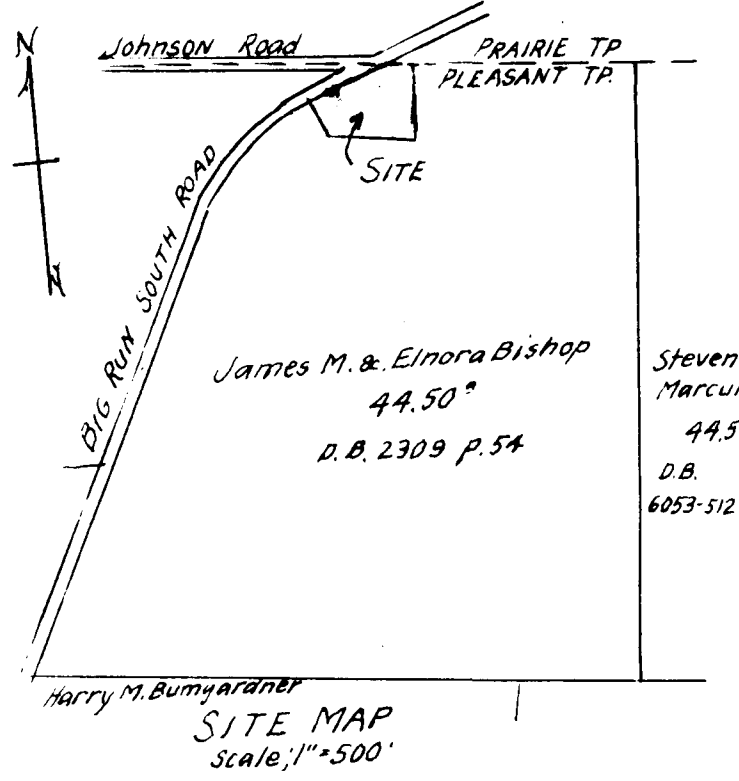


Reference: Being part of a 44½[±] tract as conveyed to James M. Bishop and Elnora M. Bishop by certificate of transfer in the matter of the Estate of William Galle, deceased as recorded in Deed Bk. 2309, pg. 54

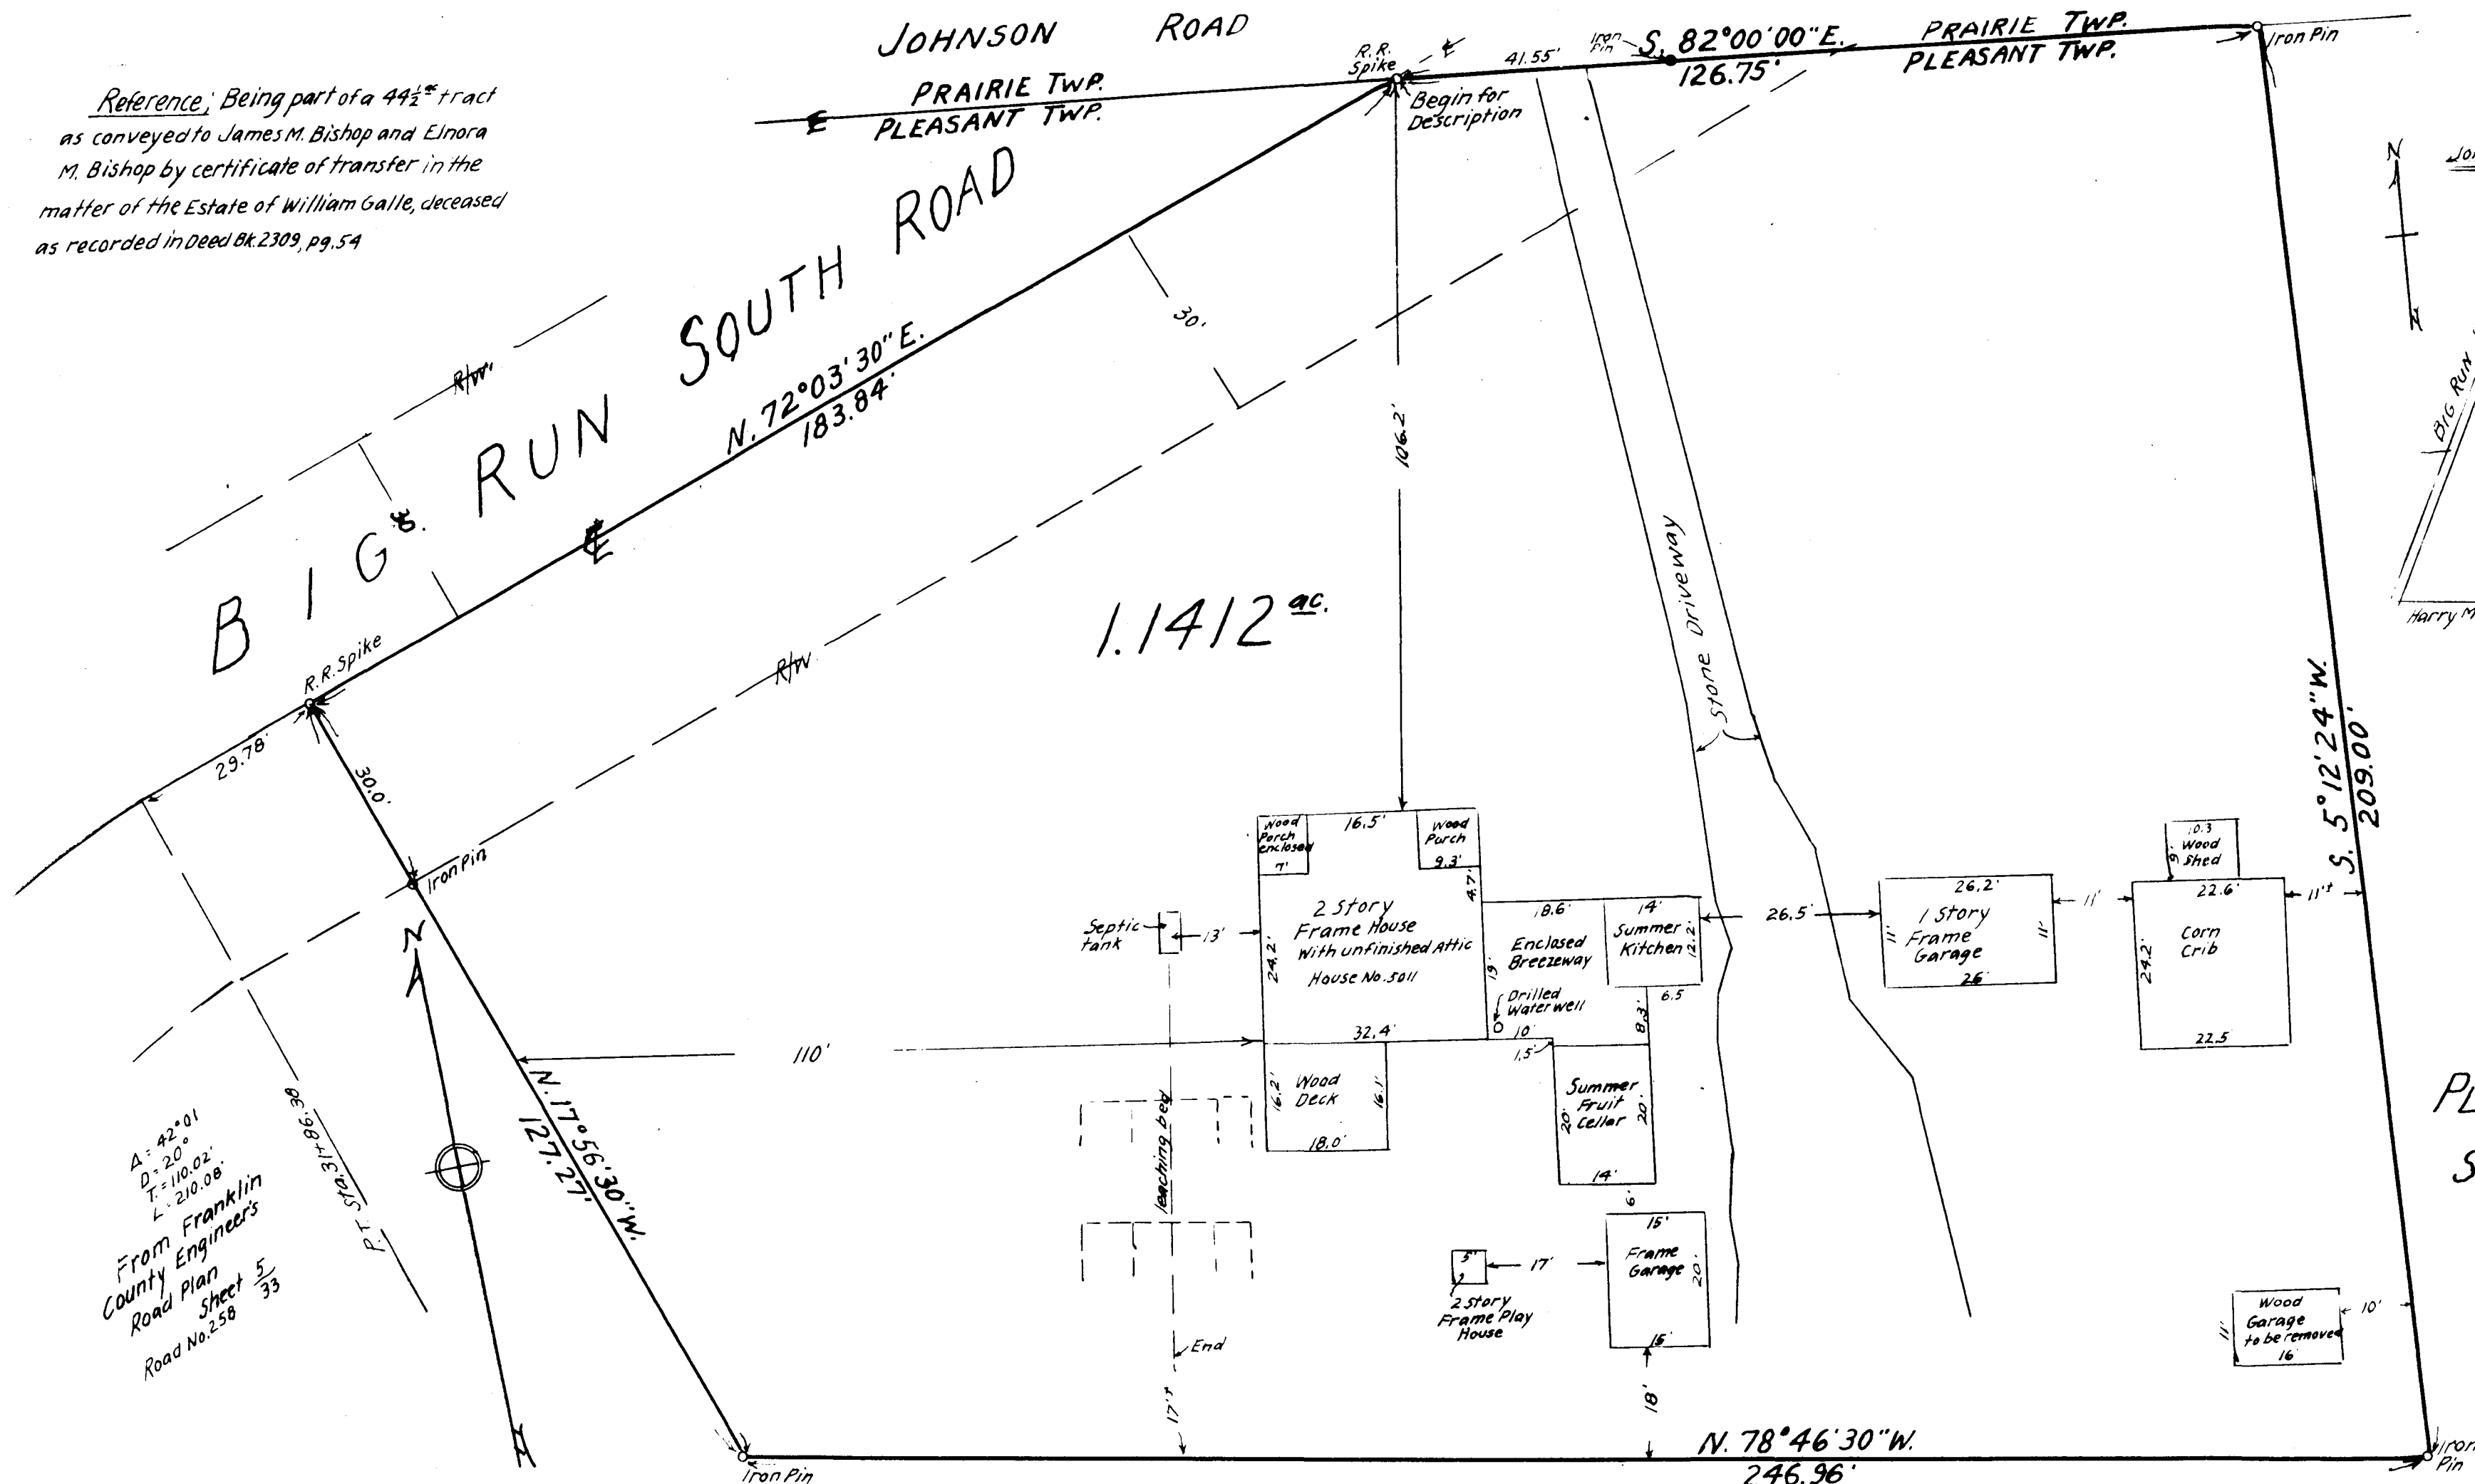

SURVEY OF 1.1412^{ac.}
VIRGINIA MILITARY SURVEY #1448
PLEASANT TWP. FRANKLIN COUNTY, OHIO
SCALE: 1" = 20'
SEPT. 1986

Surveyed for - Mr. James M. Bishop

F. K. Harvey
 Registered Surveyor No. 2570

A = 42.01
 D = 20.00
 T = 110.02
 L = 210.08
 From Franklin County Engineers' Road Plan Sheet 5/33 Road No. 258

James M. & Elnora Bishop
 44.50 D.B. 2309 p. 54