


DETAIL CURTAIN DRAIN (NOT TO SCALE)

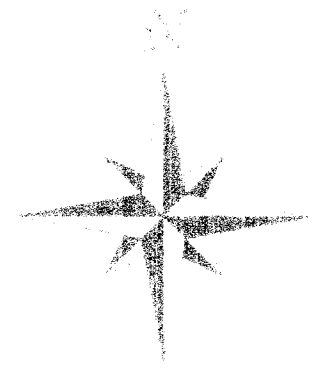

0 100 200 400  
SCALE 1" = 200"

- SET 5/8" REBAR
- △ SET PK NAIL
- ▲ EXISTING R/R SPIKE
- EXISTING I. PINS
- FRANKLIN CO. MON.

VIRGINIA MILITARY SURVEY  
NO. 8440 & 8614

RUSSELL E. PHILLIPPI  
BOOK 33278 PAGE 817  
& 199902240047203

BARBARA J. McDANIELS  
BOOK 3449 PAGE 380

Barbara J. Mc Daniels  
12-22-77  
H-3223  
BOOK 3629 PAGE 21

ANNE M. KNESELY  
BOOK 2312 PAGE 198

BASE LINE FOR BEARINGS  
N 53°30'19"E  
2130.06'

BOOK 3085  
PAGE 667

NOTE: THIS TRACT SURVEYED  
SEP. 15th, 2000

FRANKLIN CO.  
MON. BOX

56.411 ACRES

CURTAIN DRAIN  
(SEE DETAIL)

H-3309  
Nellie Smith  
6-16-70

H-3343  
Jack E. Smith & Sandra L.  
6-4-86  
BOOK 3740 PAGE 321

TOM W SMITH  
BOOK 3740 PG.318  
5-30-85

H-3343  
Carolyn S. Smith  
7-20-79  
BOOK 3740 PAGE 315

H-4299  
BOOK 3065  
PAGE 667

H-3343  
Rollin J. & Shirley  
Baugess  
BOOK 3080 PAGE 313

WRIGHTSVILLE ROAD (60' WIDE)

LAND SURVEY  
PLAT OF SURVEY MADE FOR  
NELLIE SMITH ESTATE  
SHOWING A LARGE TRACT OF LAND  
LYING IN PLEASANT TOWNSHIP FRANKLIN  
COUNTY OHIO. AND BEING IN VIRGINIA  
MILITARY SURVEY NO. 8440 & NO. 8614  
SURVEY MADE DURING FEBURARY 1998

*David E Slagle* 05/03/2001


DAVID E. SLAGLE  
REG. P.S. OHIO SURVEYOR  
# 7408



NOTE:  
2.500 ACRE TRACT SURVEYED  
FOR MARK & MELISSA SCHEEL  
SEP. 15, 2000

CURTAIN DRAIN SURVEYED  
NOV. 16, 2000  
F.B. 115 PG. 16

WITNESS TIES-NOT TO SCALE

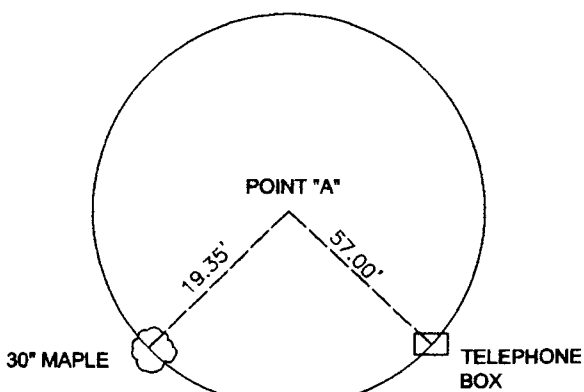

P.O.B.

REFERENCE POINT  
(FRANKLIN CO. MON. BOX)

ARTHUR E. & C.L. CHAMPLIN  
BOOK 23241 PAGE 1-04

FOR: SMITH ESTATE



DATE: 9/20/2000	JOB NO 20-189
SCALE: 1" = 200'	F.B NO 27
REVISED: 4/2/2001	MAP NO 20-189



**SURVEY SERVICE**  
3958 La Rosa Ct.  
GROVE CITY OH 43123  
FAX: 614-875-7862 PH: 614-871-4980

DRAWN BY: M.P.G.
CKD BY: D.E.S.
CAD FILE 20-189