


NEFF ROAD 40' Road Record 8, Pg. 343 (1860)

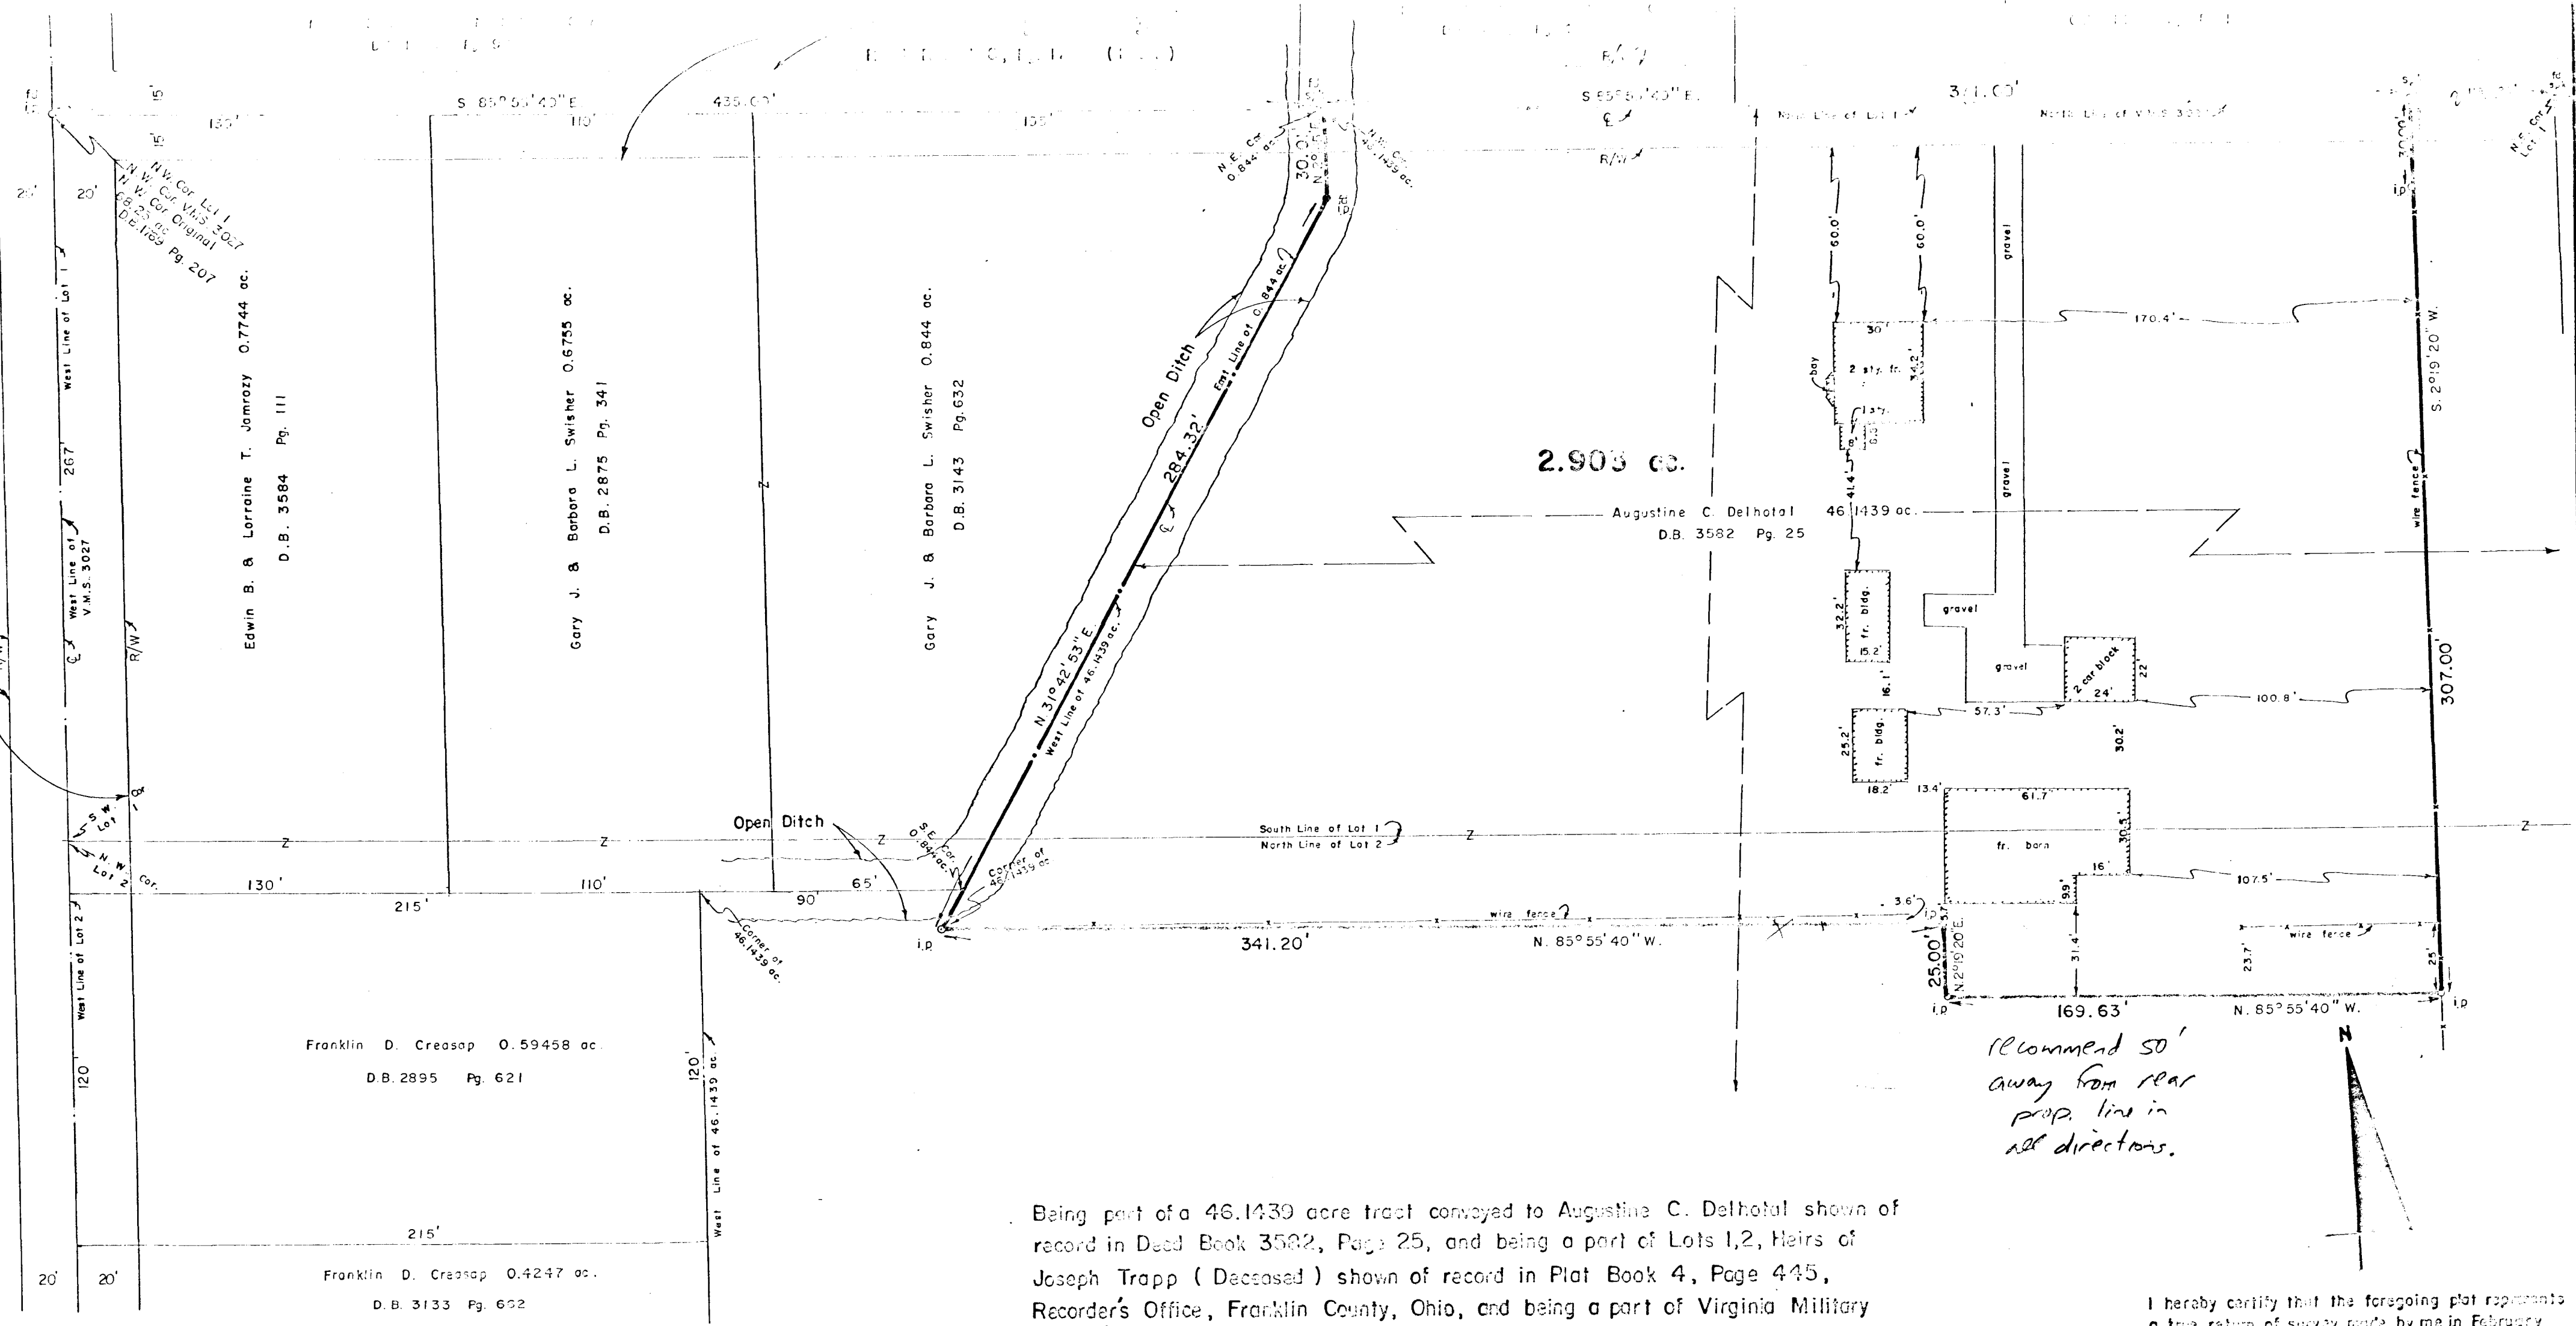

Recommend 50' away from rear prop. line in all directions.

Being part of a 46.1439 acre tract conveyed to Augustina C. Delhotel shown of record in Deed Book 3582, Page 25, and being a part of Lots 1,2, Heirs of Joseph Trapp (Deceased) shown of record in Plat Book 4, Page 445, Recorder's Office, Franklin County, Ohio, and being a part of Virginia Military Survey # 3027, Pleasant Township, Franklin County, Ohio.

- - iron pin or spike found
- - spike set
- - 1" x 30" iron pin set

Basis of bearings shown are from Deed Book 3143, Page 632
Subject Property is Zoned R-2

Scale 1" = 40'
February 3, 1982
Rev. August 5, 1982

For

MRS. EDITH WILSON

I hereby certify that the foregoing plat represents a true return of survey made by me in February 1982.

Albert H. Andrews
Albert H. Andrews Registered Surveyor 5629
Miers Surveying Company
Civil Engineer and Surveyor
Berkley, Ohio, 44010

