

Being all of a 13.28 acre tract (by deed), and 15.237 acre tract (by survey) conveyed to Norman L. Tracy shown of record in Official Record 954, Page H-05, Recorder's Office, Franklin County, Ohio, and being a part of Virginia Military Surveys 2596, 2597, partly in Pleasant Township, and partly in The Village of Darbydale, Franklin County, Ohio

For
NORMAN L. TRACY

Scale 1" = 100'

October 12, 1981


Revised February 5, 1982

Bearings shown were established from Franklin County Road Plats.
Iron Pin shown are 1" x 30" solid iron pins.
Spikes shown are Railroad Spikes.

I hereby certify that the foregoing plat represents a true return of survey made by me in October 1981.

Clark E. Andrews
Clark E. Andrews, Registered Surveyor #5700

CLARK E. ANDREWS
126 N. CHASE AVENUE
COLUMBUS, OHIO 43204

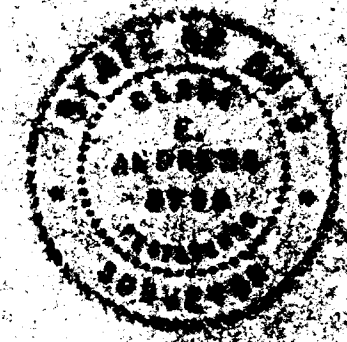

186.25
630.88
817.13