




SCALE
1"=50'

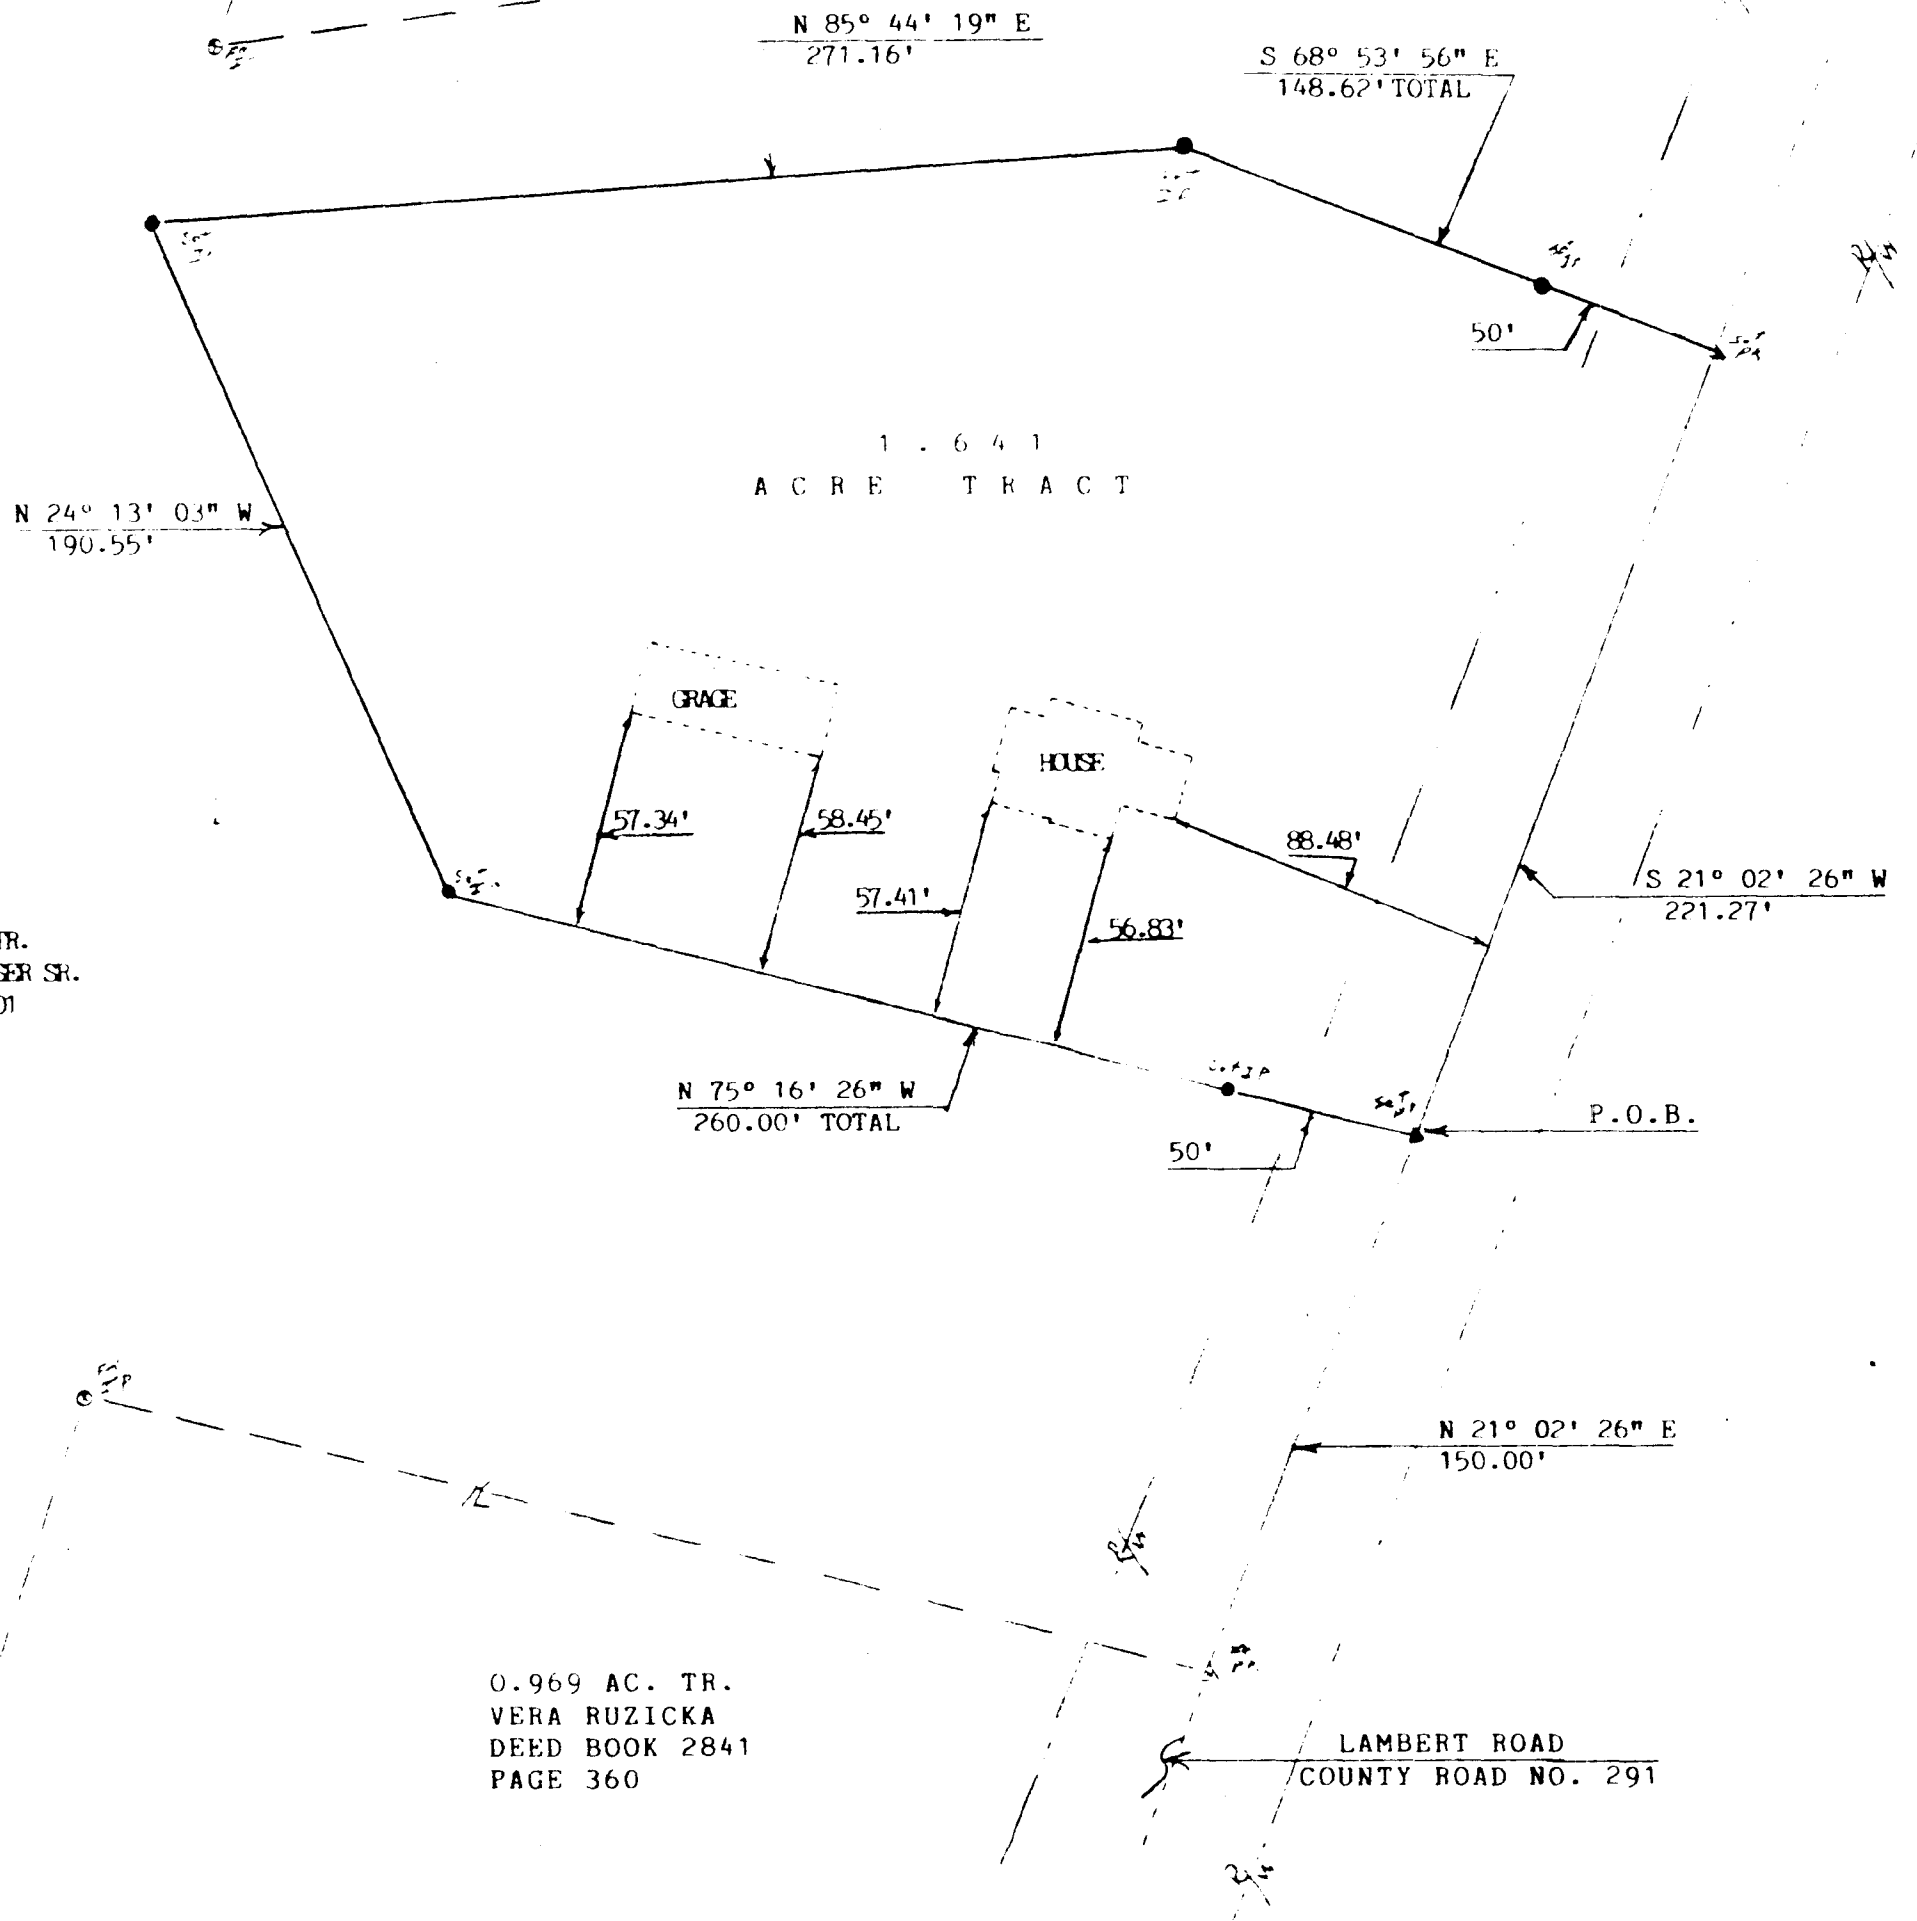

PROPERTY PLAT

PLAT DRAWING OF A 1.641 ACRE TRACT, BEING A PART OF VIRGINIA MILITARY SURVEY NO. 497, PLEASANT TOWNSHIP, FRANKLIN COUNTY, STATE OF OHIO.

NOTE

BEING A PORTION OF THE PROPERTY OF FREDERICK P. RIESER SR. O.R. 18726J01 AS DELINEATED IN THE FRANKLIN COUNTY RECORDERS OFFICE. ALL IRON PINS SET BEING 1/2\"/>


LEGEND

- ▲ FOUND P.K. NAIL
- ▲ SET P.K. NAIL
- SET IRON PIN & I.D. CAP
- ⊙ FOUND IRON PIN

BASED ON A ACTUAL SURVEY OF THE PREMISES IN FEBRUARY 1992, UNDER THE DIRECT SUPERVISION OF W. ROYCE HORTON P.S. 5465.

W. Royce Horton

DATE 03-04-92

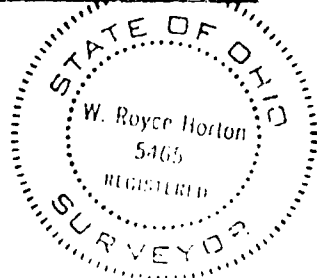

GENERAL LOCATION

