


# SURVEY OF 145.331 ACRE TRACT

LOCATED IN  
 VIRGINIA MILITARY SURVEYS No. 1405, 1466 & 2595  
 PLEASANT TOWNSHIP, FRANKLIN COUNTY, OHIO

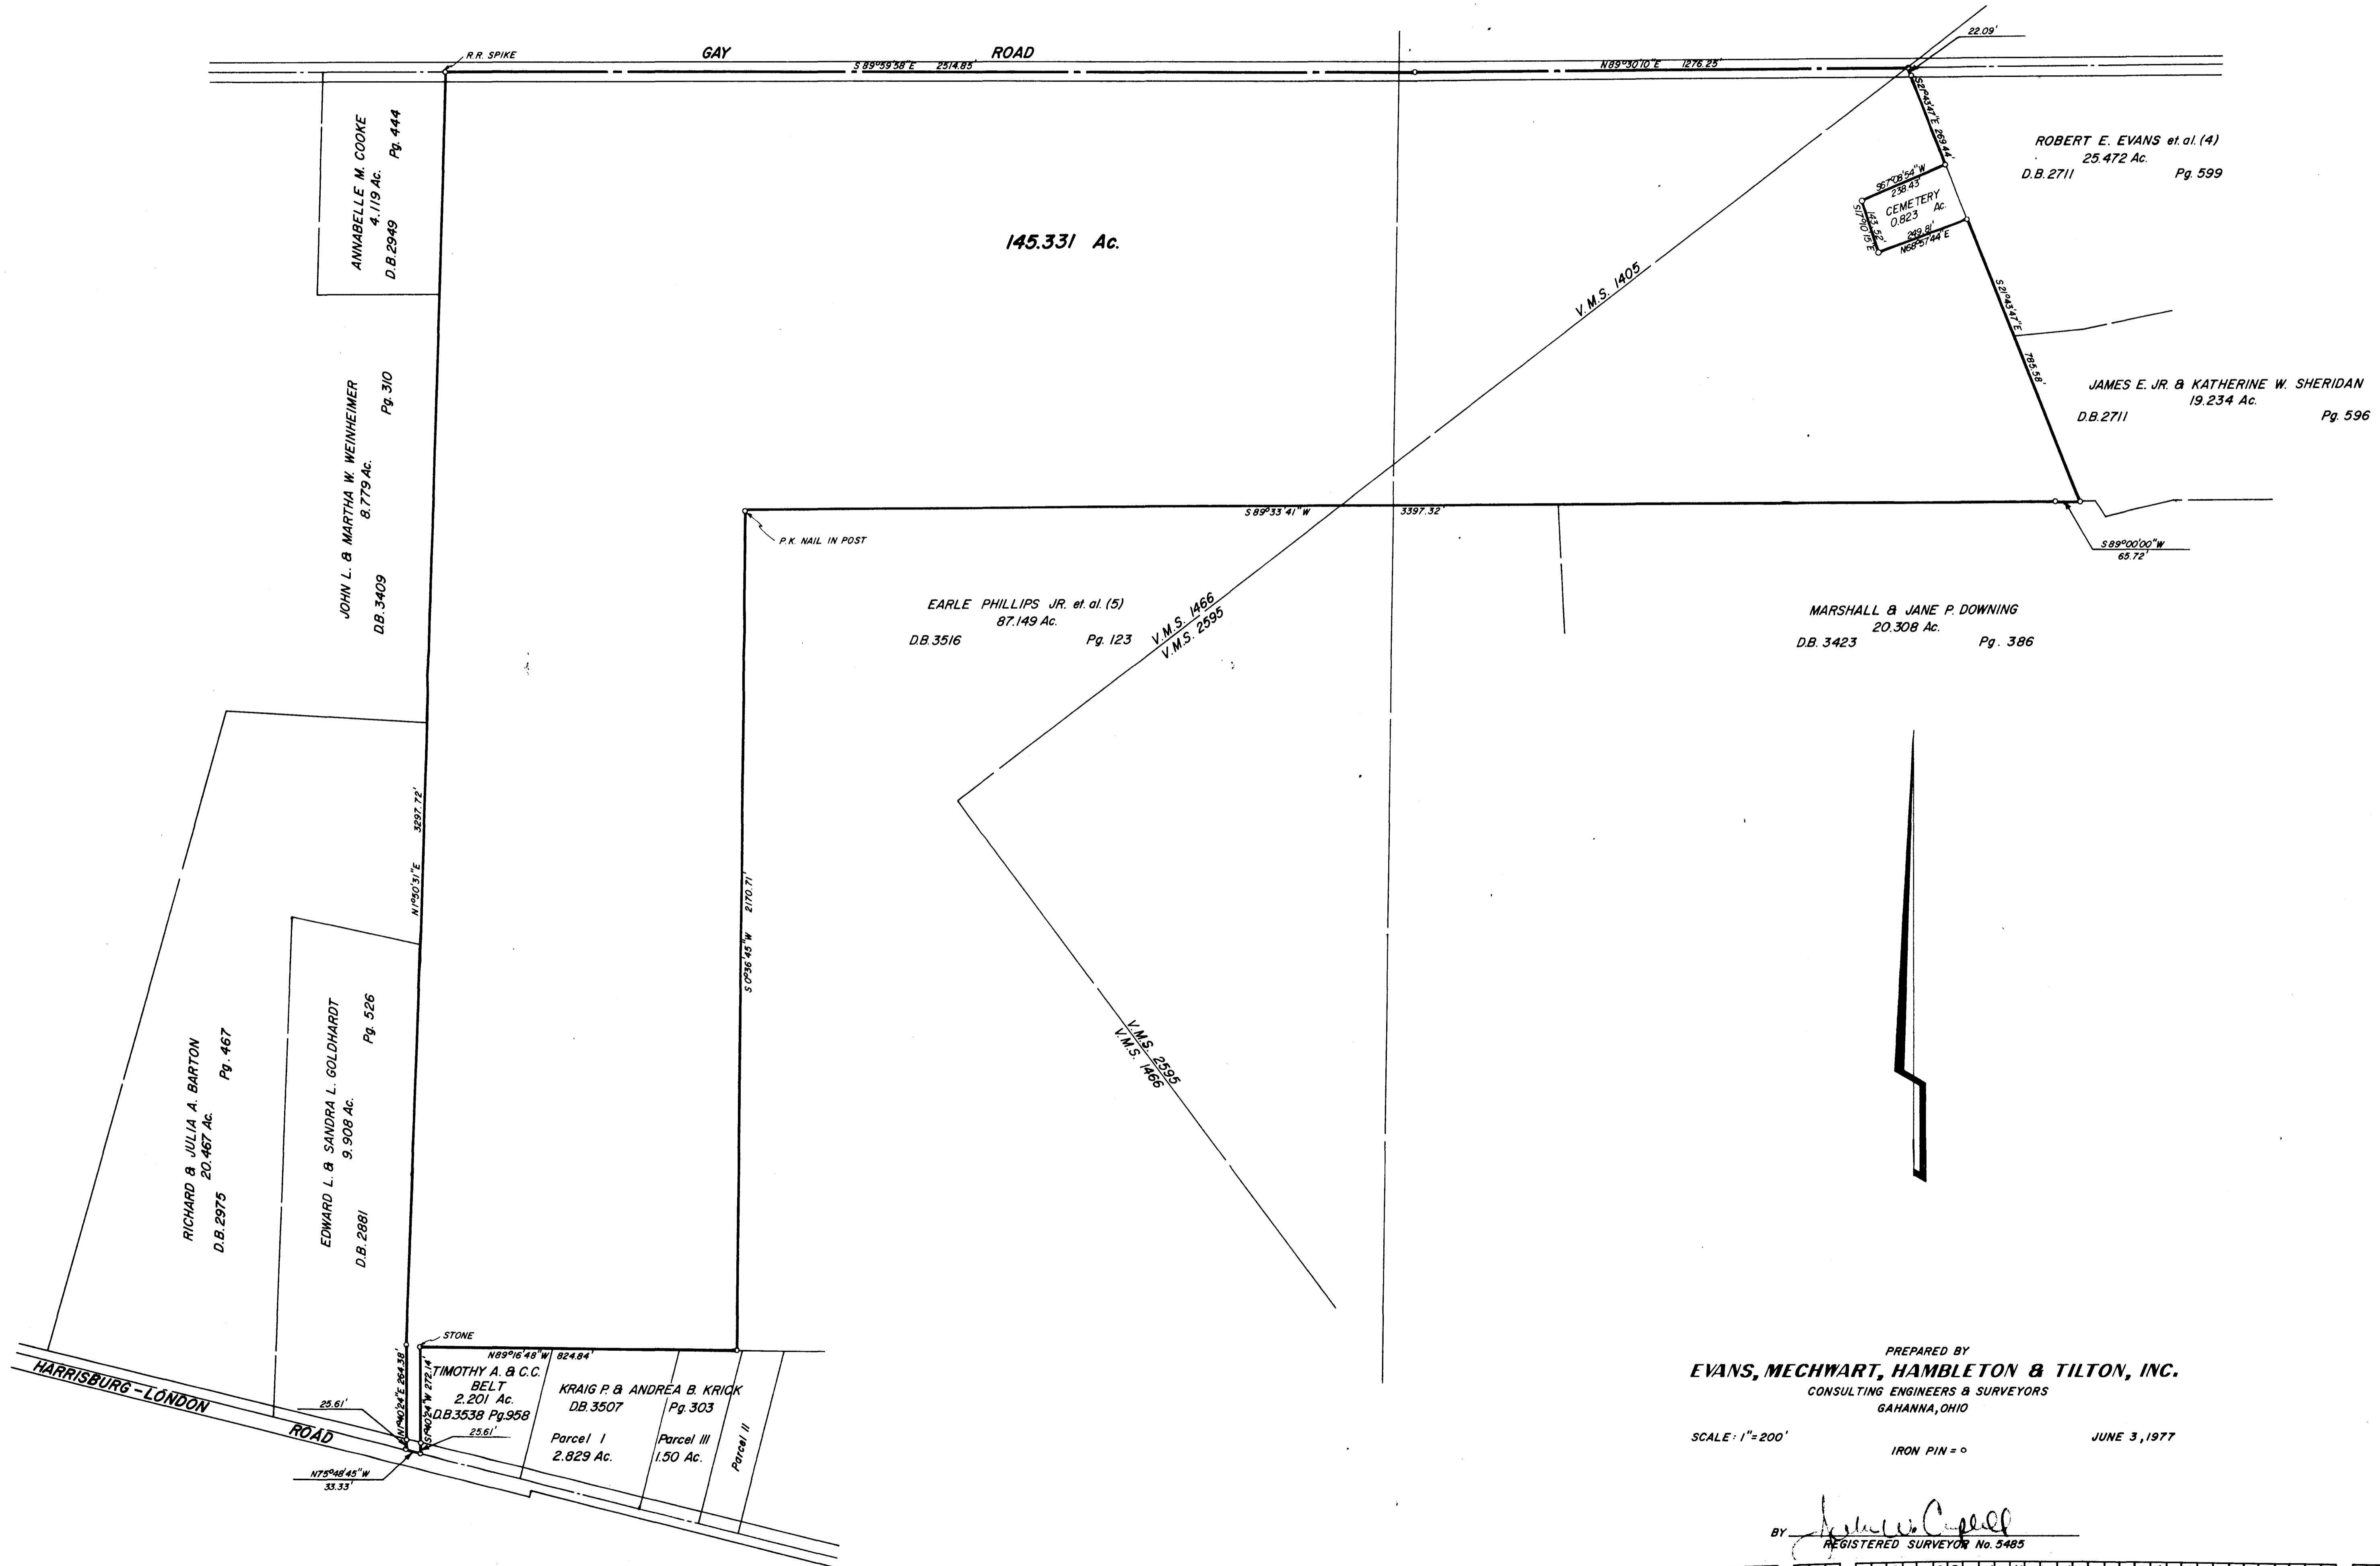

PREPARED BY  
**EVANS, MECHWART, HAMBLETON & TILTON, INC.**  
 CONSULTING ENGINEERS & SURVEYORS  
 GAHANNA, OHIO

SCALE: 1" = 200'      IRON PIN = ◯      JUNE 3, 1977

BY *Robert C. Capell*  
 REGISTERED SURVEYOR No. 5485

0-8-6-A

2030 120 098 039 W HARRISBURG LONDON RD 1977 0861 03