


53.15
54.1
46.1
84.371
70.129

DELAWARE COUNTY FRANKLIN COUNTY
CONC. MON. 1905.28' 1654.28' S 89° 24' E
COLUMBUS METROPOLITAN PARK BOARD

3857.87 2052.39
S 89° 24' 00" E
DELAWARE COUNTY FRANKLIN COUNTY
2068.02
N 89° 24' 00" W
55.28
99.28

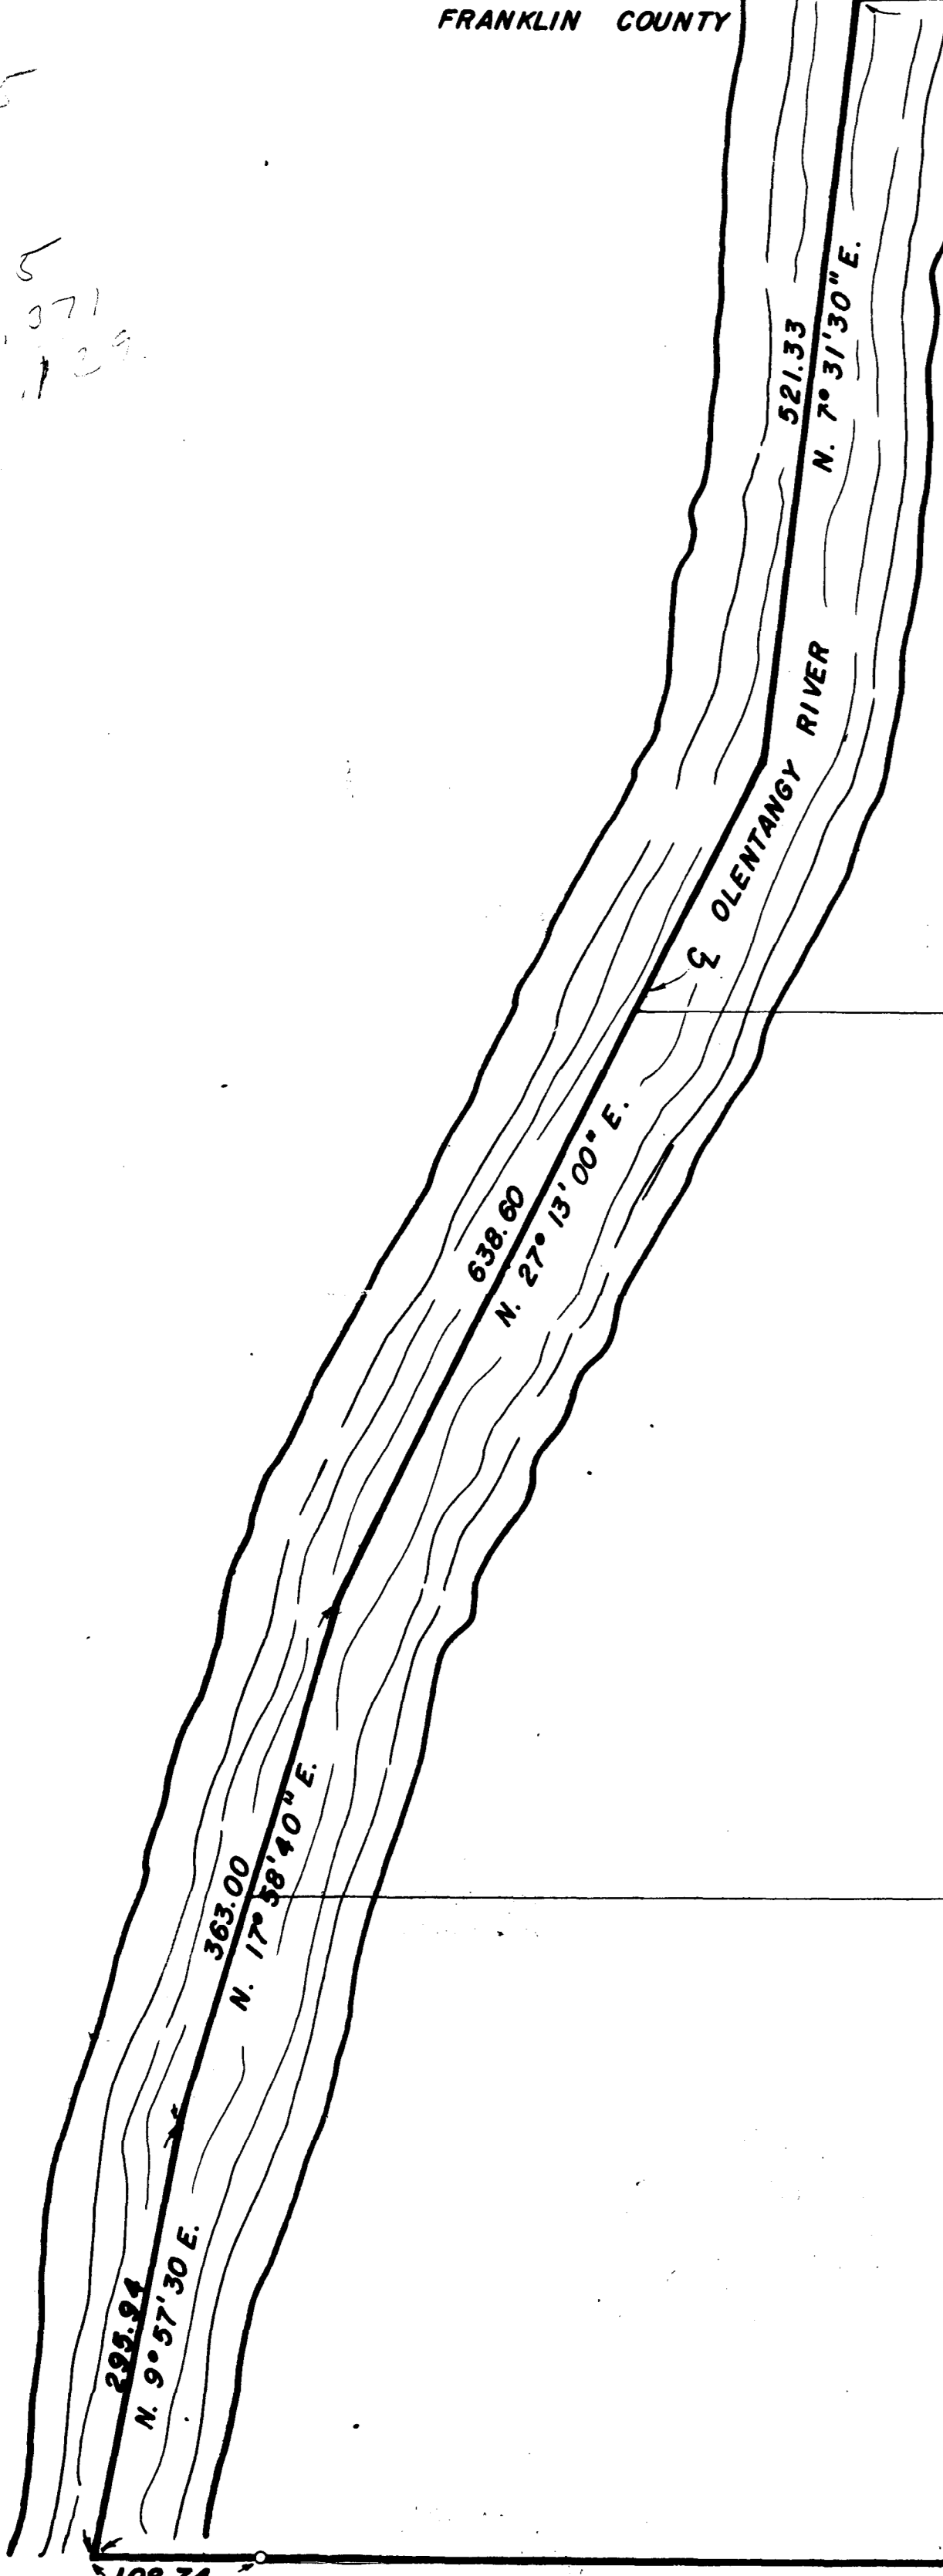

LOT 50

54.5 ACRES

LOT 49

54.0 ACRES

~~89.098~~ ACRES

MARIE B. CAREN

D.B. 1071

PAGES 100-102

84.371

LOT 49

54.0 ACRES

LOT 48

46 ACRES

SURVEY of 89.098 ACRES
LOCATED IN LOTS 48, 49, & 50
IN THE SECOND TIER OF OUTLOTS
IN SECTION 2, TOWNSHIP 2, RANGE 18
UNITED STATES MILITARY LANDS
SHARON TOWNSHIP, FRANKLIN COUNTY, OHIO

SCALE 1" = 100'

* Iron Pin Set

* Iron Pin Found

39.074
4.727
93.925

SURVEYED & PLATTED

BY

EVANS MECHWART HAMBLETON & TILTON
CIVIL ENGINEERS & SURVEYORS
GAHANNA, OHIO

BY *[Signature]*
REGISTERED SURVEYOR # 483

Revised March 10, 1945

5864
↓
5715

100.00
47.10
149.50

93.925
34.21

179.176

108.74
2348.33
N 88° 54' 06" W

EVANS INVESTMENT COMPANY
D.B. 1781 PAGE 330

COLUMBUS SANDUSKY ROAD
ROUTE 23
S 51° 05' 00" E

19-05