

N. HIGH STREET
(U.S. RT. 23)



Scale 1" = 40'
November 17, 1986

Basis of bearings is the south line of College Heights Addition.
Iron pins set are 1" (O.D.) by 30" pipes with orange plastic caps
stamped "PS 3352."


I here by certify that the foregoing plat
represents a true return of a survey
made by me in August, 1984.

by Albert J. Myers
Albert J. Myers Registered Surveyor # 6679

MYERS SURVEYING COMPANY, INC.
2740 East Main Street
Columbus, (Bexley), Ohio

Survey of 0.091 Ac. & 1.483 Ac. tract (part of a 1.519 Acre tract, Deed Book 1693, Page 406,
and part of a 7.97 Acre tract, Deed Book 1702, Page 502, Recorder's Office,
Franklin County, Ohio, conveyed to Miriam R. Frasch), located in Form Lots 42 and
43, Quarter Township 2, Township 2, Range 18, United States Military Lands,
Sharon Township, Franklin County, Ohio.

For
HUNTINGTON NATIONAL BANK, EXECUTOR

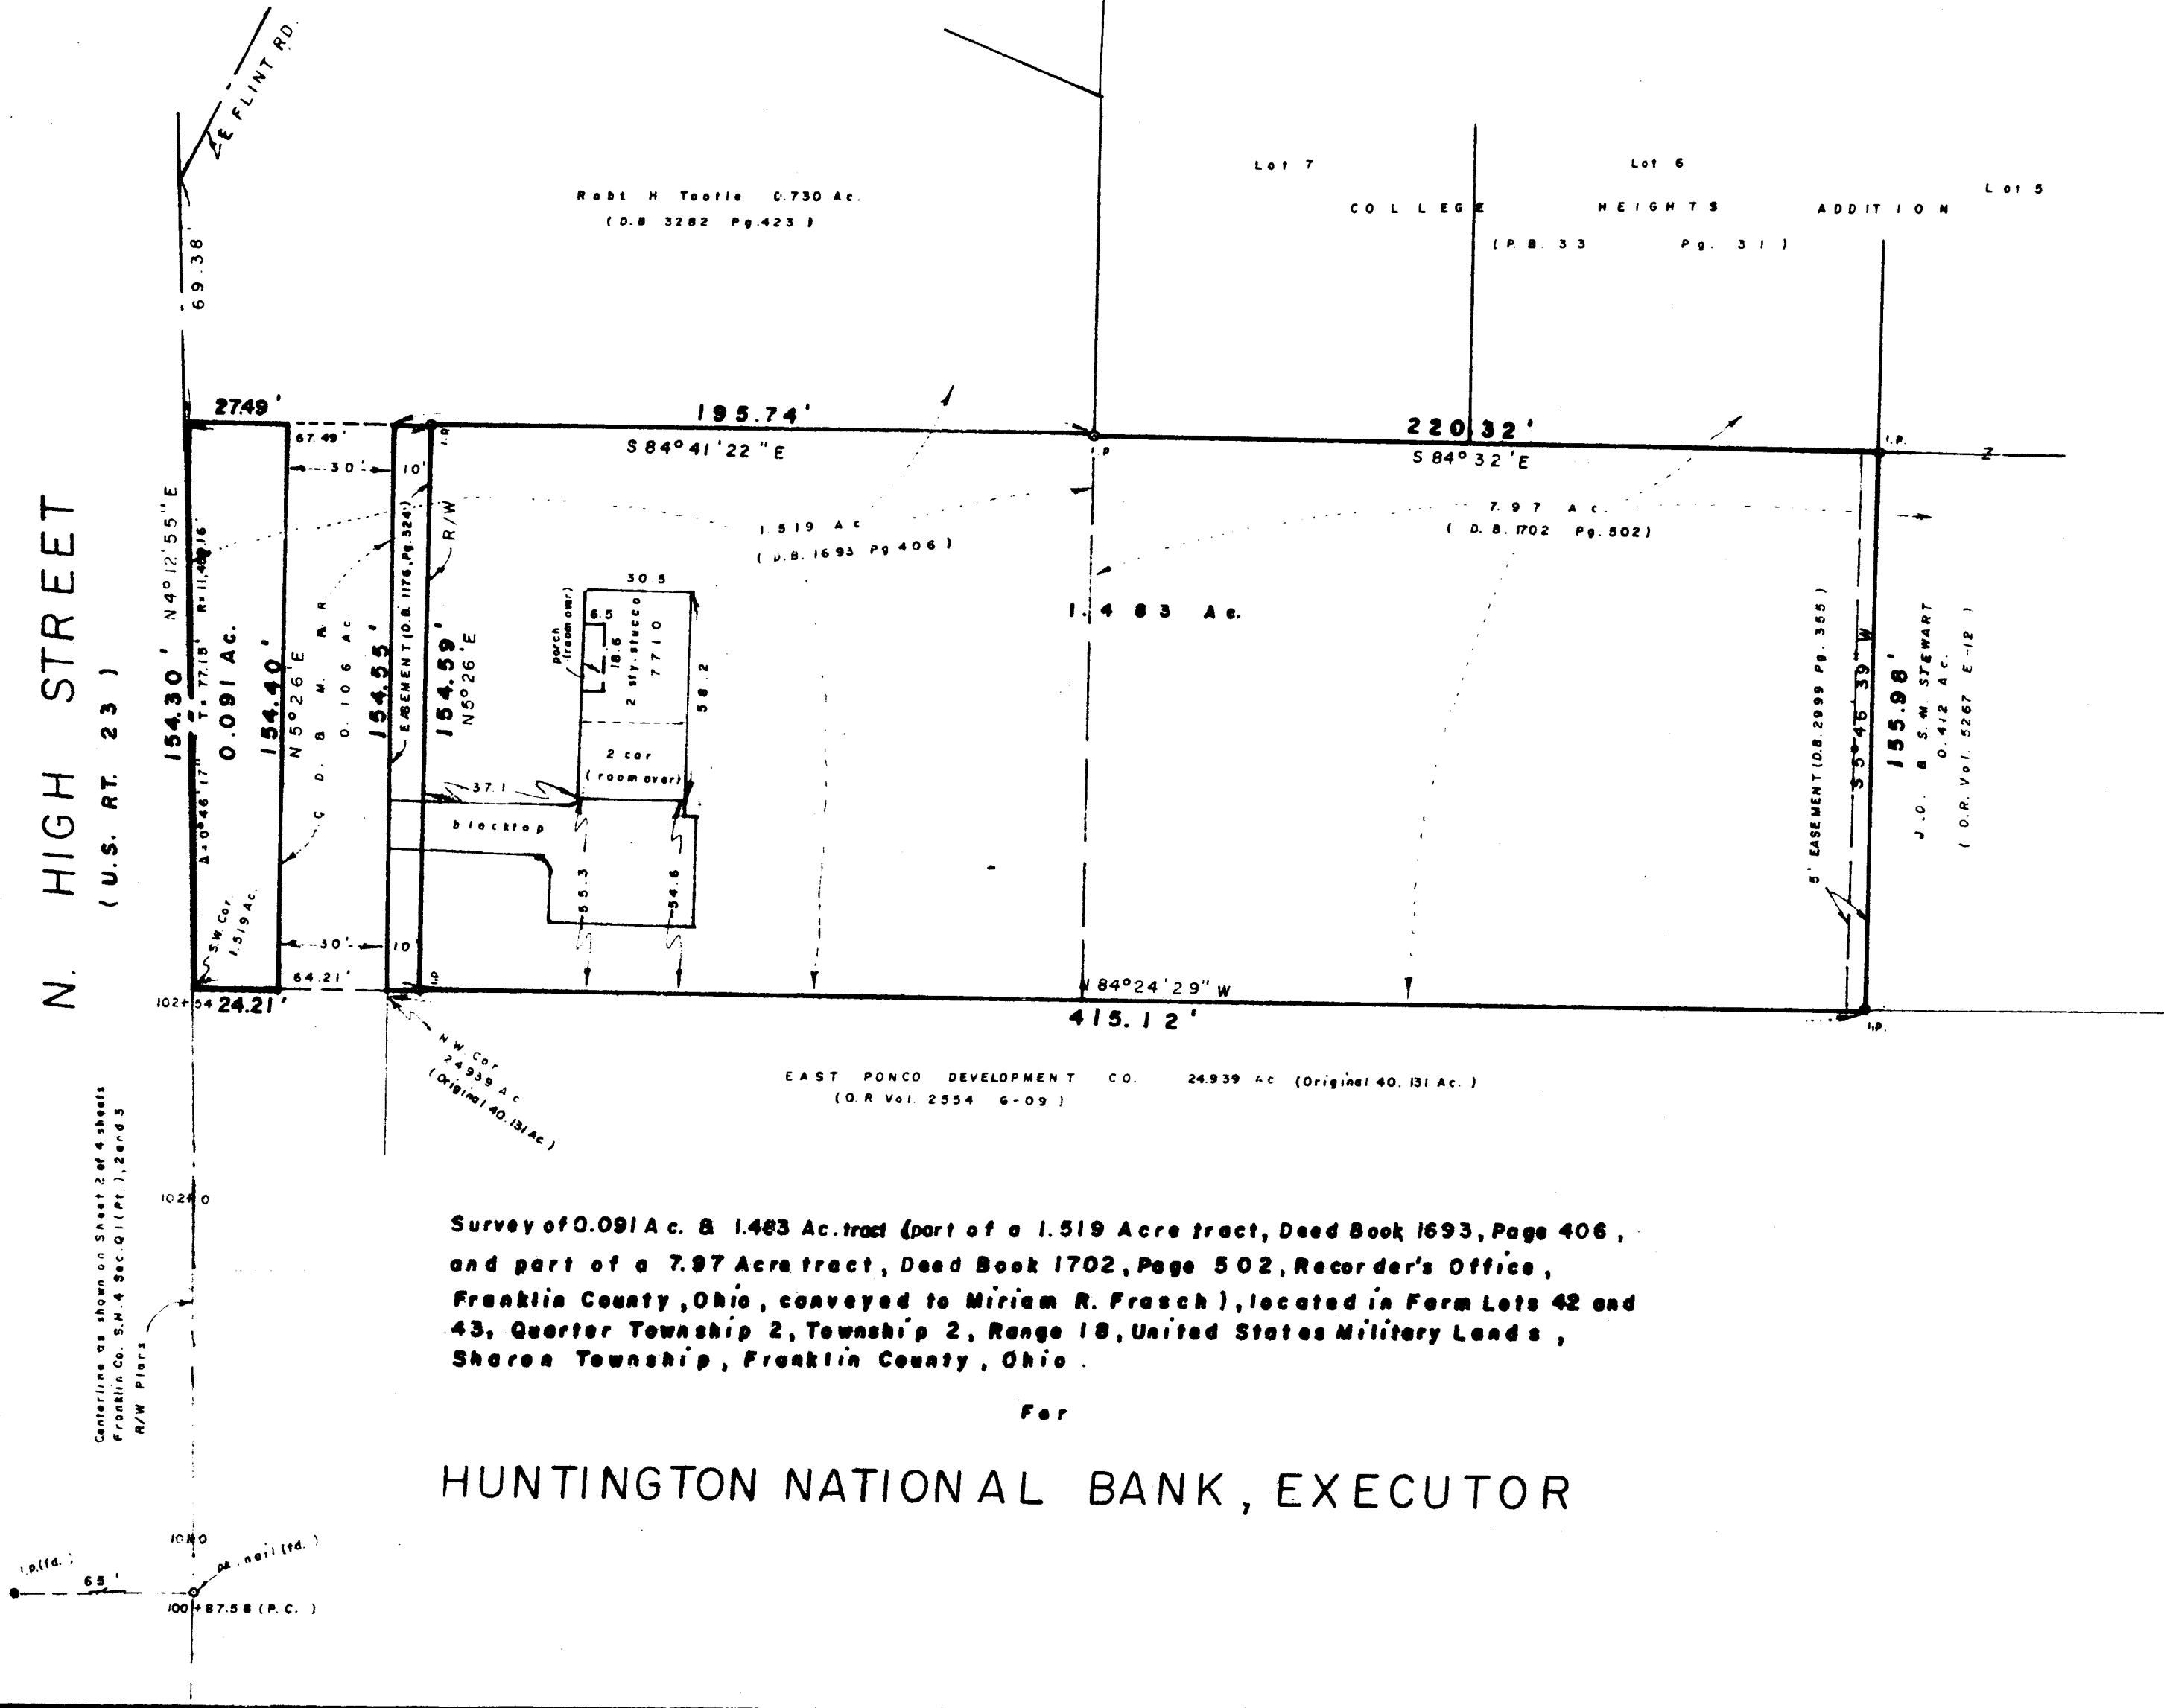

Centerline as shown on Sheet 2 of 4 sheets
Franklin Co. S.M. 4 Sec. Q (Pt.), 2nd 3
R/W Plans